

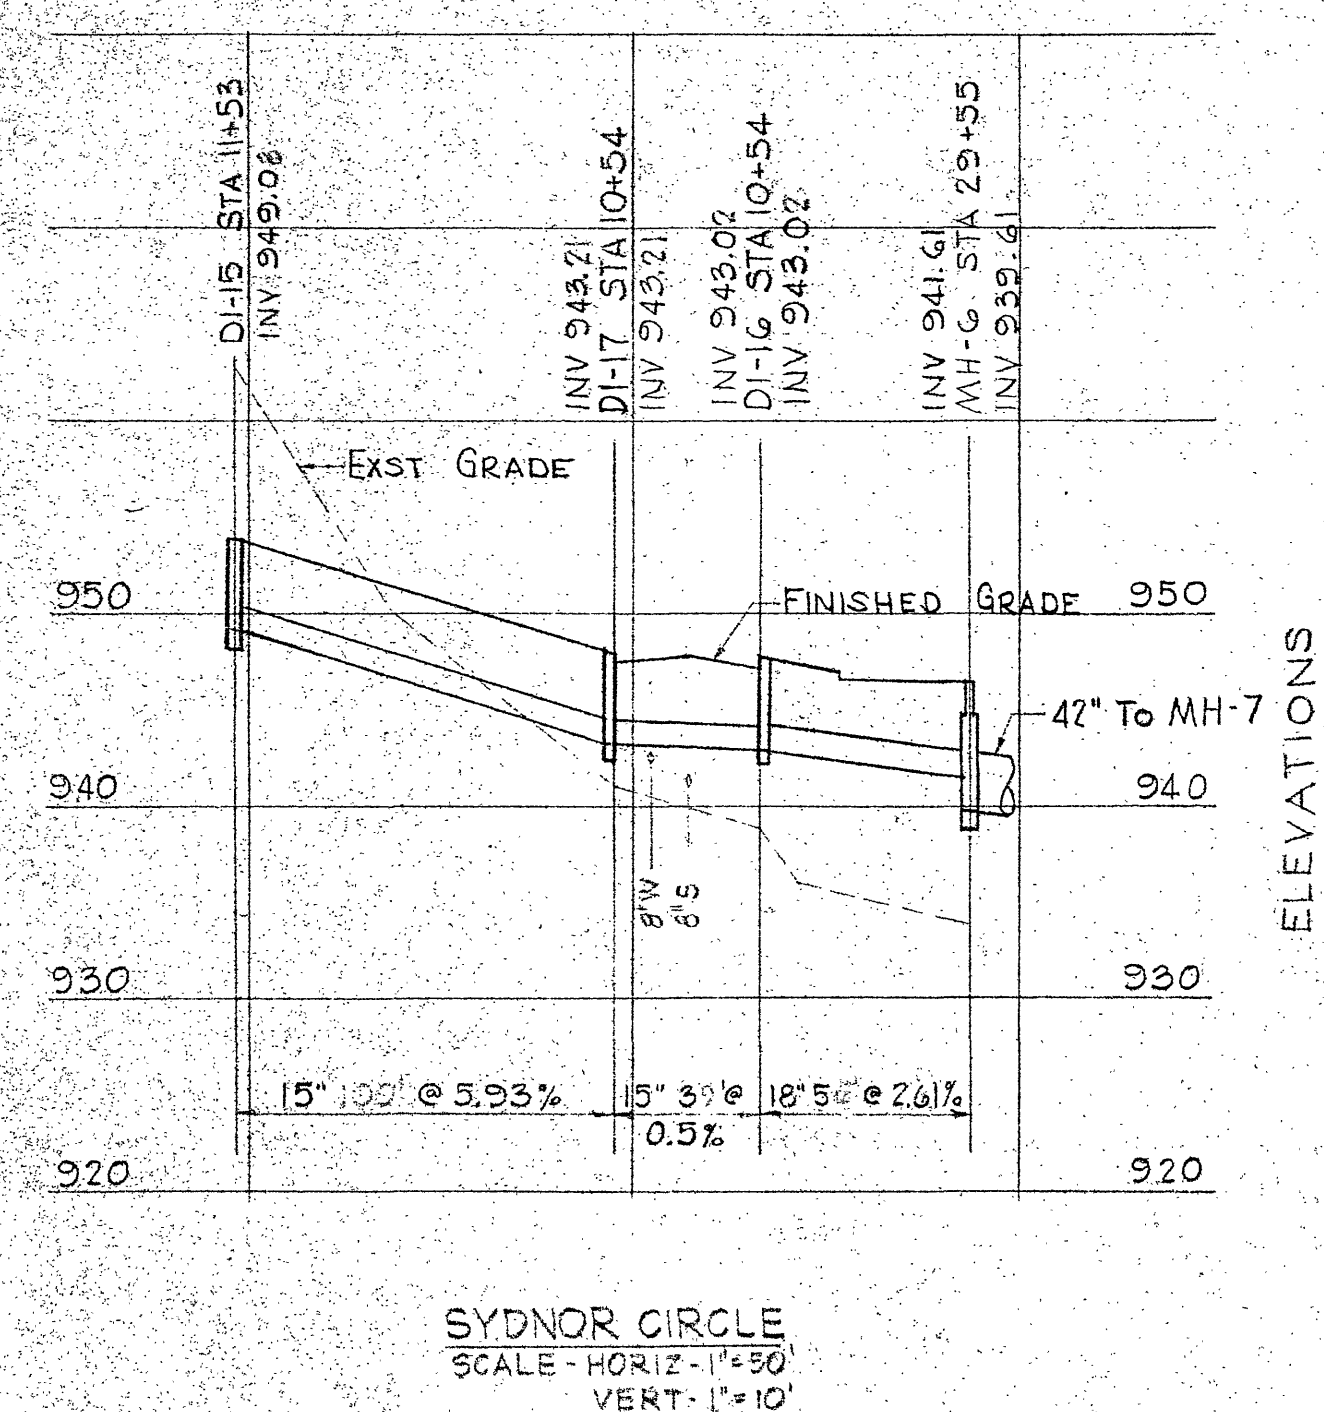
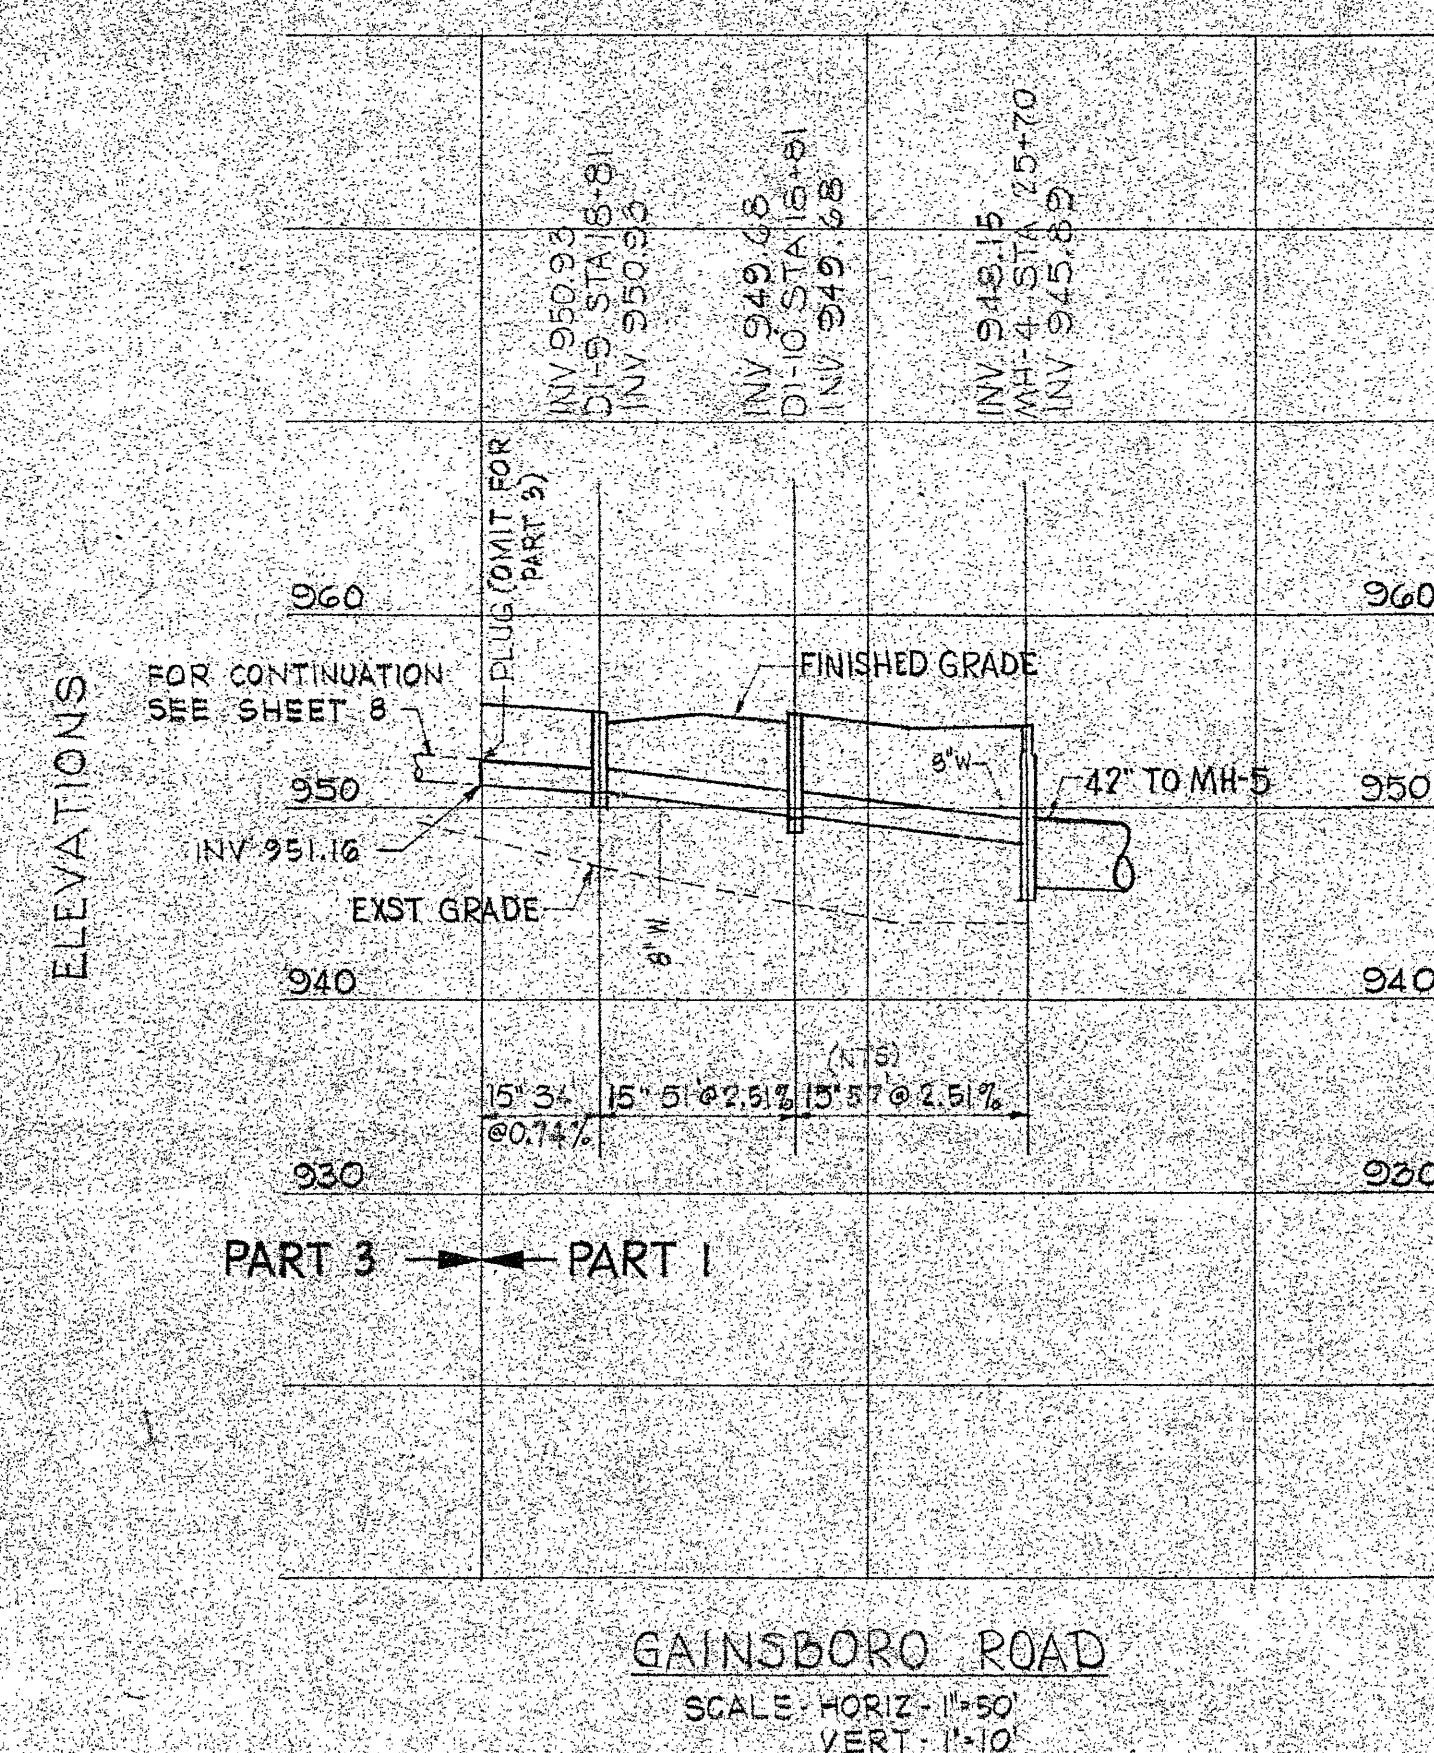
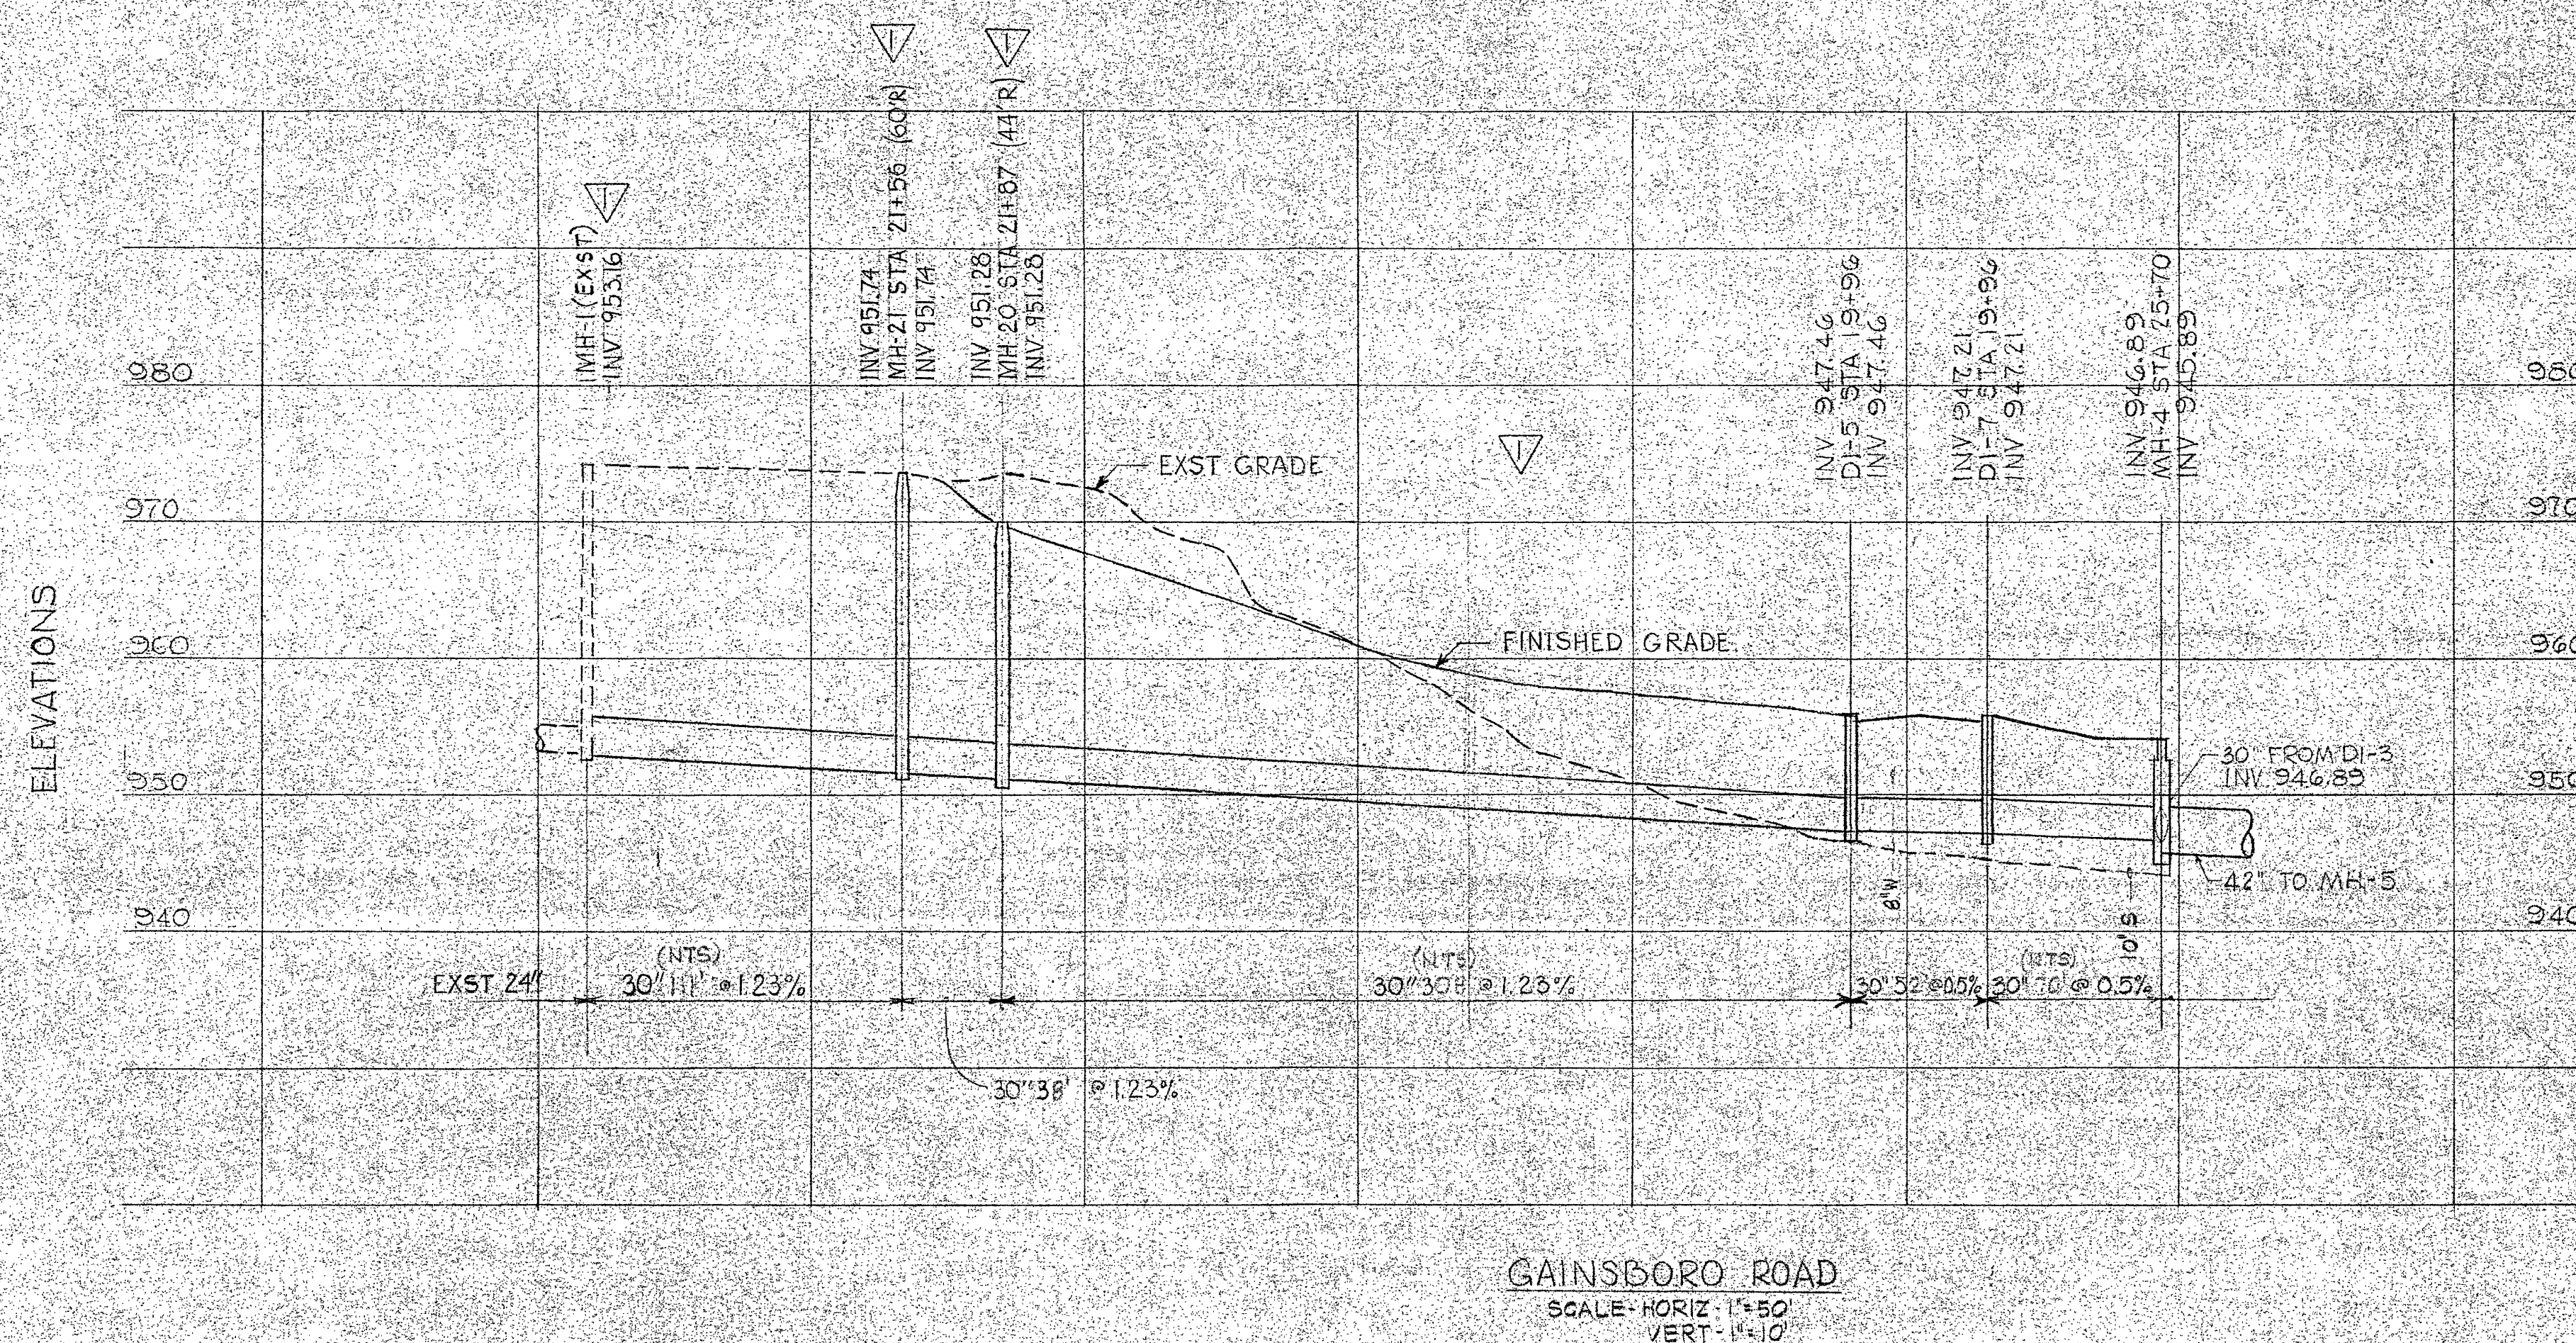


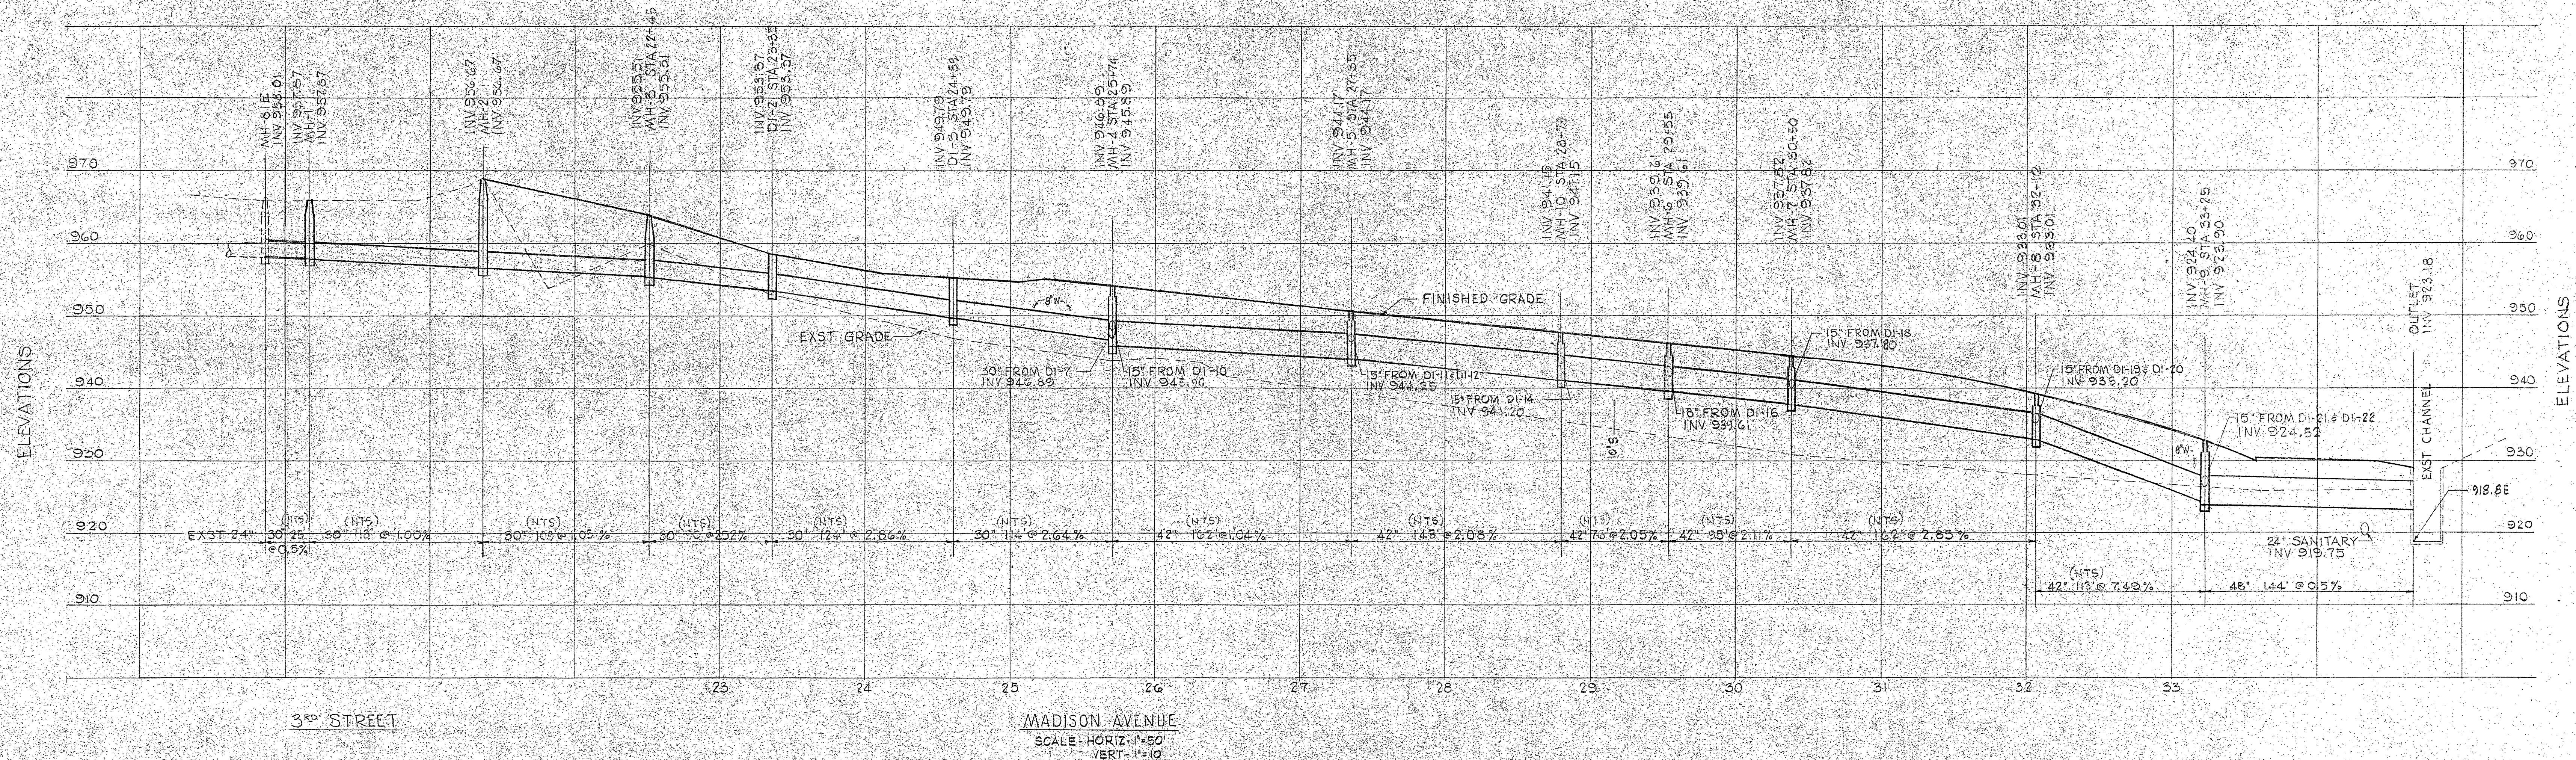

AS BUILT
DRAWING

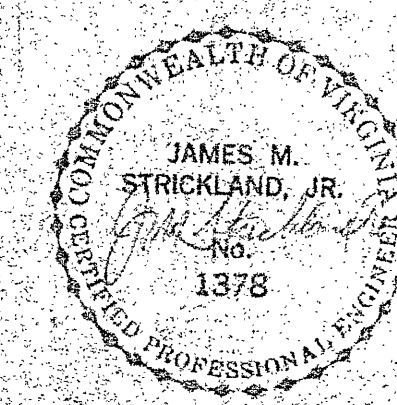

DESIGNED	LWB	DATE	8-1-77	AS BUILT	BY	LWB
DRAWN	LWB	DATE	4/5/78	REV 5D FROM MH-1E TO DI-5	BY	NL
CHECKED	SWH	DATE			BY	SWH
APPROVED	SWH	DATE			BY	SWH
SUBMITTED	SWH	DATE			BY	SWH
ORANGE AVENUE INDUSTRIAL PARK						COMM. NO. 3330
SECTION 4 GAINSBORO NDP - ROANOKE, VIRGINIA						DATE AUG 16, 1976
EDA PROJECT NO. 01-01-01301						SHEET 5
STORM DRAINAGE PROFILES PART 1 & PART 2						
HAYES, SEAY, MATTERN & MATTERN						
ARCHITECTS - ENGINEERS - PLANNERS						
ROANOKE, VIRGINIA						
RICHMOND, VIRGINIA						
VIRGINIA BEACH, VIRGINIA						
WASHINGTON, D.C.						