
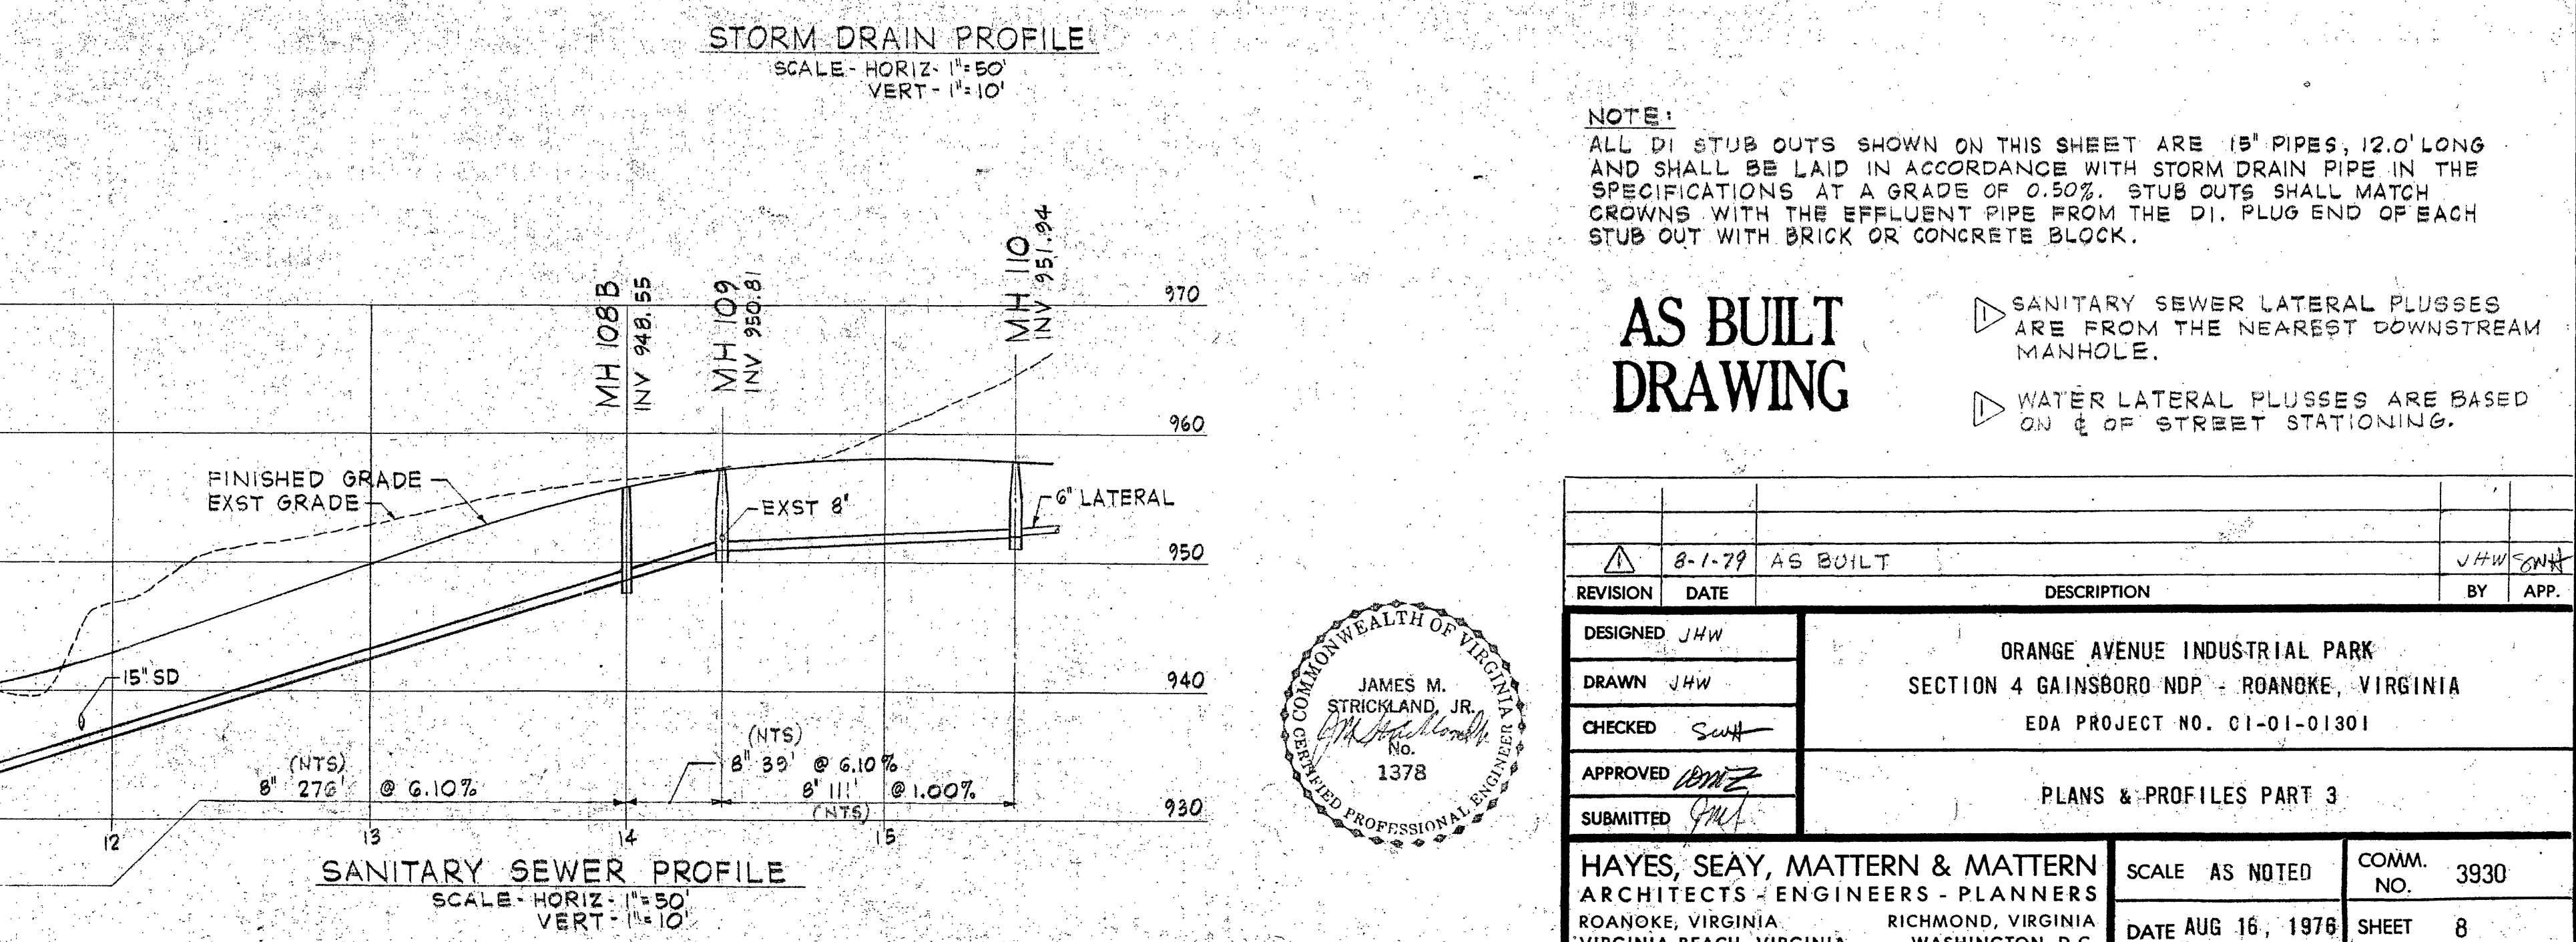
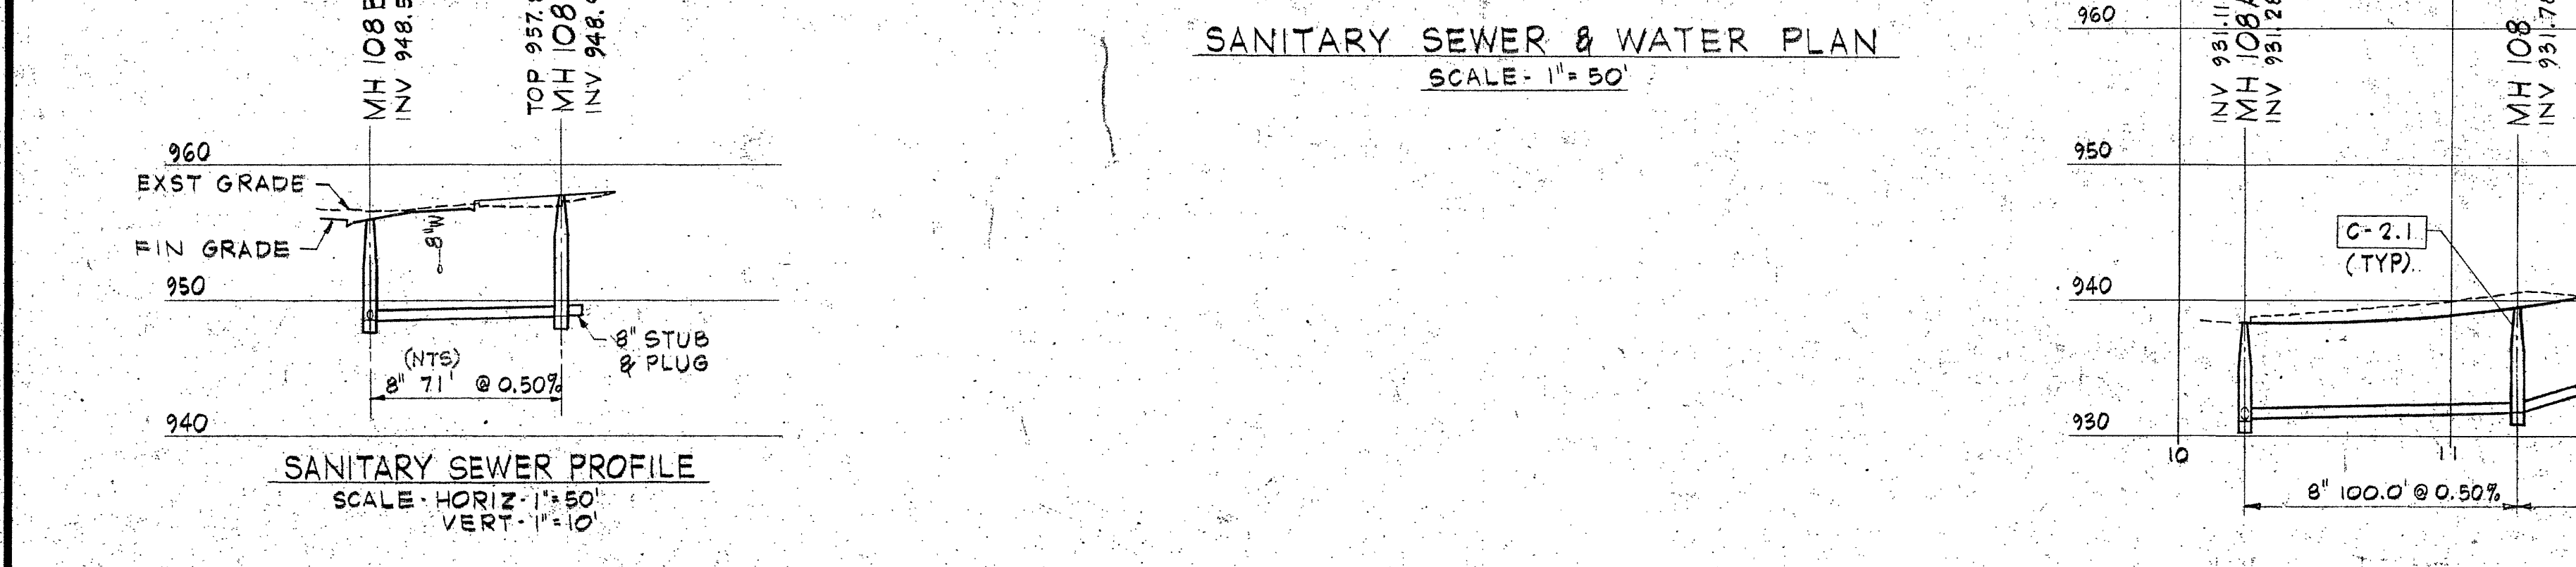
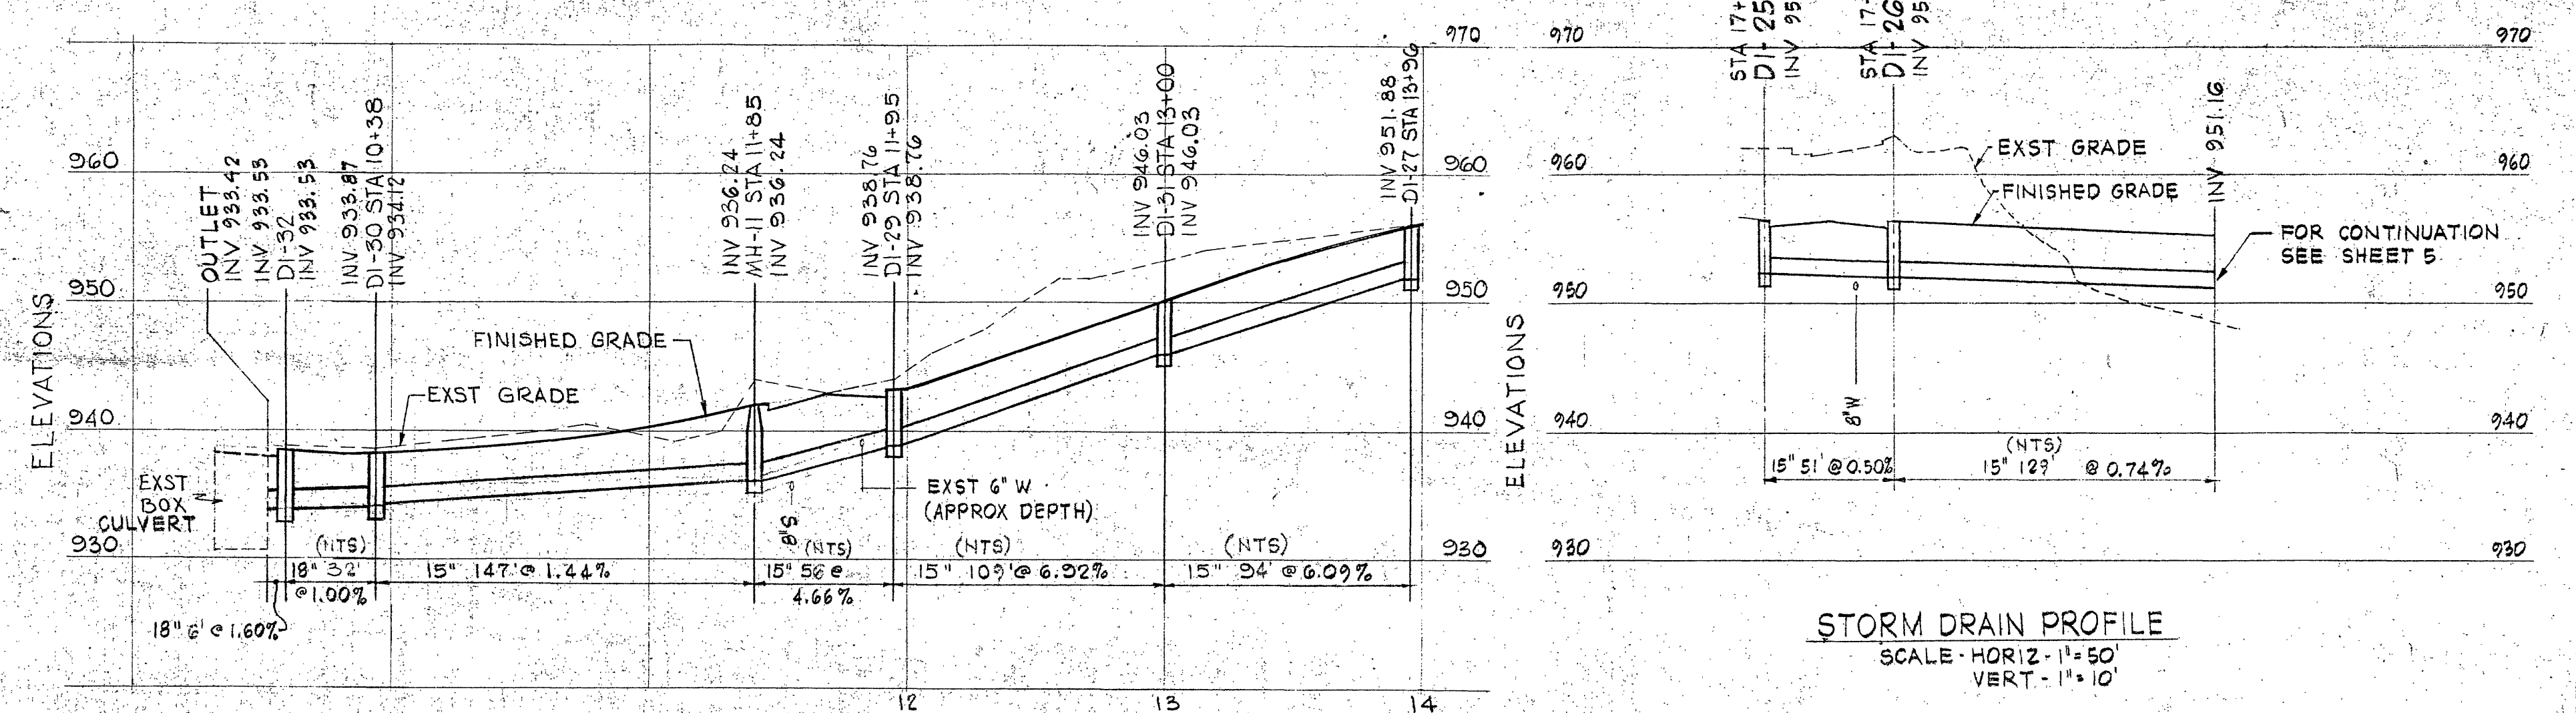
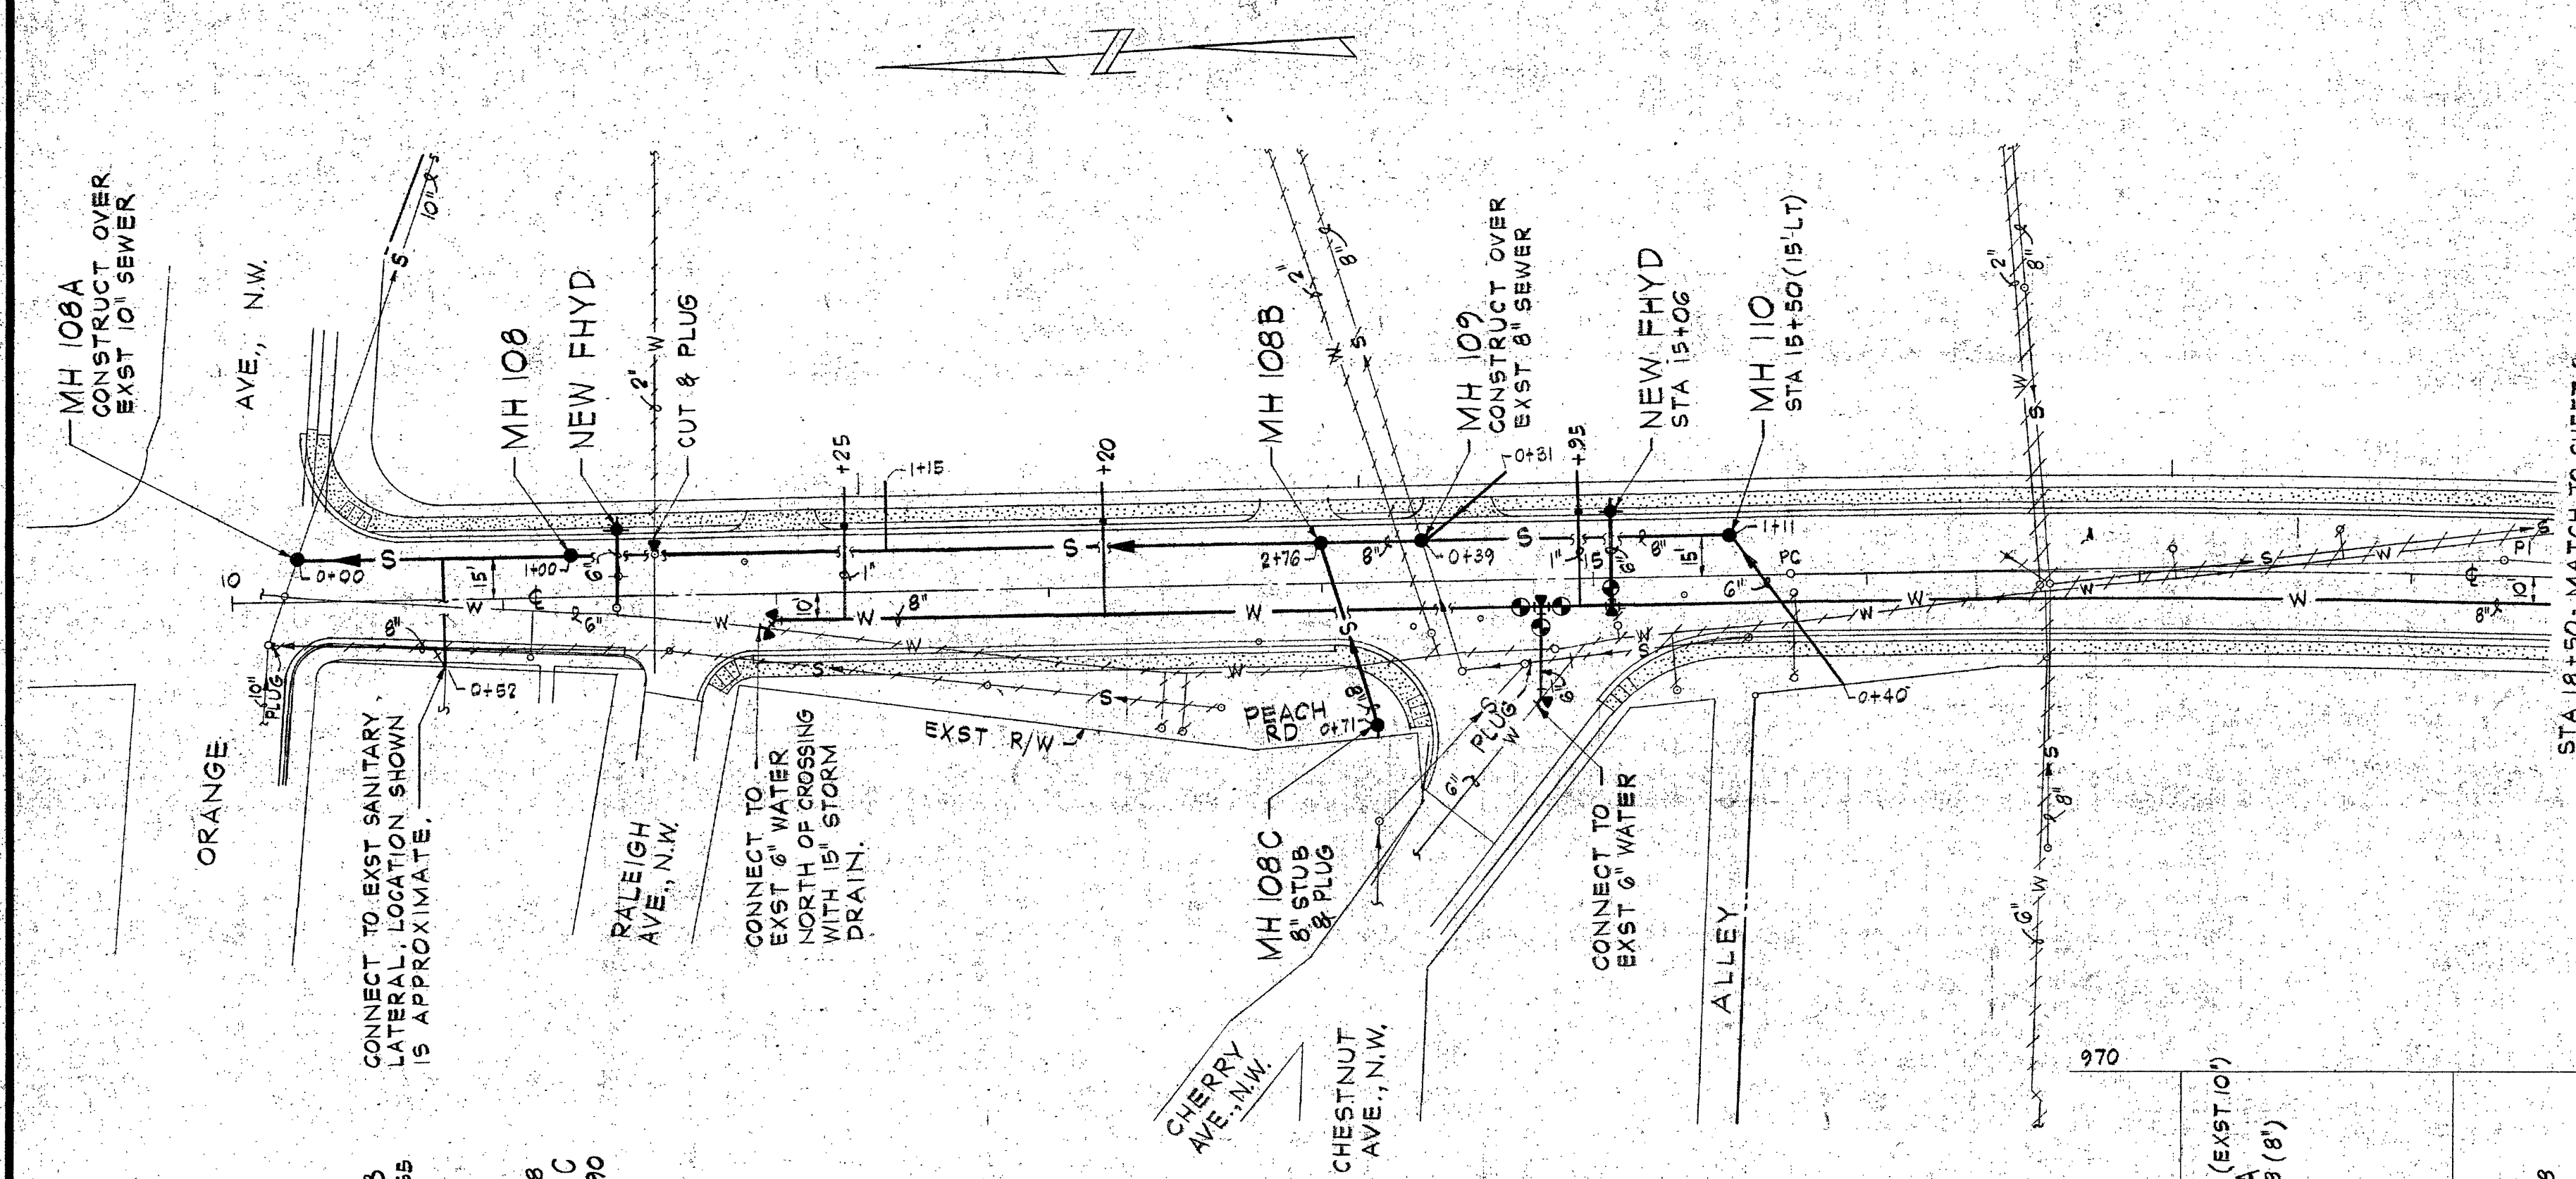
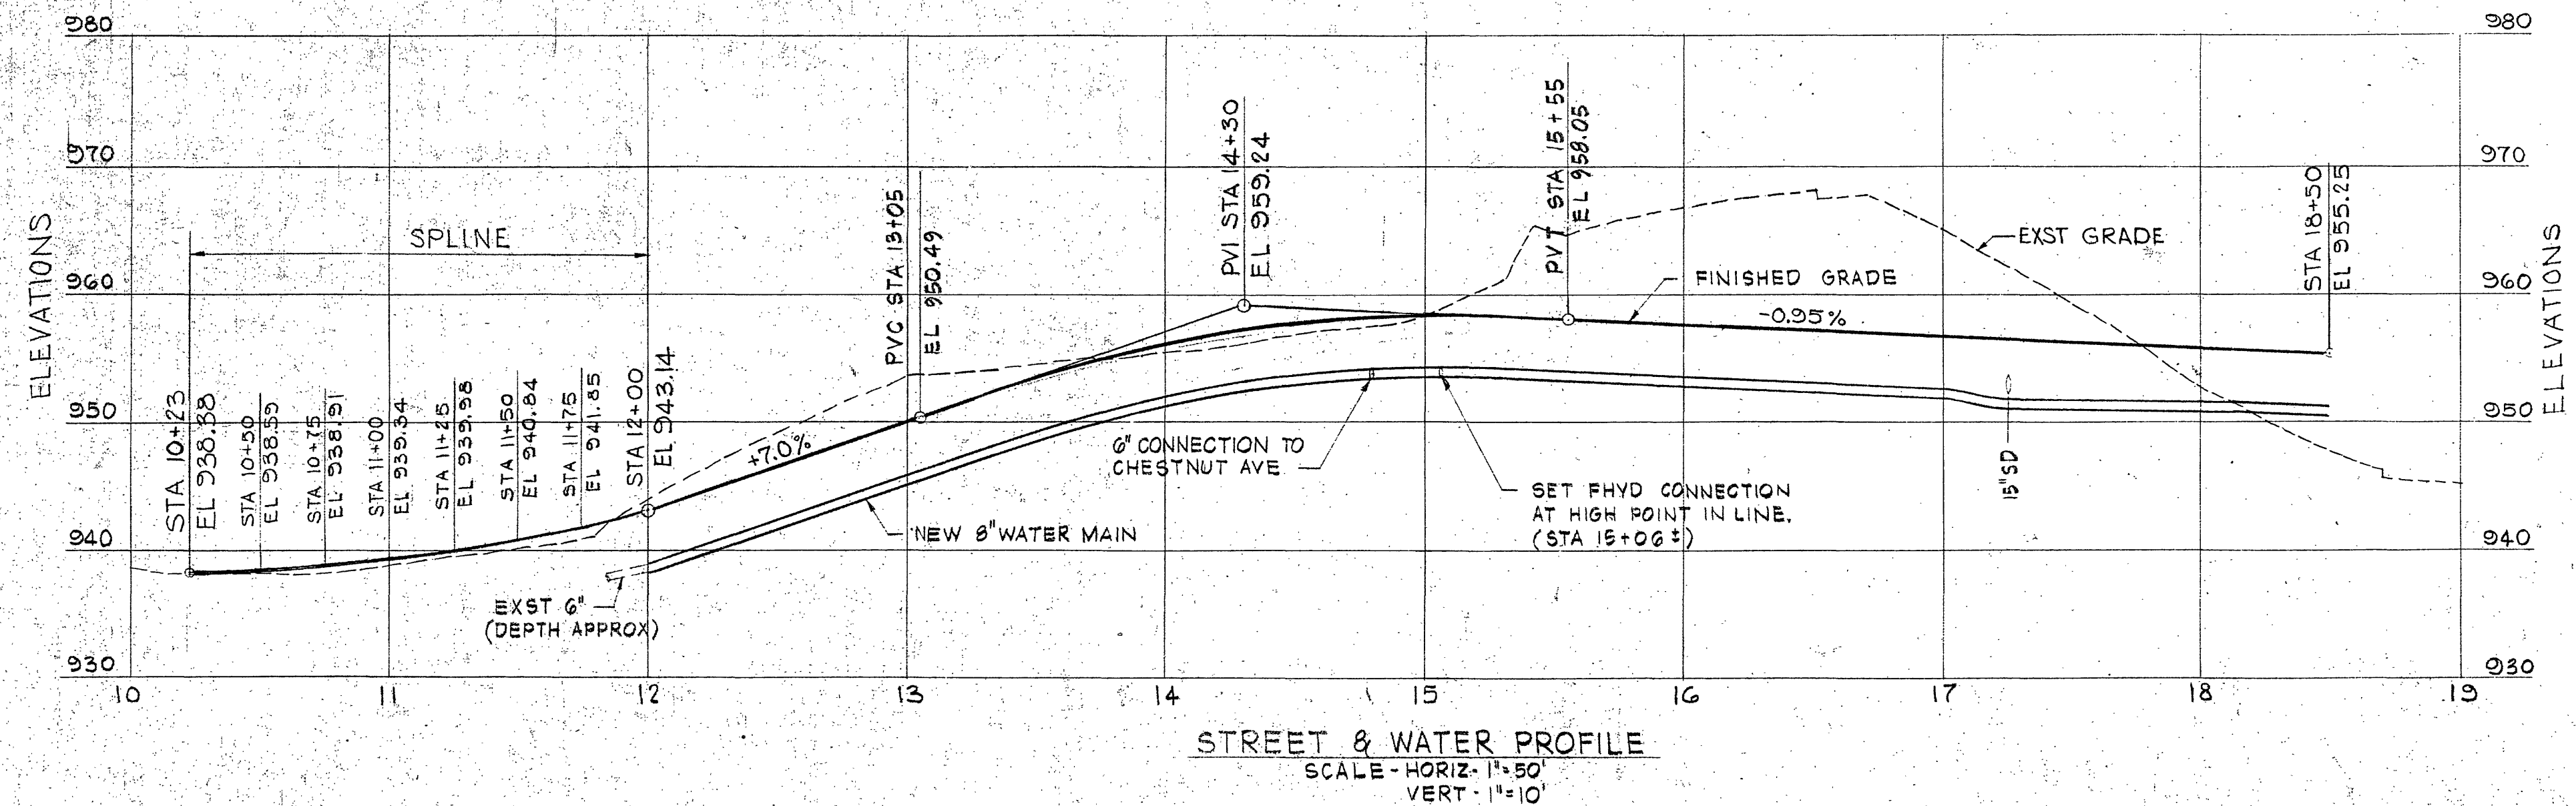
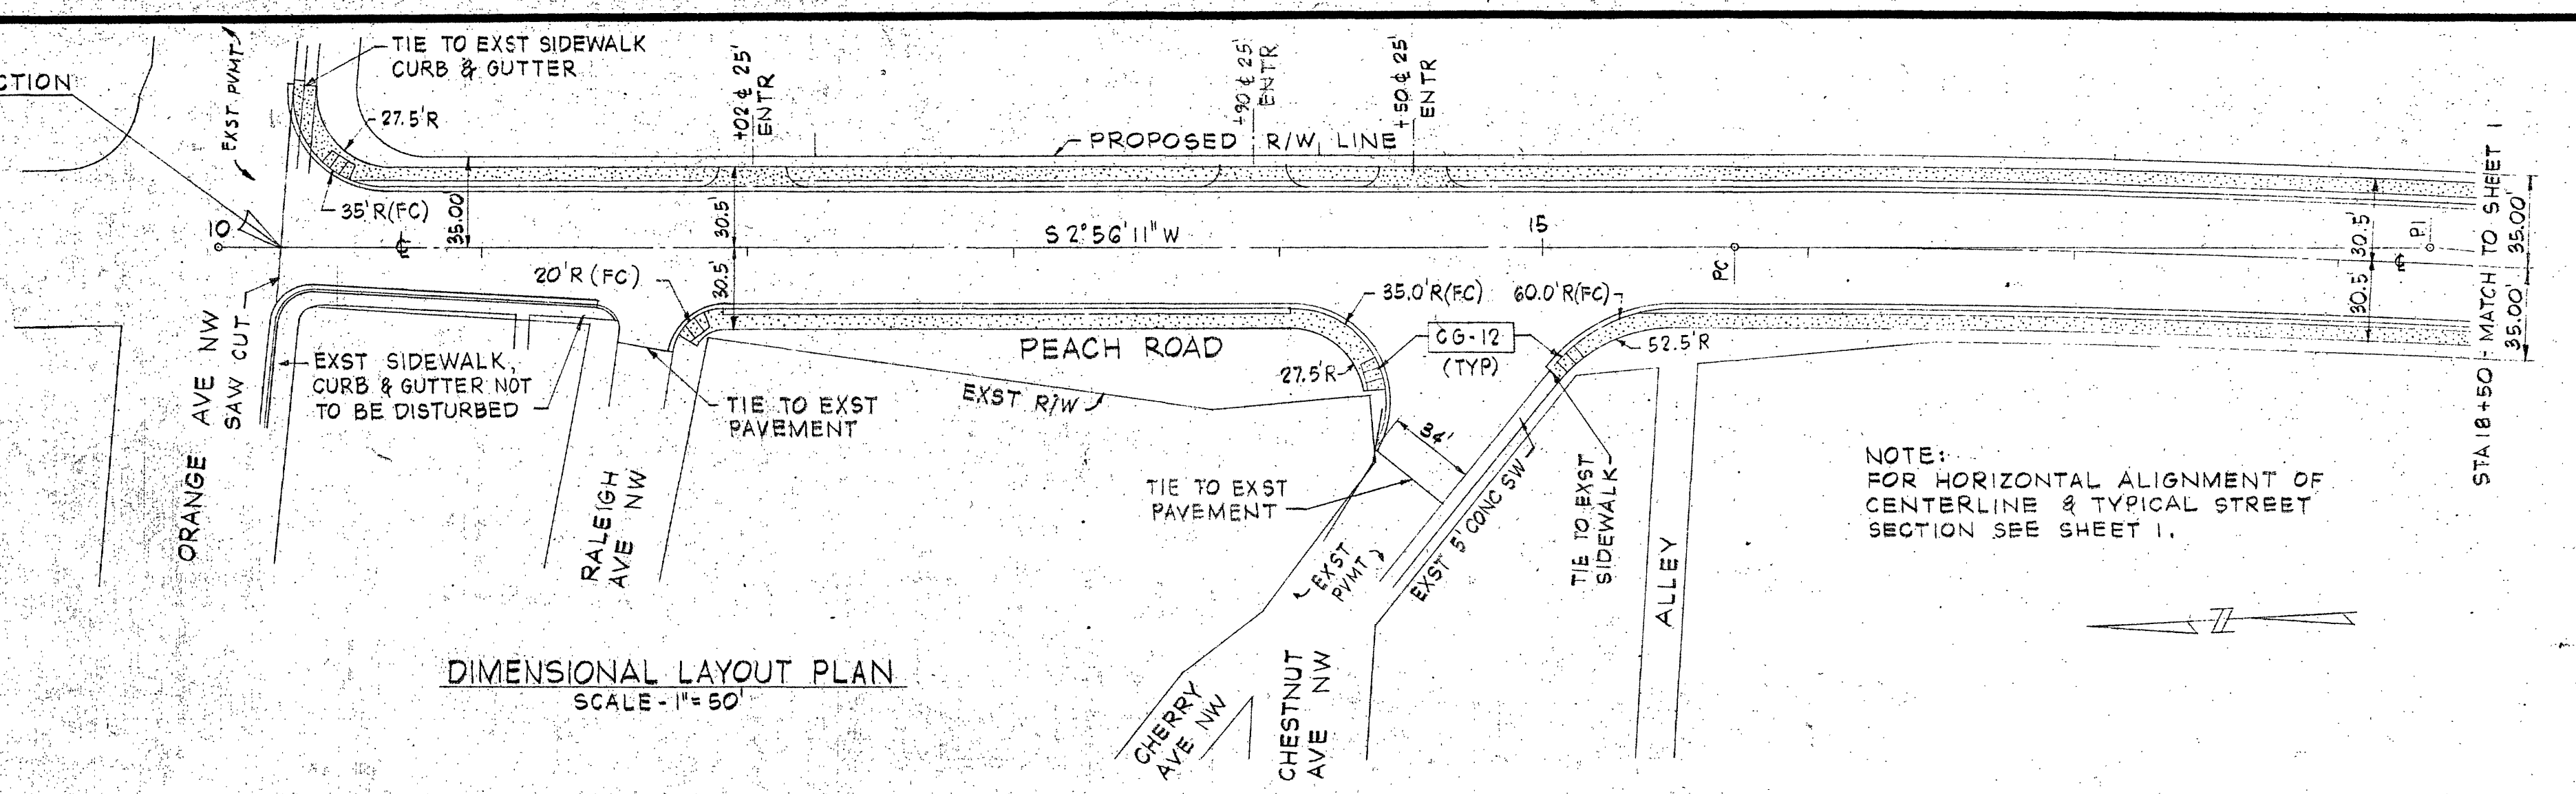


REMOVE EXIST FENCE AS REQD FOR NEW CONSTRUCTION. SEE DETAIL 12.2

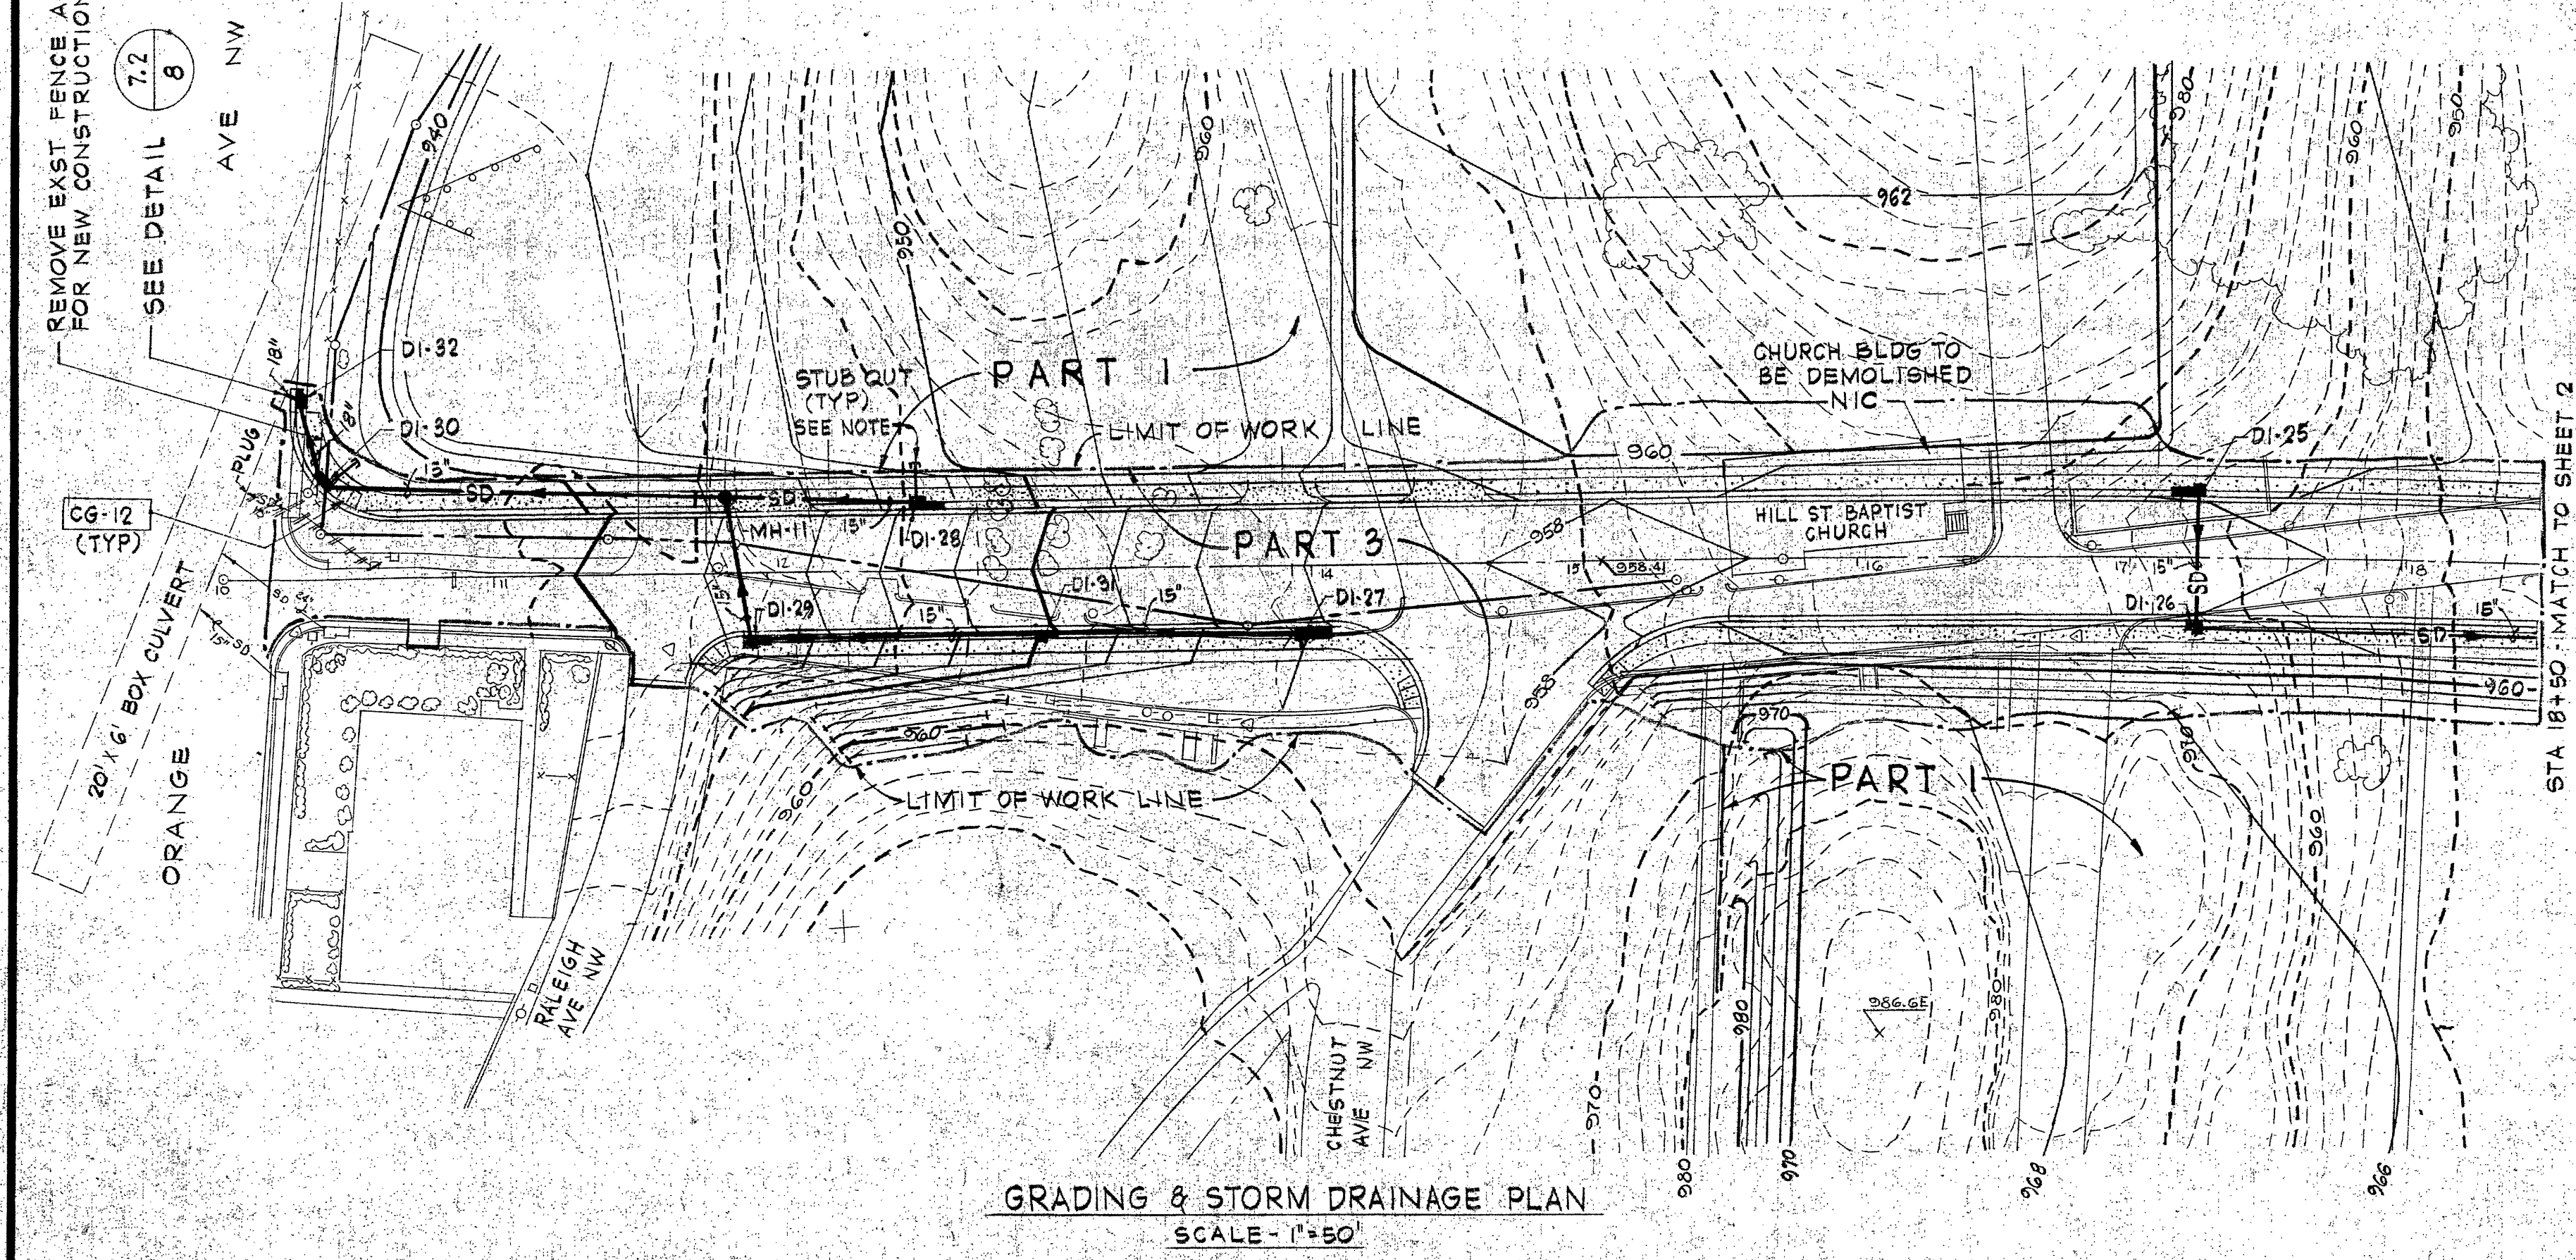


AS BUILT DRAWING

NOTE: ALL DI STUB OUTS SHOWN ON THIS SHEET ARE 15" PIPES, 12.0' LONG AND SHALL BE LAID IN ACCORDANCE WITH STORM DRAIN PIPE IN THE SPECIFICATIONS AT A GRADE OF 0.50%. STUB OUTS SHALL MATCH CROWNS WITH THE EFFLUENT PIPE FROM THE DI. PLUG END OF EACH STUB OUT WITH BRICK OR CONCRETE BLOCK.

NOTE: SANITARY SEWER LATERAL PLUGS ARE FROM THE NEAREST DOWNSTREAM MANHOLE.

NOTE: WATER LATERAL PLUGS ARE BASED ON 4" OF STREET STATIONING.

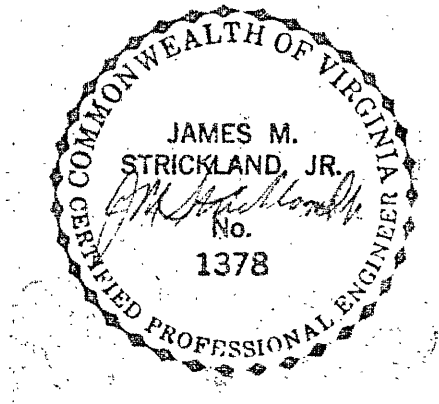

REVISION	DATE	DESCRIPTION	BY	APP.
1	8-1-79	AS BUILT	JHW	JHW
DESIGNED	JHW			
DRAWN	JHW			
CHECKED	Scut			
APPROVED	Scut			
SUBMITTED	Scut			
ORANGE AVENUE INDUSTRIAL PARK SECTION 4 GAINSBORO NDP - ROANOKE, VIRGINIA EDA PROJECT NO. 01-01-01301 PLANS & PROFILES PART 3				
HAYES, SEAY, MATTERN & MATTERN ARCHITECTS - ENGINEERS - PLANNERS ROANOKE, VIRGINIA RICHMOND, VIRGINIA WASHINGTON, D.C.			SCALE AS NOTED DATE AUG. 16, 1978	COMM. NO. 3930 SHEET 8