

NOTES:

1. TEMPORARY STRAW BALE BARRIERS CONFORMING WITH STANDARD DRAWING T.S.B.-1, VIRGINIA SHALL BE INSTALLED AT THE LOCATIONS INDICATED PRIOR TO BEGINNING GRADING OPERATIONS AND SHALL BE MAINTAINED UNTIL TRIBUTARY DRAINAGE AREAS ARE COMPLETELY STABILIZED BY THE ESTABLISHMENT OF PERMANENT GRASS COVER. TEMPORARY STRAW BALE SEDIMENT BARRIERS SHALL BE RELOCATED AS GRADING OPERATIONS PROGRESS SO AS TO CONFORM WITH CHANGES IN ELEVATION AND CONTOURS.


2. EXISTING STORM DRAIN PIPES SHALL BE MAINTAINED IN OPERATING CONDITION UNTIL NEW STORM DRAINS ARE CONSTRUCTED.

3. TEMPORARY CONSTRUCTION EXITS AS DESCRIBED IN THE SPECIFICATIONS SHALL BE PROVIDED AT ALL POINTS WHERE TRAFFIC WILL ENTER OR LEAVE THE LIMITS OF WORK. TEMPORARY CONSTRUCTION EXITS SHALL BE MAINTAINED SO AS TO PREVENT VEHICLES FROM TRANSPORTING MUD ONTO PUBLIC RIGHTS OF WAY OUTSIDE THE LIMITS OF

3. (CONT'D) WORK AND TO PREVENT SEDIMENT FROM ENTERING ANY STORM DRAINAGE SYSTEM.


4. PROVIDE TEMPORARY SEDIMENT TRAPS AT EXISTING INLETS IN ACCORDANCE WITH STANDARD DRAWING TST-2.

TST-2 (TYP) SEE NOTES THIS SHEET.

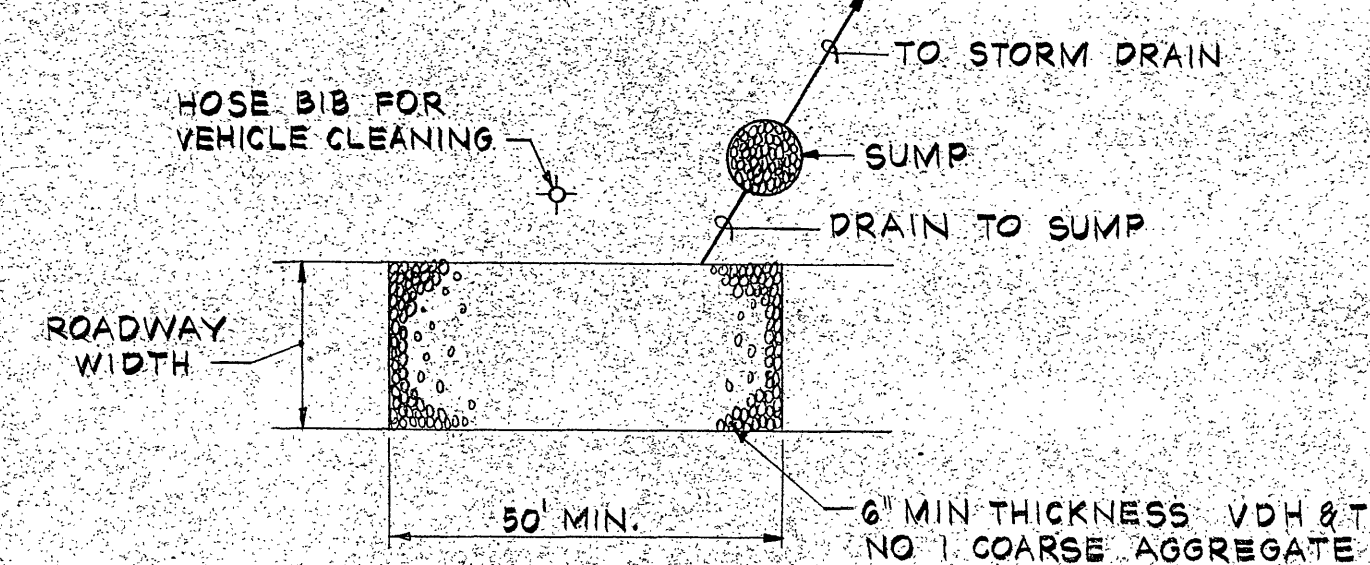

AS BUILT
DRAWING

DESIGNED	WAR	ORANGE AVENUE INDUSTRIAL PARK	SCALE AS NOTED	COMM. NO. 3930
DRAWN	DMC	SECTION 4 GAINSBORO NDP - ROANOKE, VIRGINIA	DATE AUG 16, 1976	SHEET 9
CHECKED	SWT	EDA PROJECT NO. 01-01-01301		
APPROVED	SWT	EROSION & SEDIMENT CONTROL PLAN		
SUBMITTED	SWT	HAYES, SEAY, MATTERN & MATTERN		
		ARCHITECTS - ENGINEERS - PLANNERS		
		ROANOKE, VIRGINIA		
		VIRGINIA BEACH, VIRGINIA		
		RICHMOND, VIRGINIA		
		WASHINGTON, D.C.		

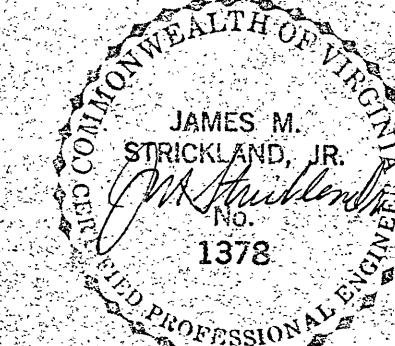

PLAN
SCALE - 1" = 50'