


PROJECT LOCATION MAP

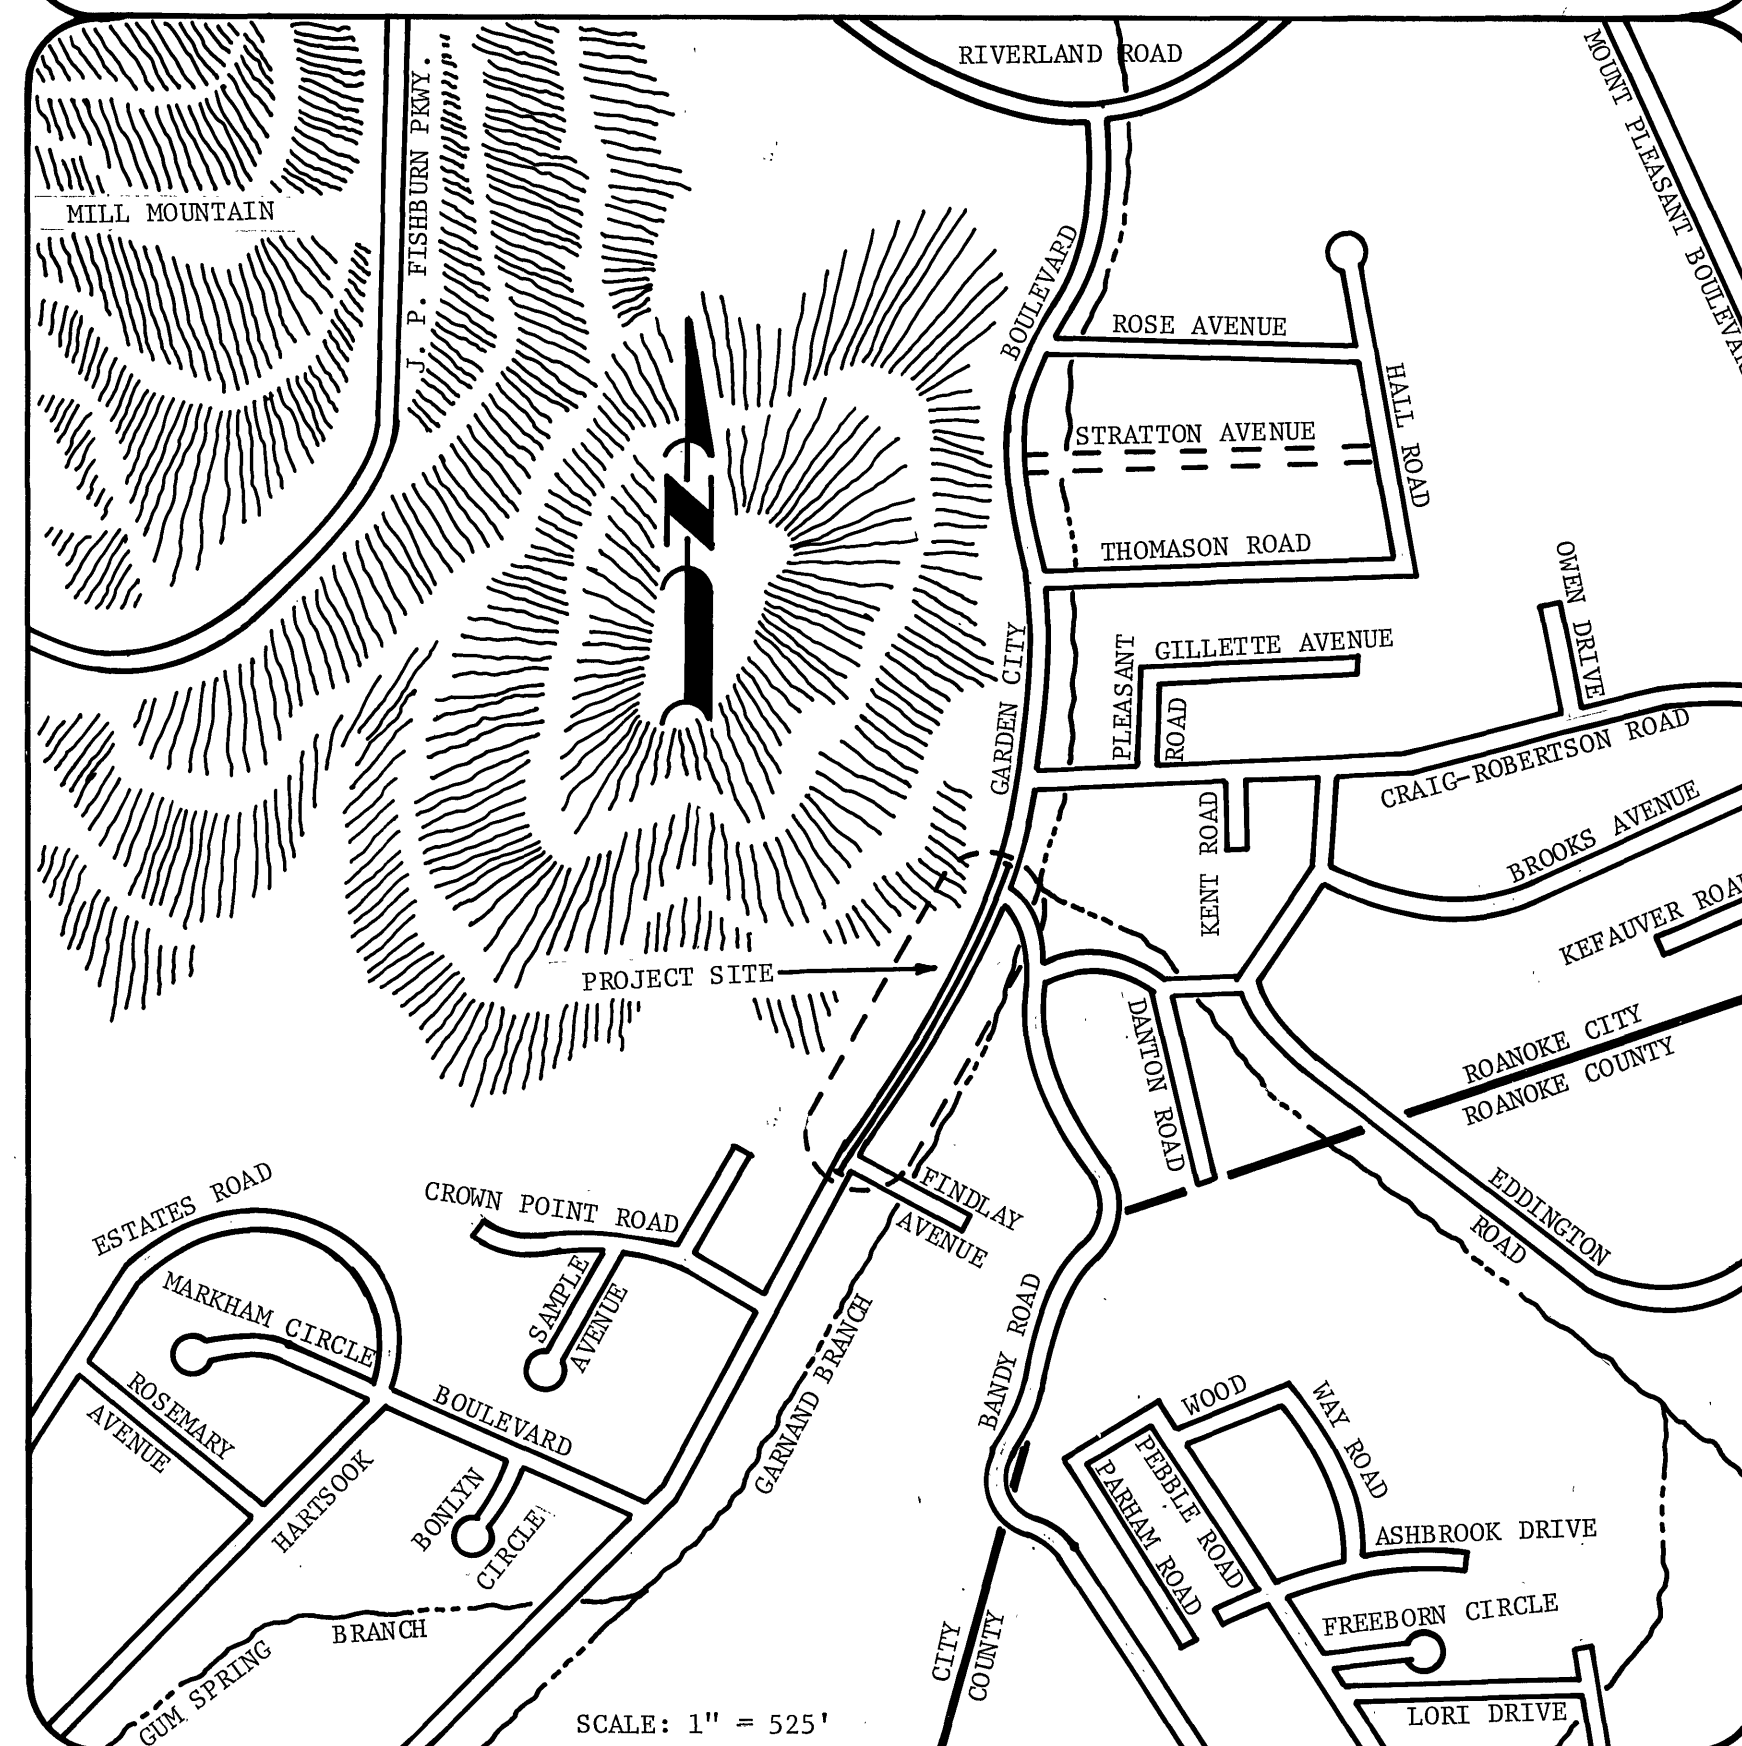

OFFICE OF CITY ENGINEER
ROOM 350
MUNICIPAL BUILDING
215 CHURCH AVENUE, S.W.
ROANOKE, VIRGINIA 24011

INDEX OF SHEETS

SHEET NUMBER	DESCRIPTION
1	COVER SHEET WITH LOCATION MAP
2	ABBREVIATIONS, LEGEND & QUANTITIES
3	PLAN & PROFILE, STA. 10-00 to STA. 15-00
4	PLAN & PROFILE, STA. 15-00 to STA. 19-70, DROP MANHOLE DETAIL

CONSULTING ENGINEERS

Plans Prepared By :

T. P. PARKER & SON

ENGINEERS & SURVEYORS, LTD.

816 BOULEVARD

SALEM, VIRGINIA 24153

COMMISSION NUMBER: _____

PROJECT NAME

**GARDEN CITY BOULEVARD
SANITARY SEWER REPLACEMENT
PHASE II**

BANDY ROAD to FINDLAY AVENUE

PROJECT NUMBER: **5488**

REVISION	BY	DESCRIPTION:	DATE
REVISION	BY	DESCRIPTION:	DATE
REVISION	BY	DESCRIPTION:	DATE
REVISION	BY	DESCRIPTION:	DATE

APPROVED FOR CONSTRUCTION

Richard B. Bunn
ROANOKE CITY ENGINEER
23 April '82
DATE

Thomas J. Brady
DIRECTOR OF PUBLIC WORKS
4-23-82
DATE

Pat B. Lisen
DIRECTOR OF UTILITIES AND OPERATIONS
23 April, 82
DATE

DATE

DATE

ADVERTISED DATE : **APRIL 25, 1982**

SET NUMBER: _____

SHEET NUMBER: **1** OF **4**

AS BUILT