
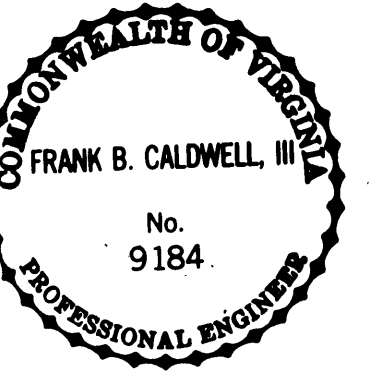


PLAN	DATE	BY	DATE
SURVEYED		R. MEADOR	
NOTED		J. BURROWS	
ALIGNED		E. JOYNER	
CHECKED			
TRACED			

PROFILE	DATE	BY	DATE
SURVEYED		E. JOYNER	
NOTED			
GRADES			
CHECKED			
STRUCTURE			

NOTES:
1. THE LOCATION OF UNDERGROUND UTILITIES IS BASED ON FIELD SURVEYS AND AS LOCATED ON THE SITE BY THE UTILITY LOCATOR SERVICE. THE LOCATION OF SEWER LATERALS AND WATER SERVICE LINES IS BASED ON AVAILABLE CITY OF ROANOKE RECORDS. THE CONTRACTOR SHALL VERIFY ALL UTILITIES AS REQUIRED.

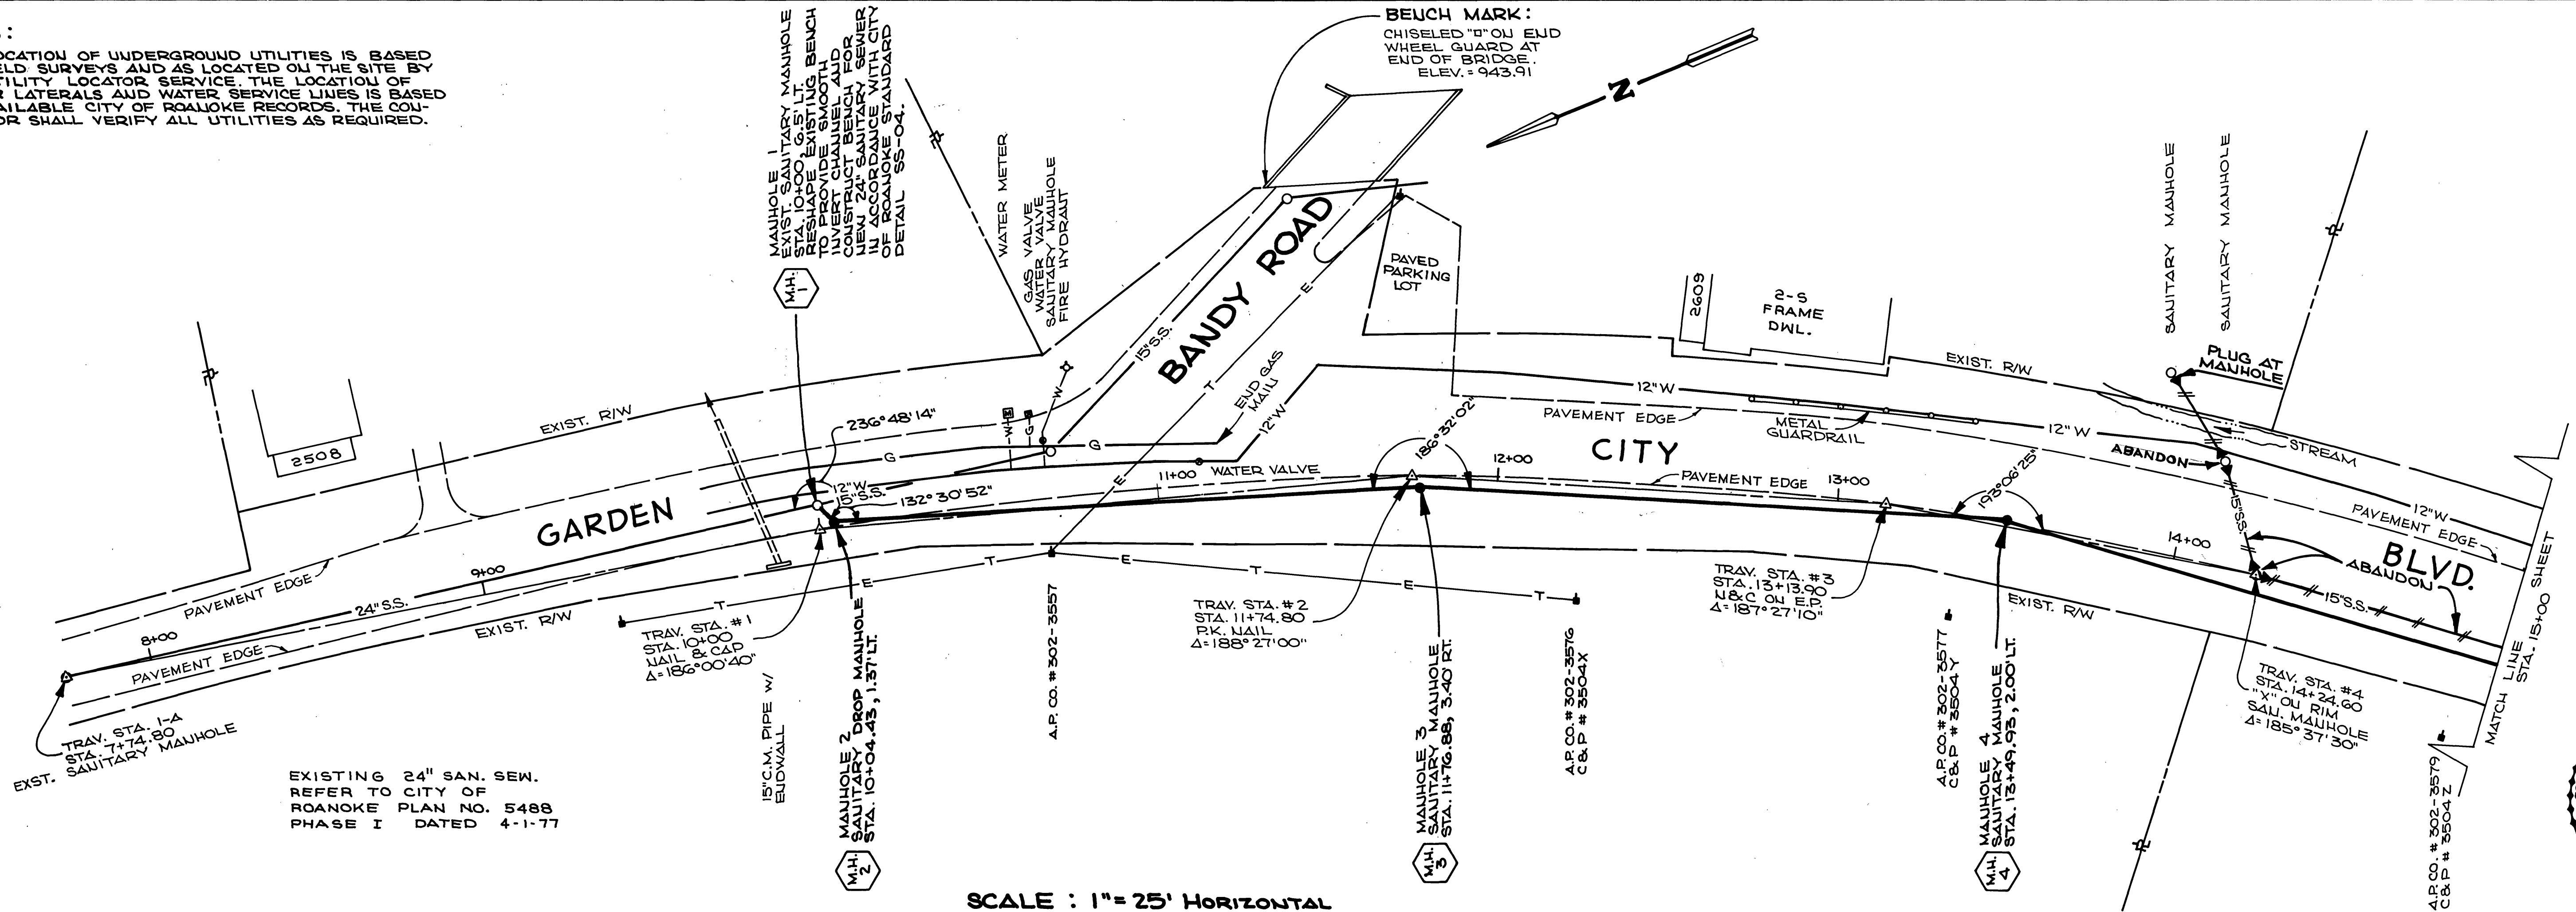


SCALE: 1" = 25' HORIZONTAL

BENCH MARK:

CHISELED "B" AT END OF WHEEL GUARD AT N.W. END OF BRIDGE AT BANDY ROAD. ELEV. = 943.91

1" = 5' VERTICAL

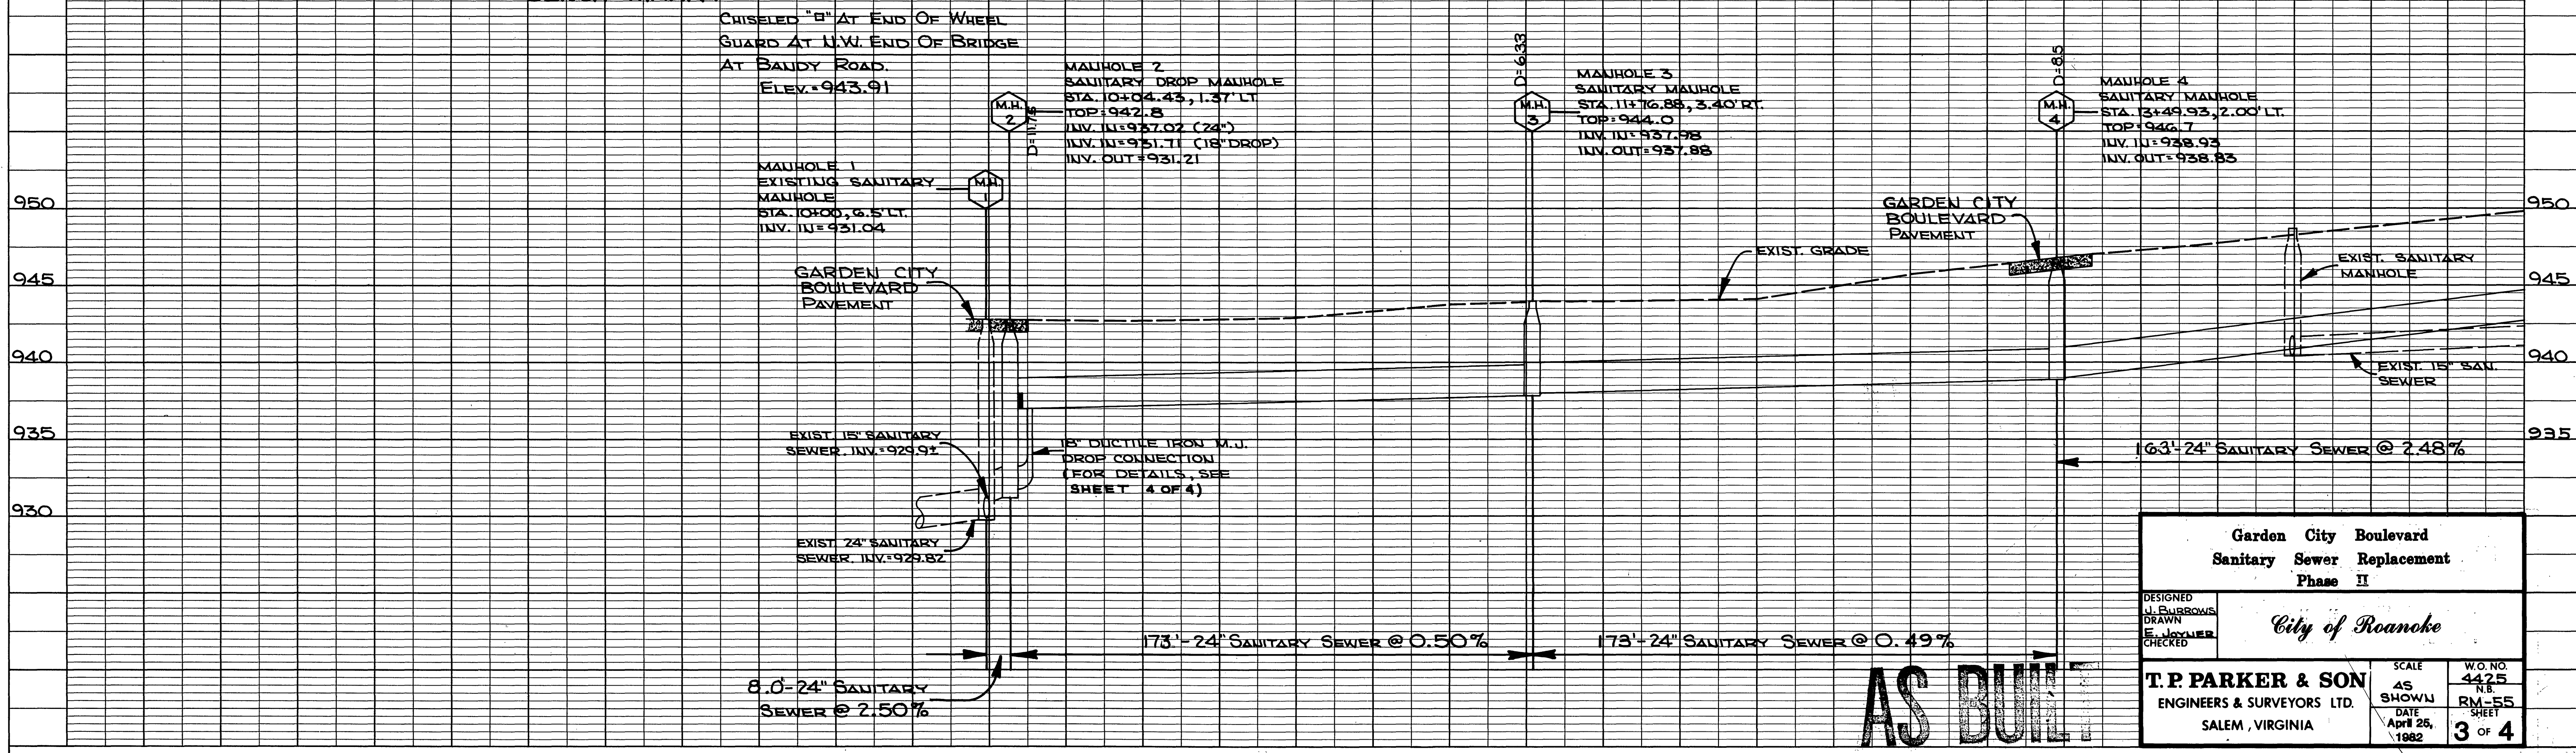

Garden City Boulevard Sanitary Sewer Replacement Phase II			
DESIGNED J. BURROWS	City of Roanoke		
DRAWN E. JOYNER	T.P. PARKER & SON ENGINEERS & SURVEYORS LTD. SALEM, VIRGINIA		
CHECKED	SCALE AS SHOWN	DATE April 25, 1982	W.O. NO. 4425 RM-55 SHEET 3 OF 4

AS BUILT