
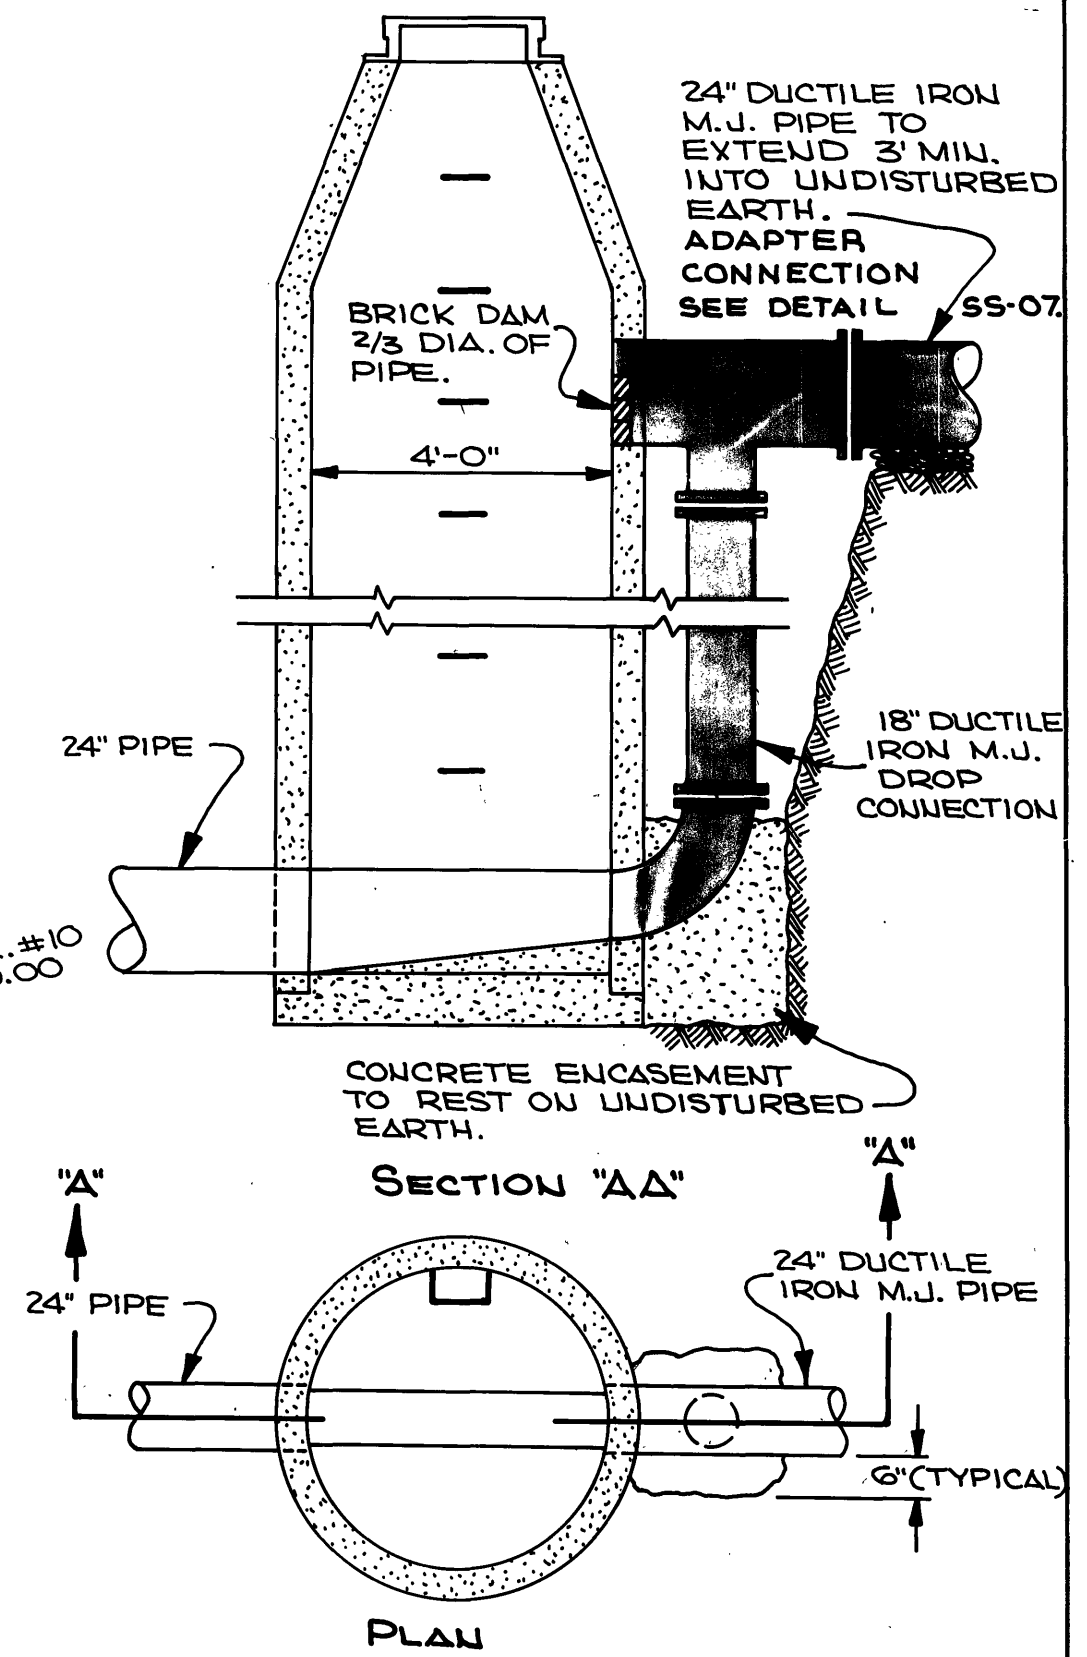



PLAN	BY	DATE
SURVEYED	R. MEADOR	1-82
NOTE BOOK	U. BURROWS	1-82
ALIGNED CHECKED		
RT. OF WAY CHECKED		
TRACED	E. JOYNER	1-82
NO.		

PROFILE	BY	DATE
SURVEYED	E. JOYNER	2-82
NOTE BOOK		
CONDS. CHECKED		
B. M. NOTED		
STRUCTURE NOTATIONS CHK'D		
NO.		

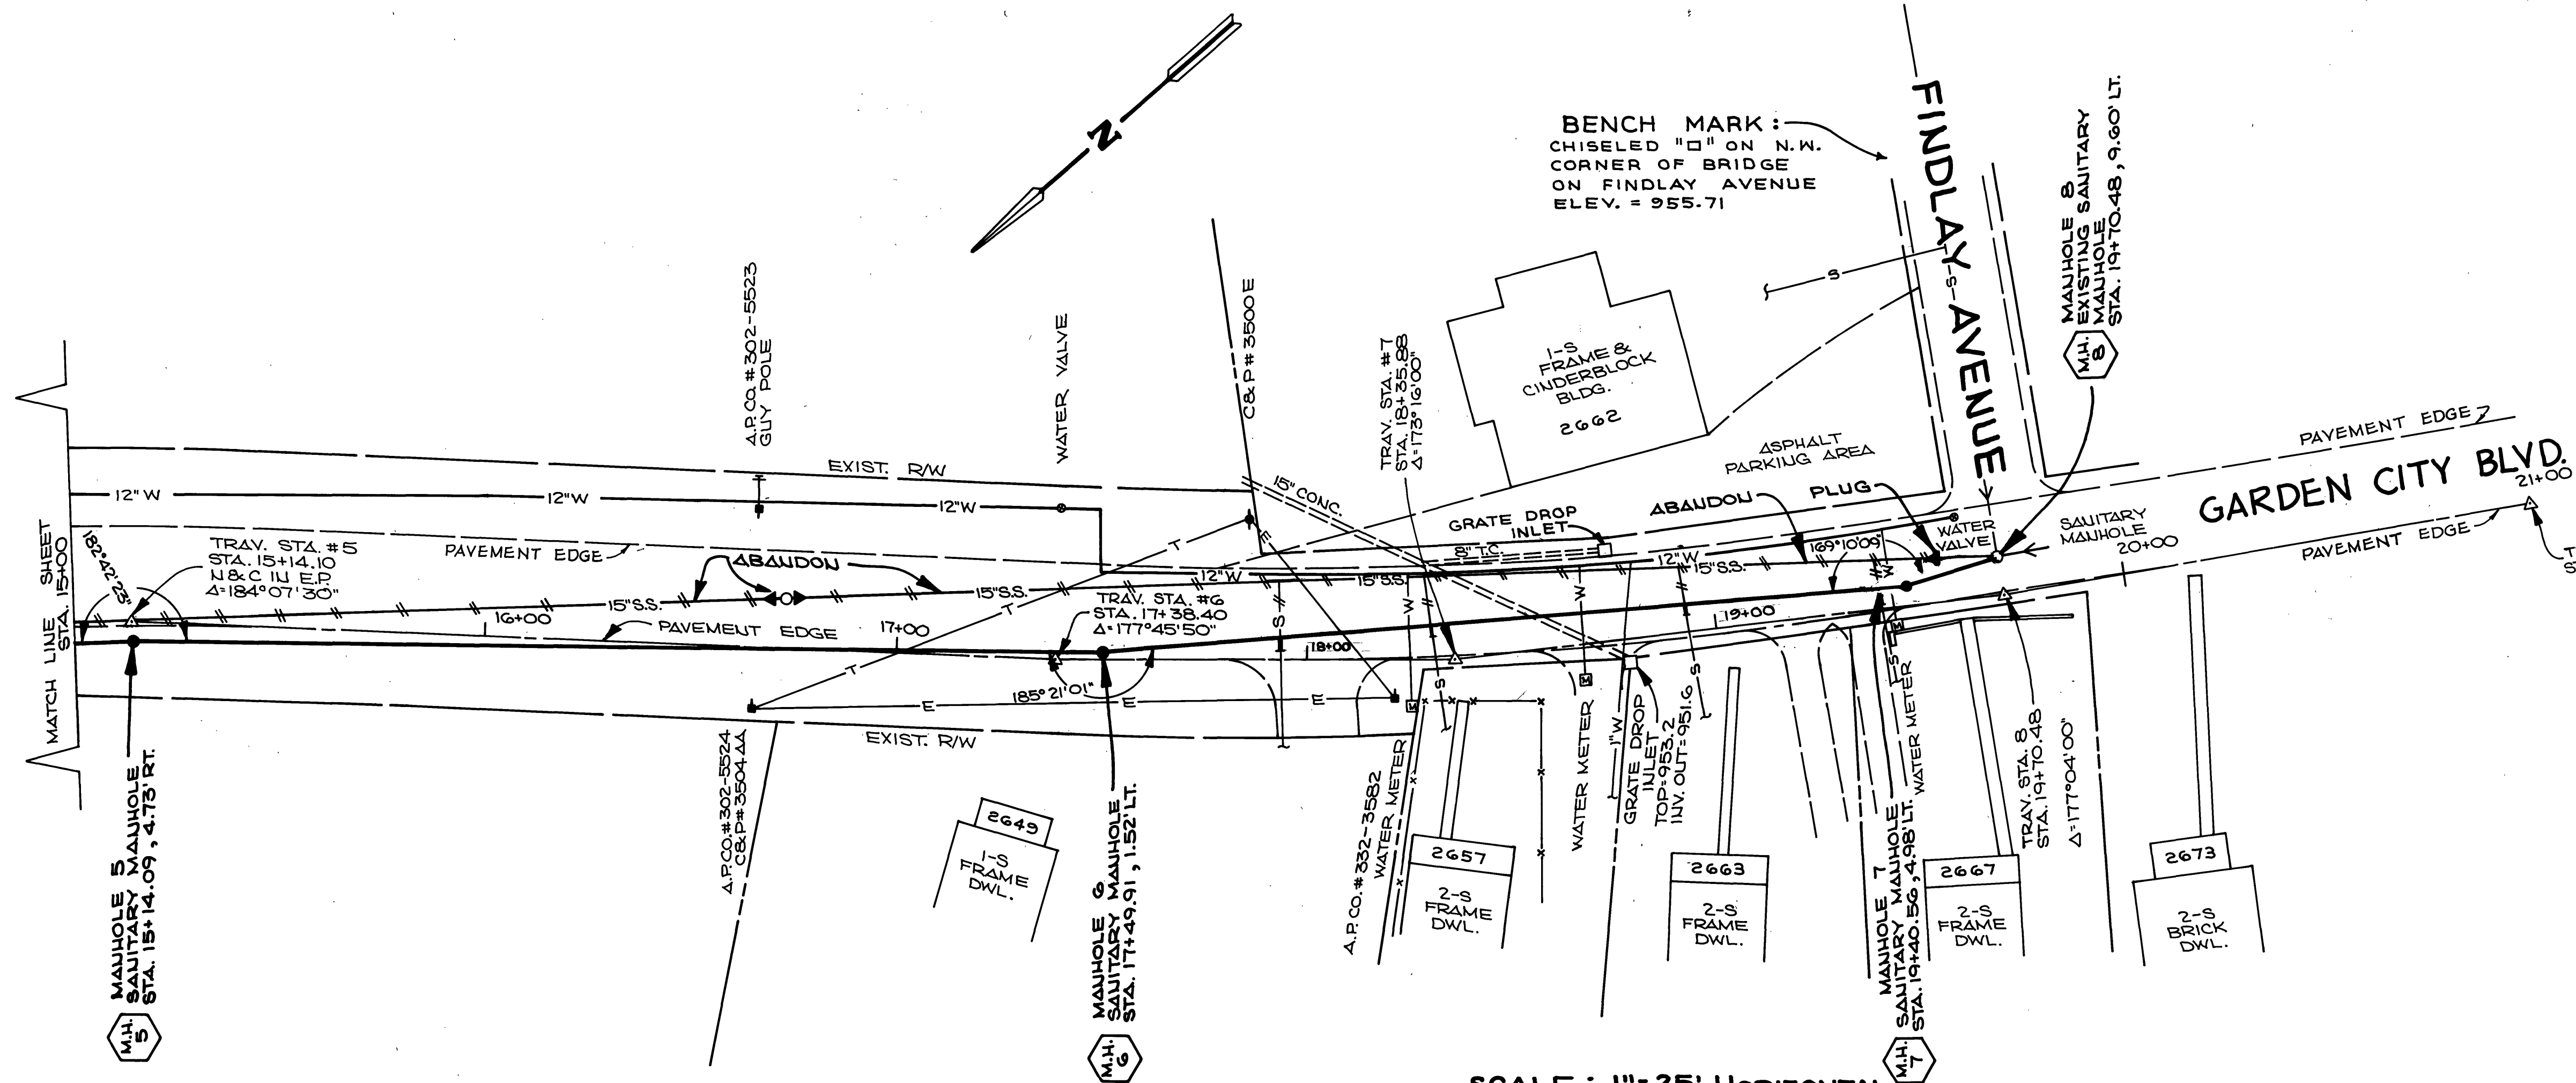

PRECAST CONCRETE
DROP MANHOLE
NOT TO SCALE

SCALE: 1"=25' HORIZONTAL

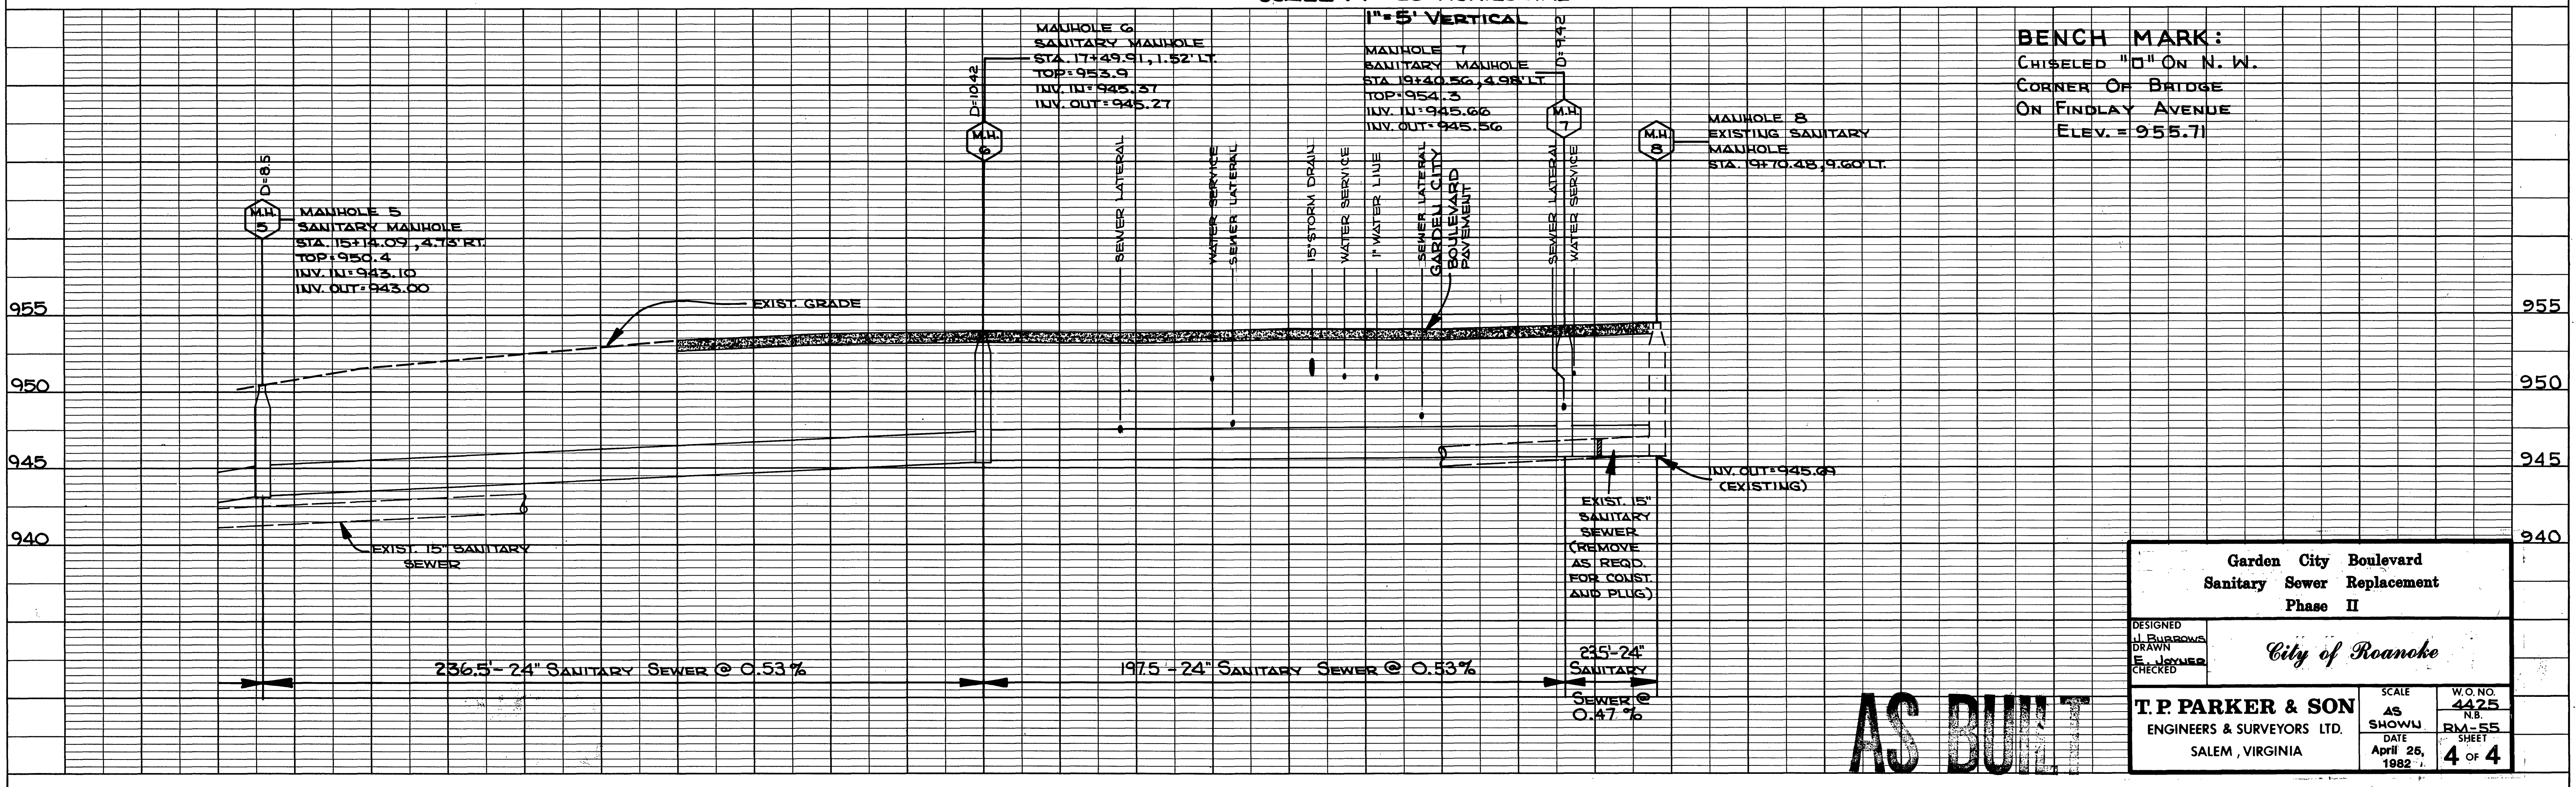

BENCH MARK:
CHISELED "D" ON N. W.
CORNER OF BRIDGE
ON FINDLAY AVENUE
ELEV. = 955.71

Garden City Boulevard Sanitary Sewer Replacement Phase II			
City of Roanoke			
DESIGNED U. BURROWS	SCALE AS SHOWN	W.O. NO. 4425	SHEET 4 OF 4
DRAWN E. JOYNER	DATE April 25, 1982	RVA-55	
CHECKED			
T.P. PARKER & SON ENGINEERS & SURVEYORS LTD. SALEM, VIRGINIA			

AS BUILT