


PROJECT LOCATION MAP

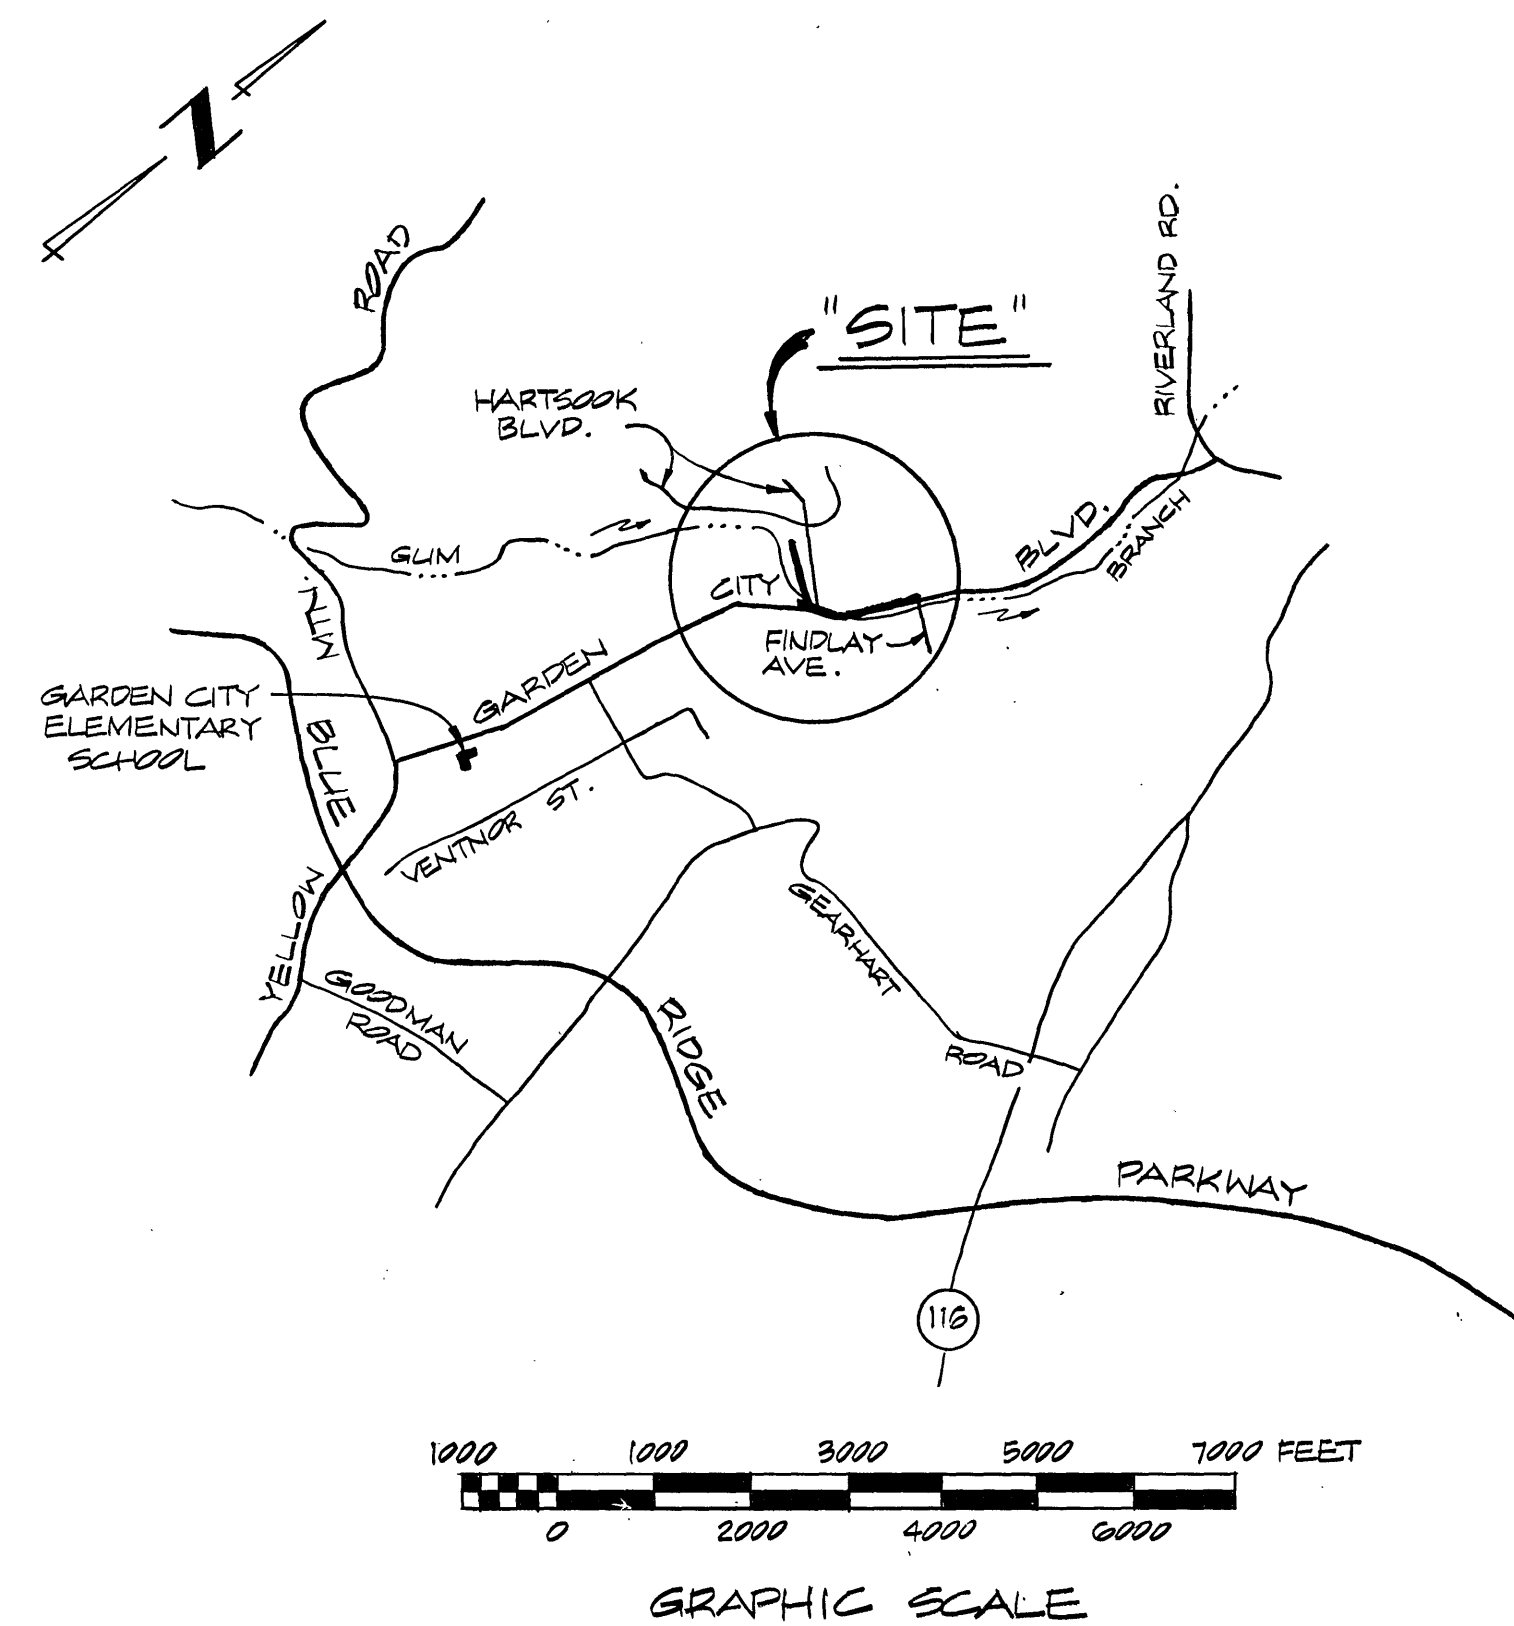

OFFICE OF CITY ENGINEER
ROOM 350
MUNICIPAL BUILDING
215 CHURCH AVENUE, S.W.
ROANOKE, VIRGINIA 24011

INDEX OF SHEETS


SHEET NO.	DESCRIPTION
1	TITLE SHEET
2	ABBREVIATION, LEGEND & QUANTITIES
3	PLAN & PROFILE
4	PLAN & PROFILE
5	PLAN & PROFILE
6	PLAN & PROFILE
7	PLAN & PROFILE

CONSULTING ENGINEERS

**BUFORD T. LUMSDEN
& ASSOCIATES, P.C.**

ENGINEERS AND SURVEYORS

COMMISSION NUMBER: **83-32**

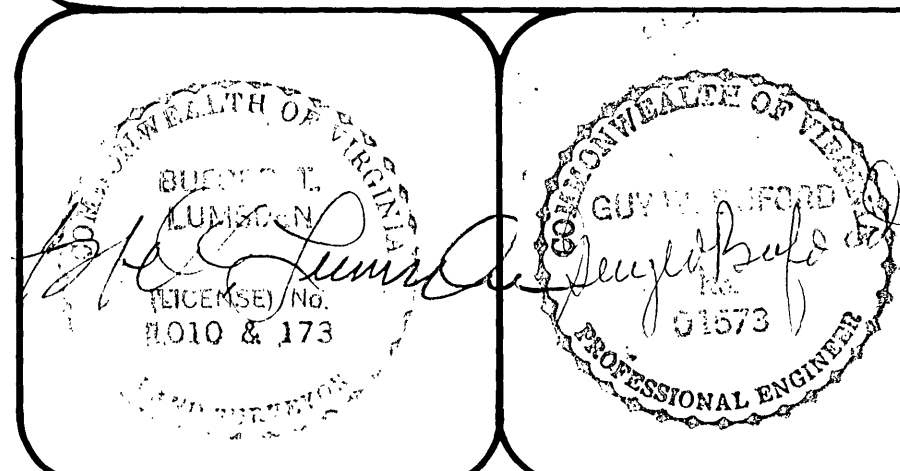

PROJECT NAME

**GARDEN CITY SANITARY SEWER REPLACEMENT
PHASE III**

PROJECT NUMBER: **5488**

REVISION	BY	DESCRIPTION:	DATE
REVISION	BY	DESCRIPTION:	DATE
REVISION	BY	DESCRIPTION:	DATE
REVISION	BY	DESCRIPTION:	DATE

APPROVED FOR CONSTRUCTION

<i>Charles M. Huffine</i> ROANOKE CITY ENGINEER	<u>3-25-85</u> DATE
<i>William F. Clark</i> DIRECTOR OF PUBLIC WORKS	<u>3-25-85</u> DATE
<i>Pat B. Clark</i> DIRECTOR OF UTILITIES AND OPERATIONS	<u>3/25/85</u> DATE
	DATE
	DATE

ADVERTISED DATE: _____

SET NUMBER: **AS BUILT**

SHEET NUMBER: **1** OF **7**

AS-BUILT