



PROFILE	SURVEYED _____	BY _____	DATE _____
	PLOTTED _____ GRADES CHECKED _____ B. M.'s NOTED _____ STRUCTURE NOTATIONS CHECKED _____		
NOTE BOOK			
No. _____			

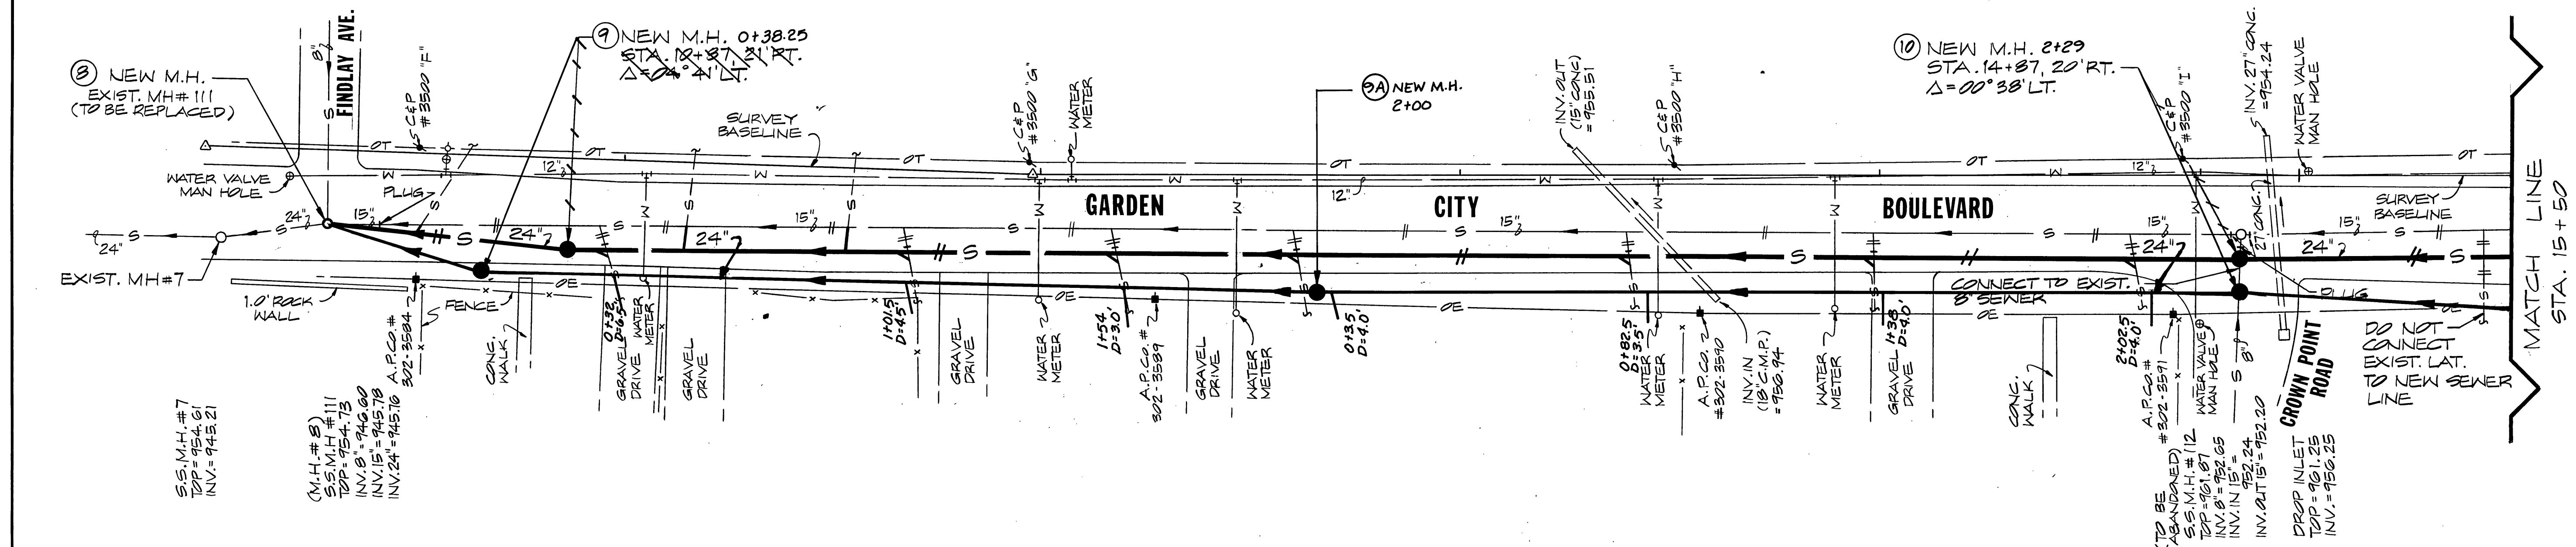

PLAN
SCALE: 1" = 20'

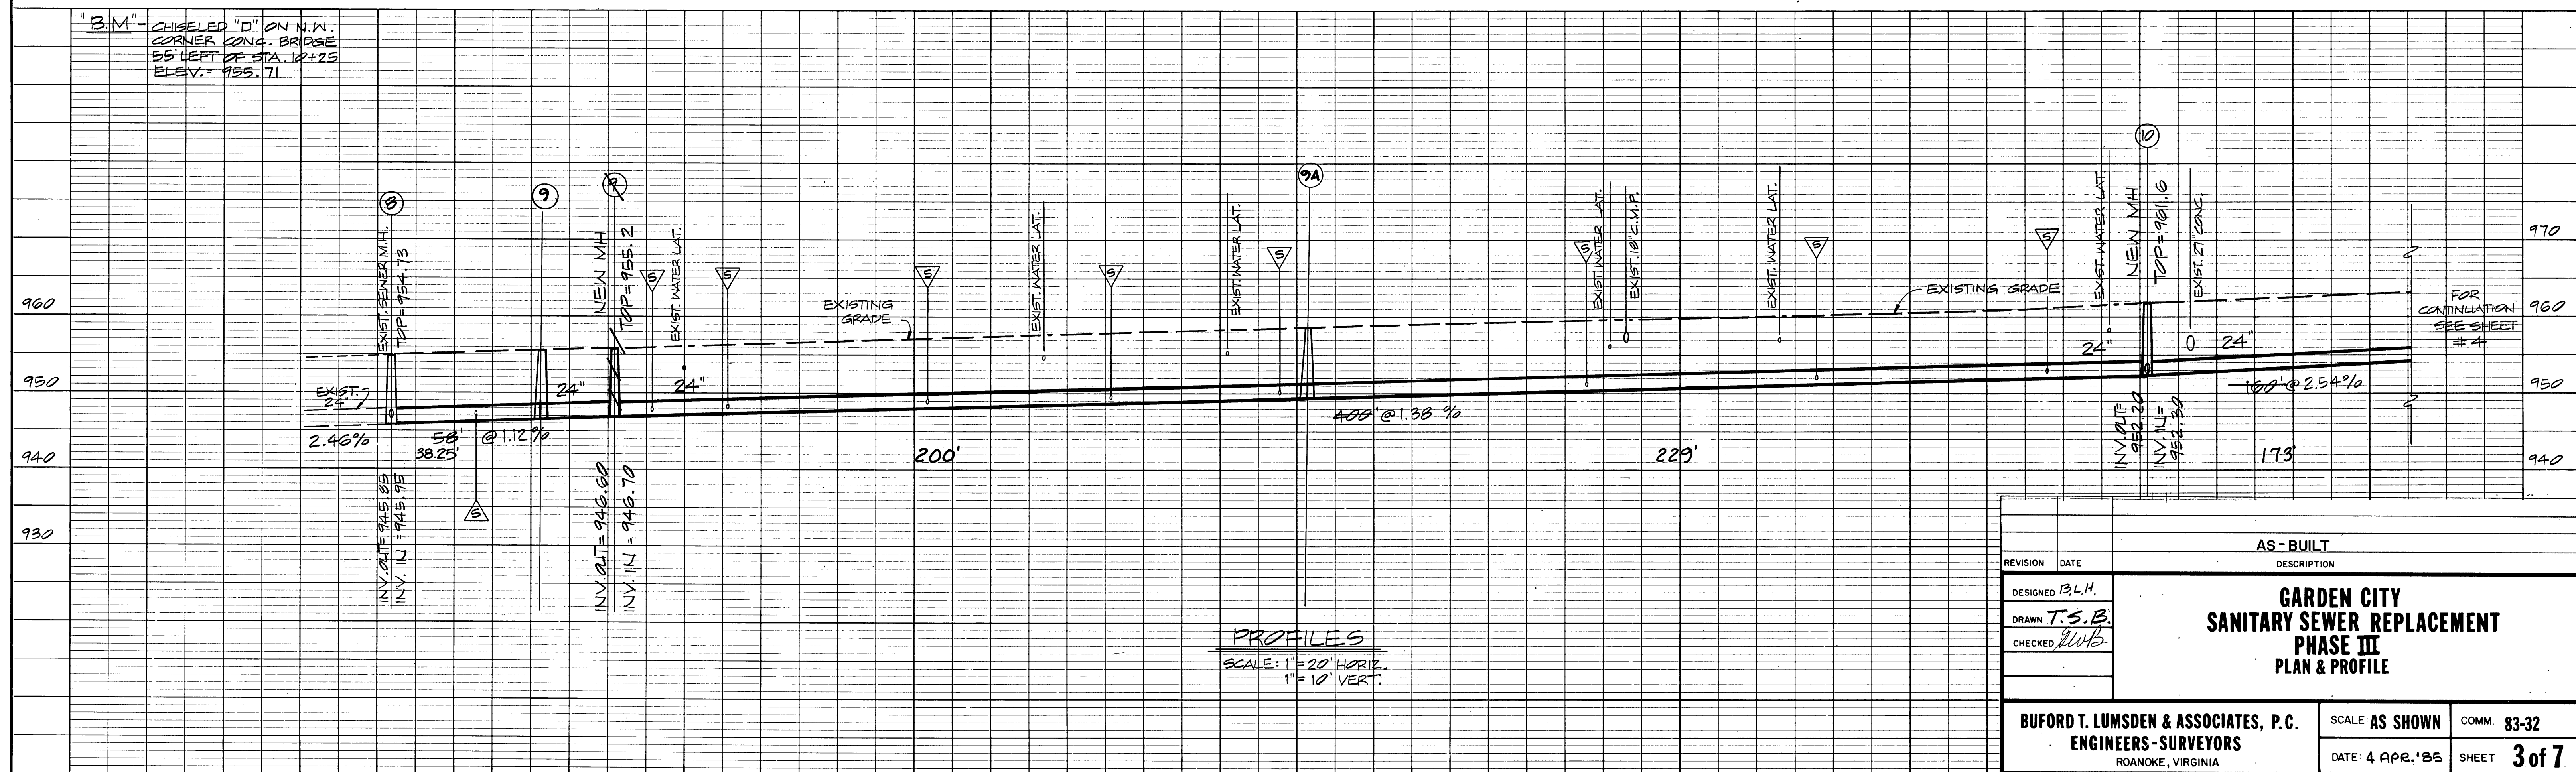

PROFILES
SCALE: 1" = 20' HORIZ.
1" = 10' VERT.

		AS - BUILT	
REVISION	DATE	DESCRIPTION	
DESIGNED	B.L.H.	GARDEN CITY SANITARY SEWER REPLACEMENT PHASE III PLAN & PROFILE	
DRAWN	T.S.B.		
CHECKED	WLB		
BUFORD T. LUMSDEN & ASSOCIATES, P.C. ENGINEERS - SURVEYORS ROANOKE, VIRGINIA		SCALE: AS SHOWN DATE: 4 APR. '85	COMM: 83-32 SHEET: 3 of 7

AS BUILT PLAN NO. 5488