
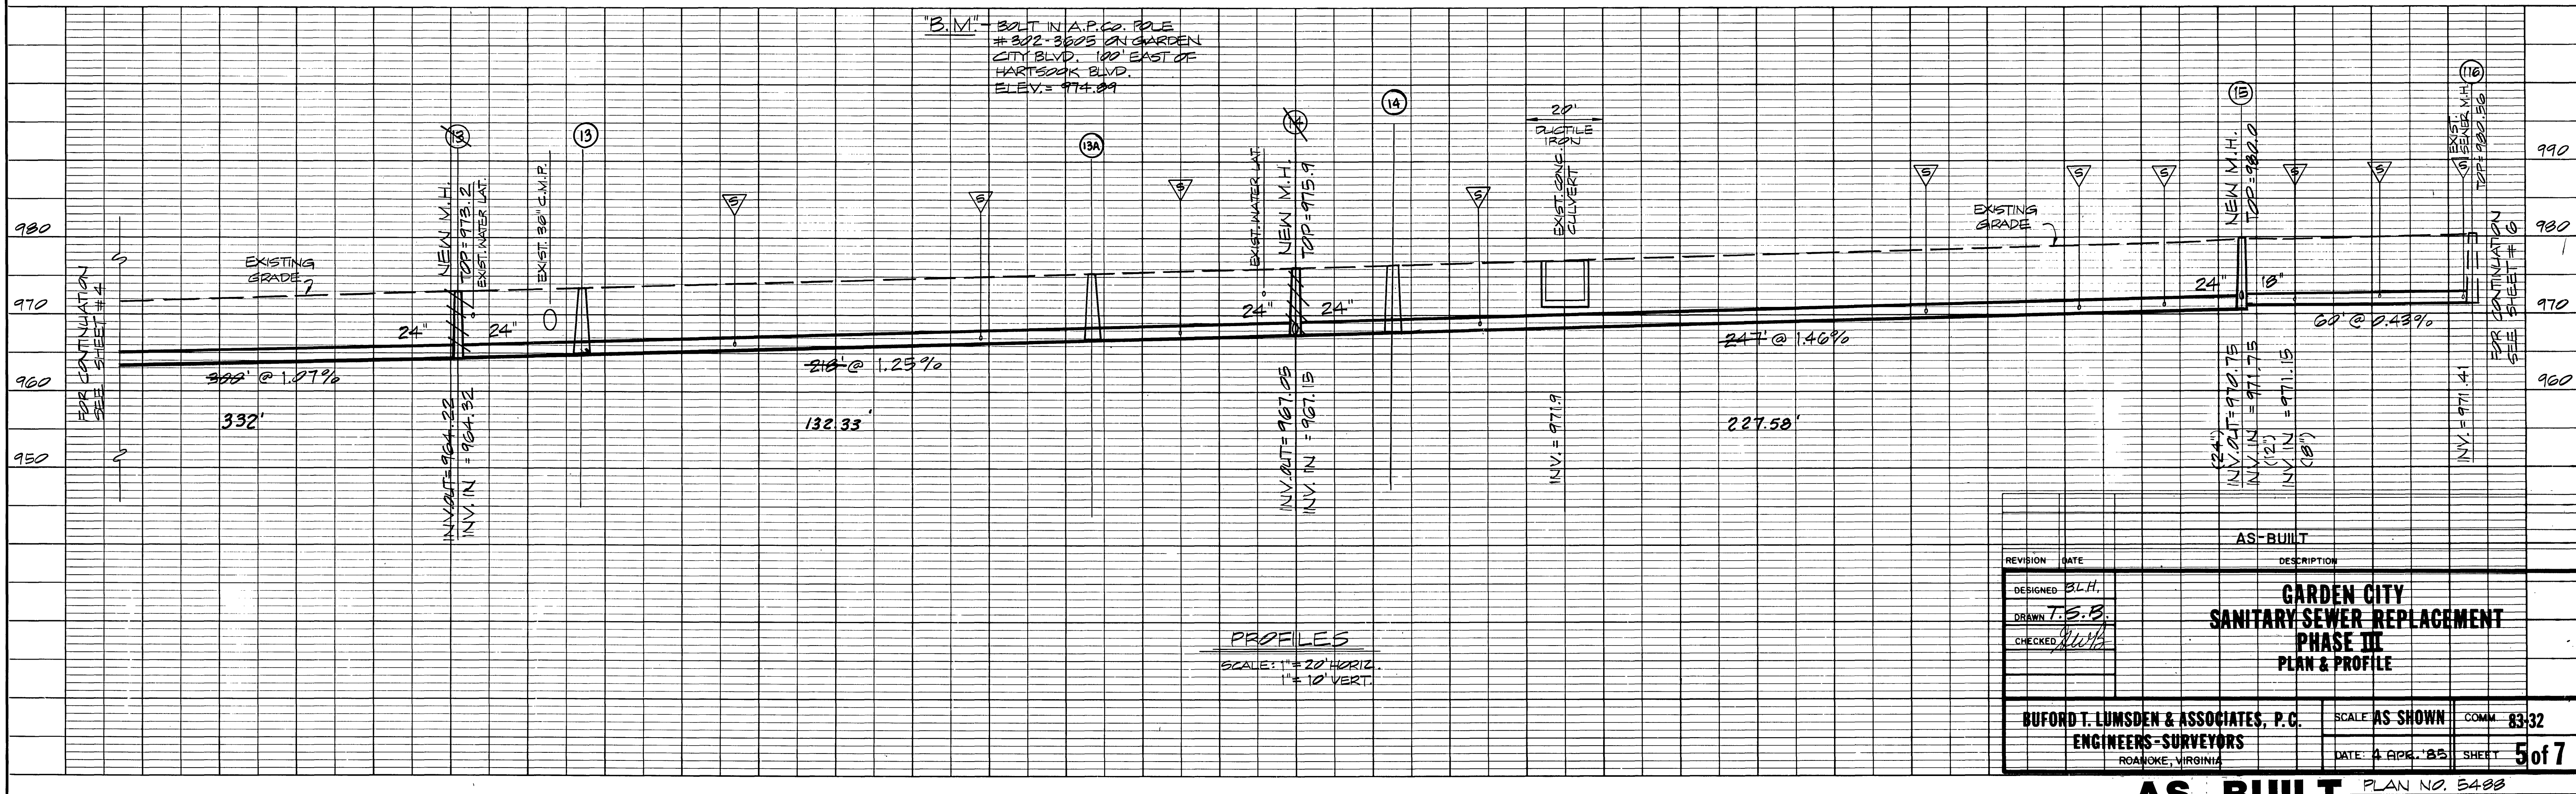


PLAN	DATE	
	BY	
	REVISION	
	NOTED	
NOTE BOOK	NO.	
	DATE	

PROFILE	DATE	
	BY	
	REVISION	
	NOTED	
NOTE BOOK	NO.	
	DATE	

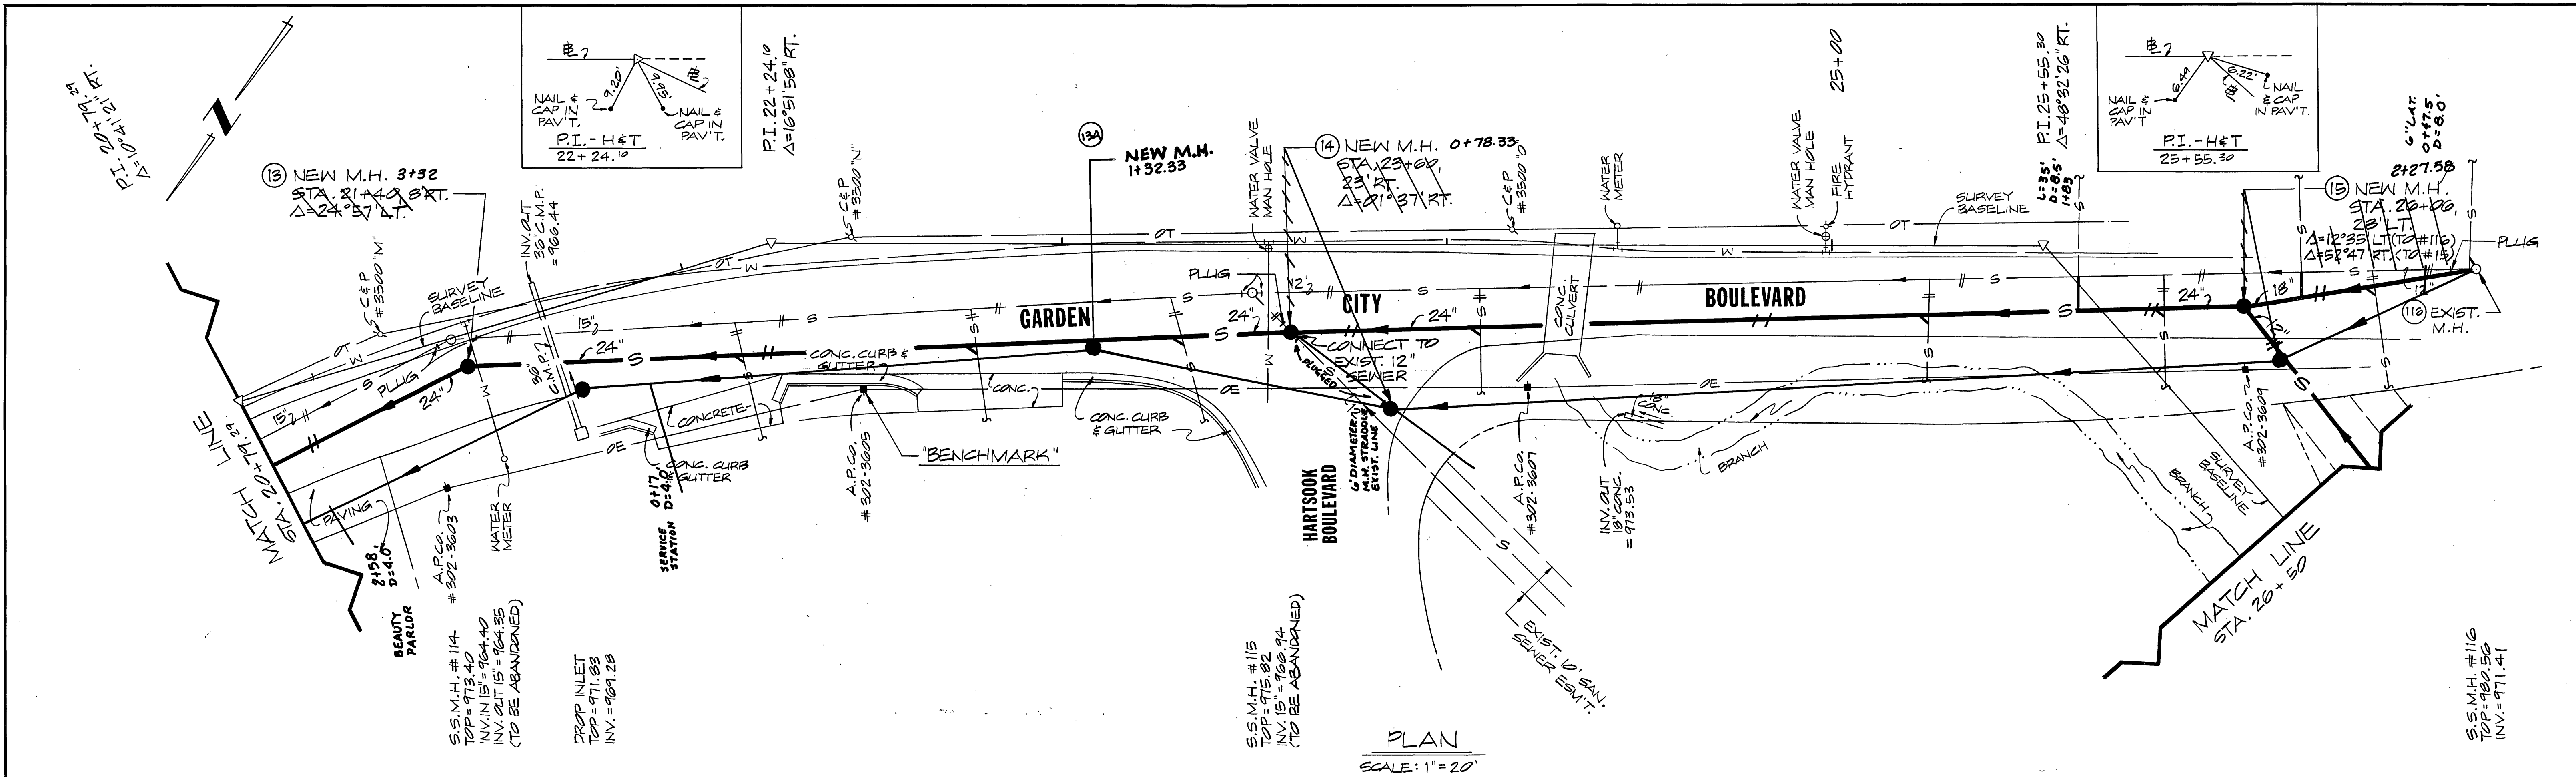

REVISION		DATE	DESCRIPTION
DESIGNED	BY		
DRAWN	BY		
CHECKED	BY		
AS-BUILT			
GARDEN CITY SANITARY SEWER REPLACEMENT PHASE III PLAN & PROFILE			
BUFORD T. LUMSDEN & ASSOCIATES, P.C. ENGINEERS-SURVEYORS ROANOKE, VIRGINIA		SCALE AS SHOWN DATE: 4 APR. '85	COMM 83-32 SHEET 5 of 7