

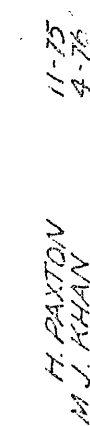


55/55

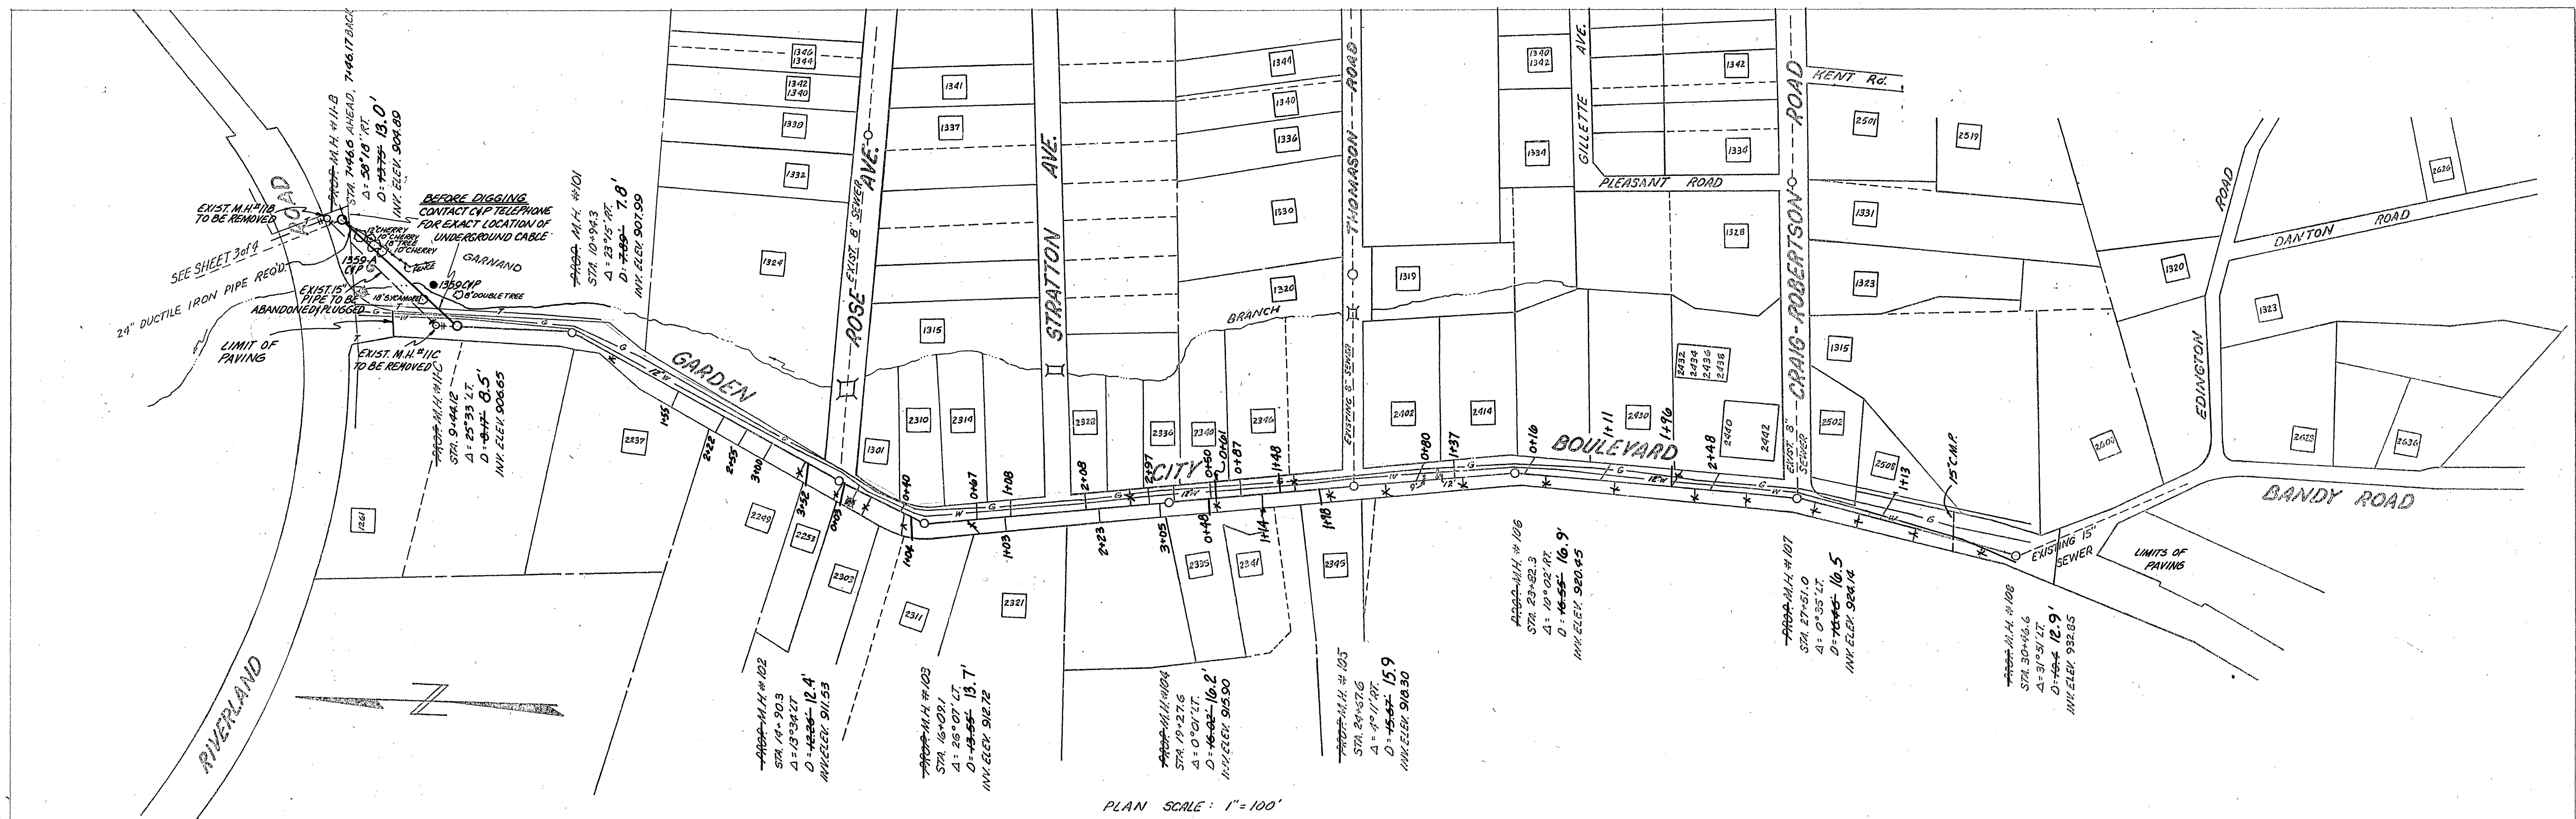

551555

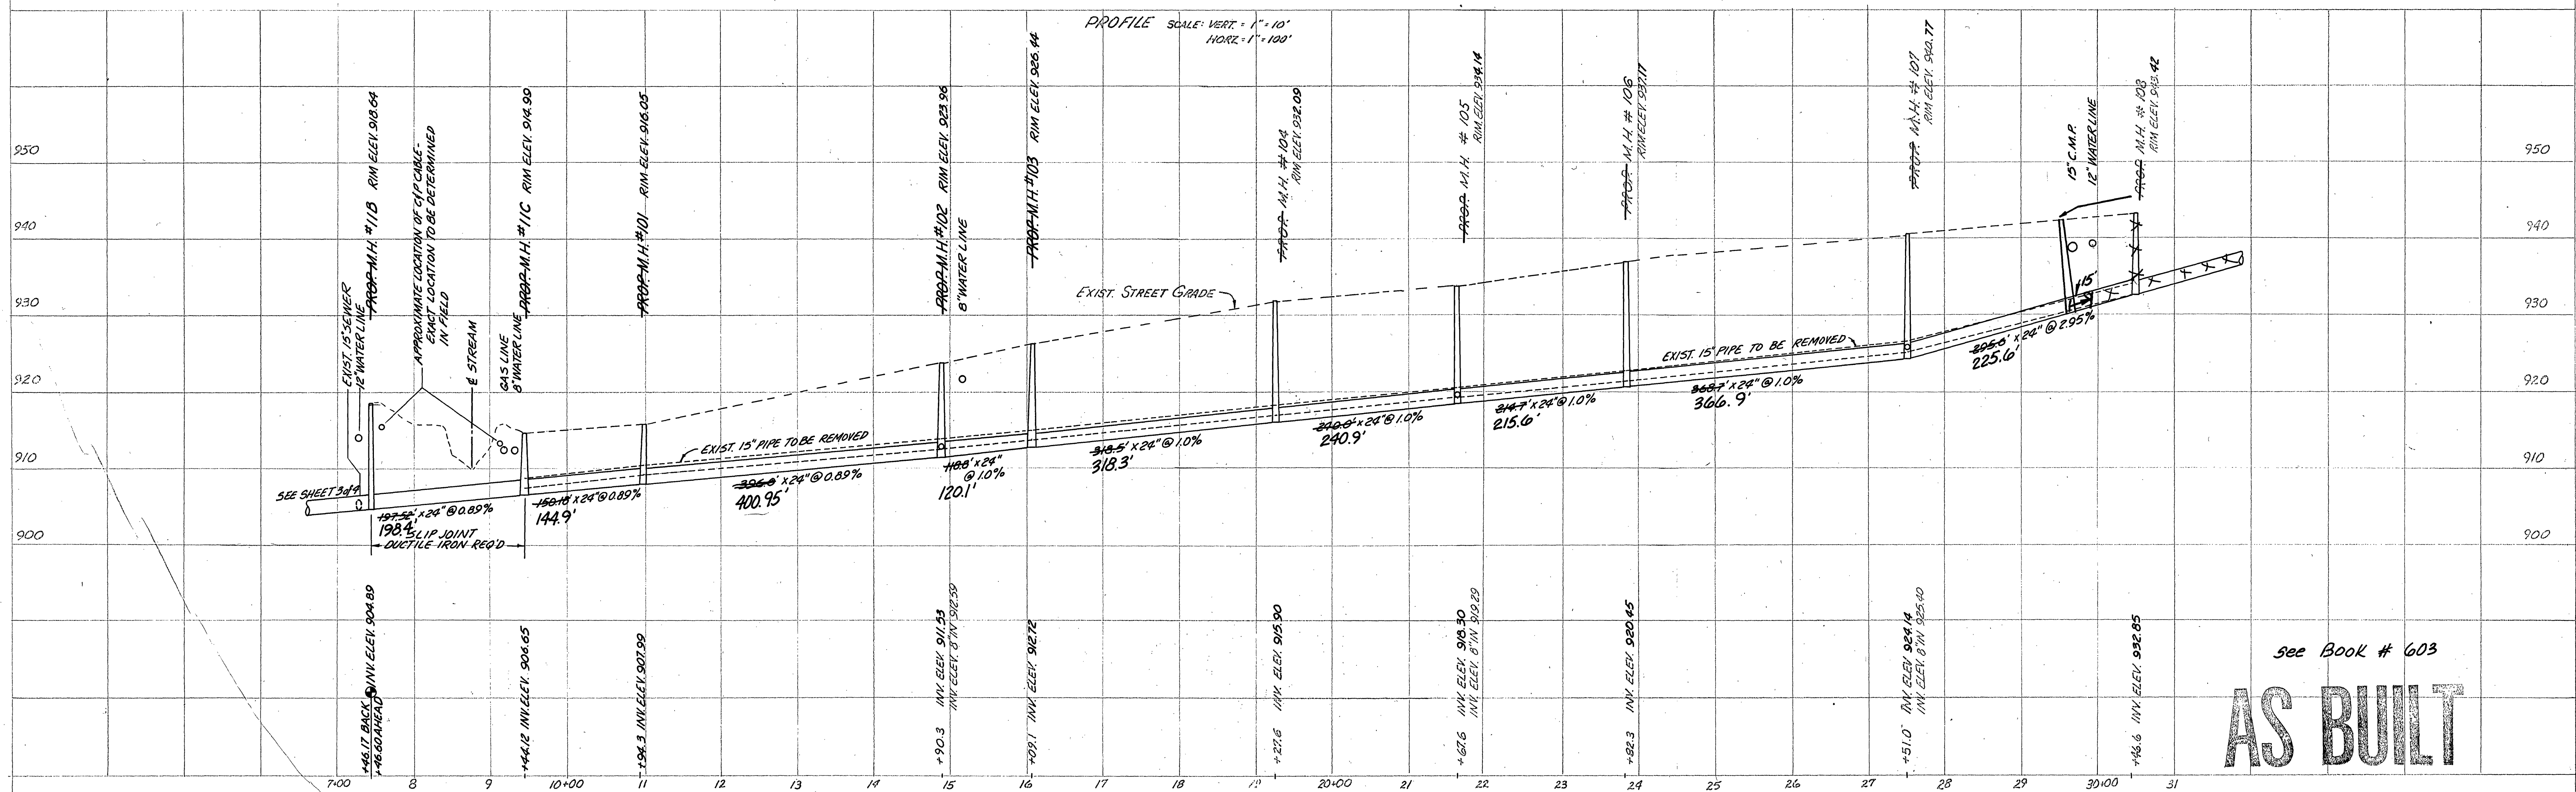

see BOOK # 603

AS BUILT