
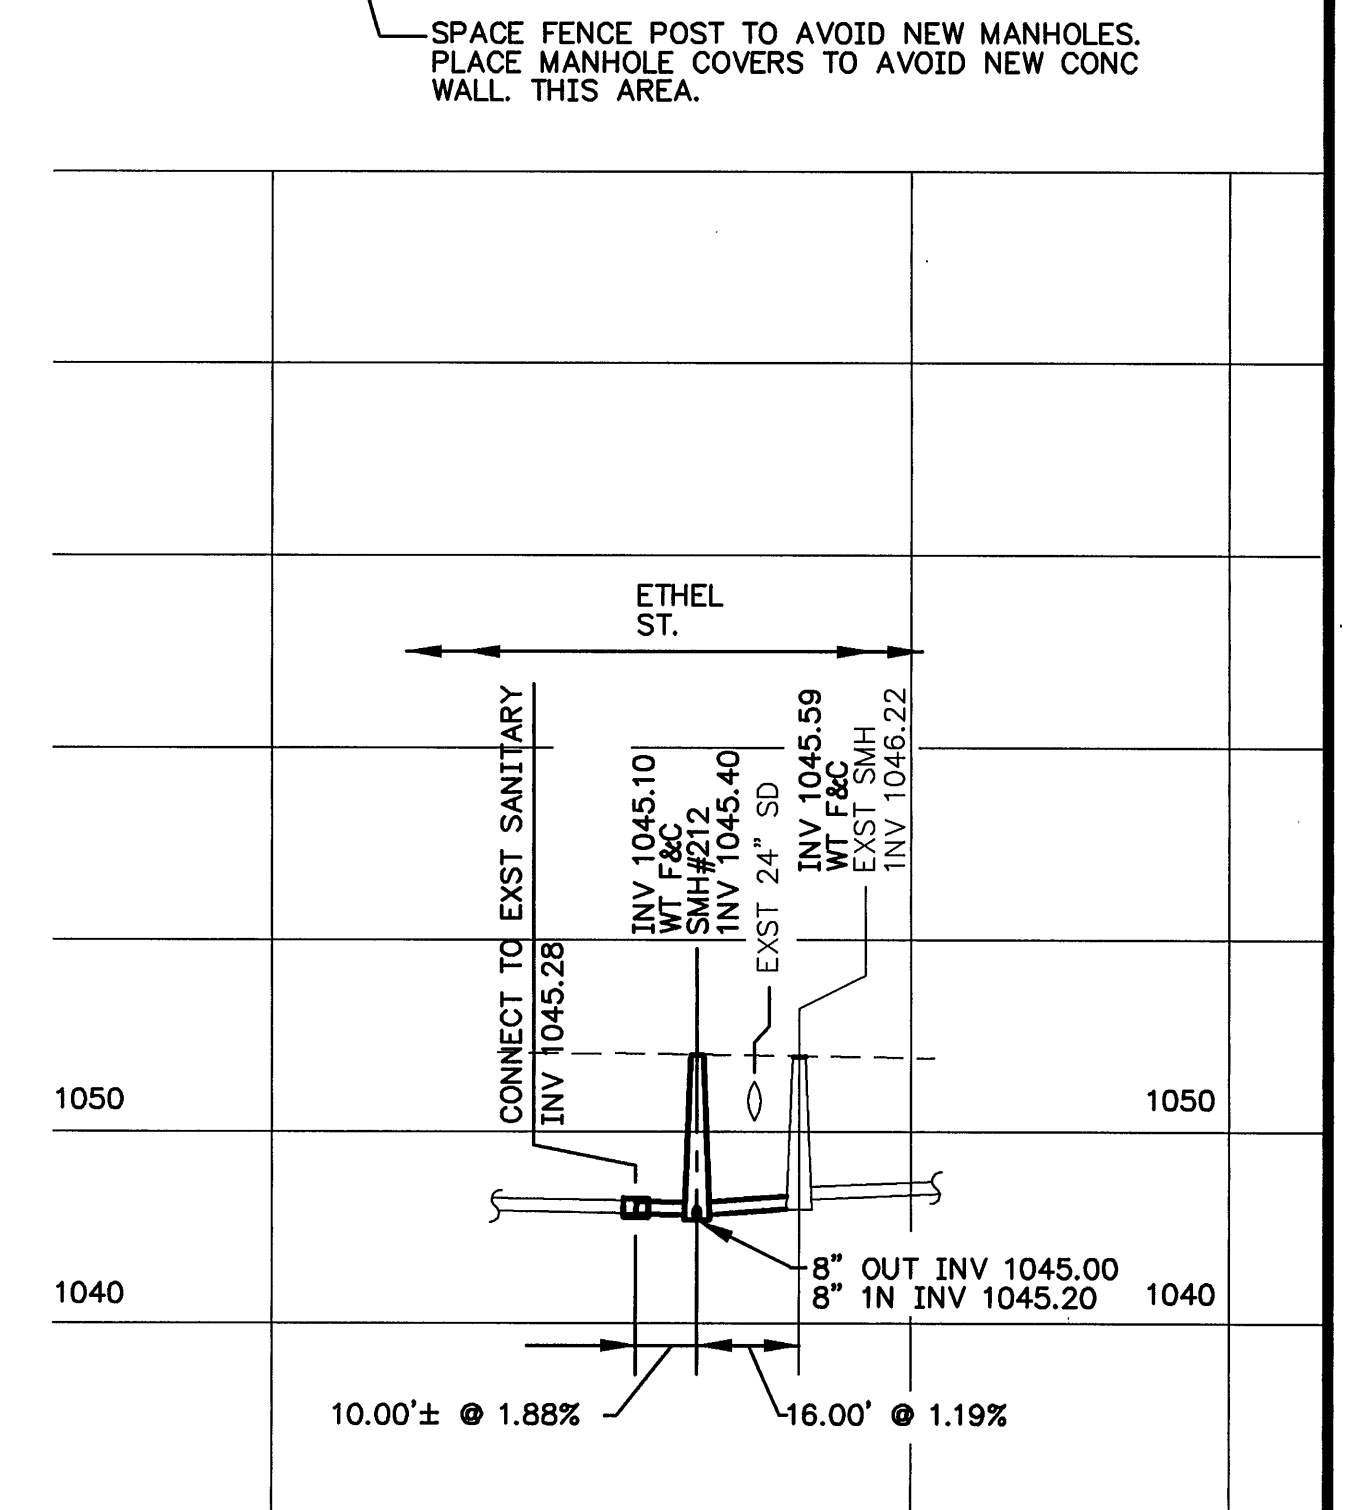
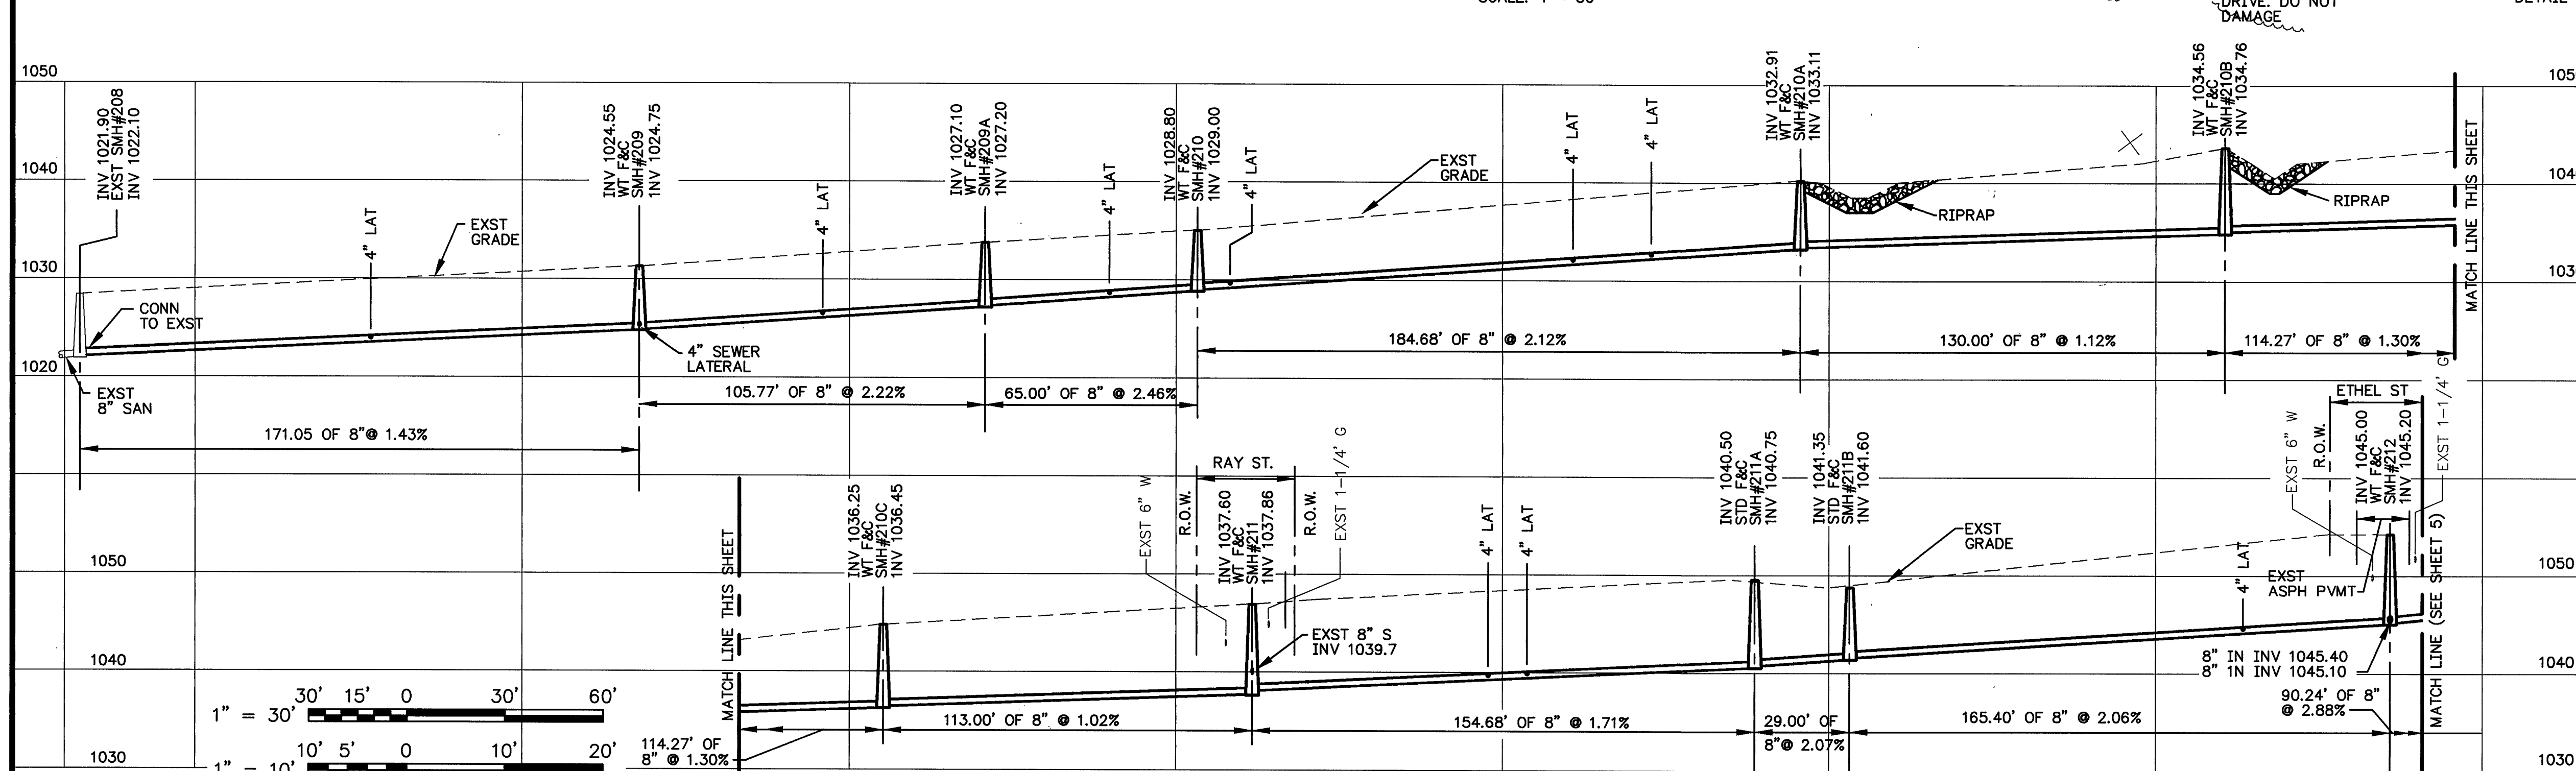


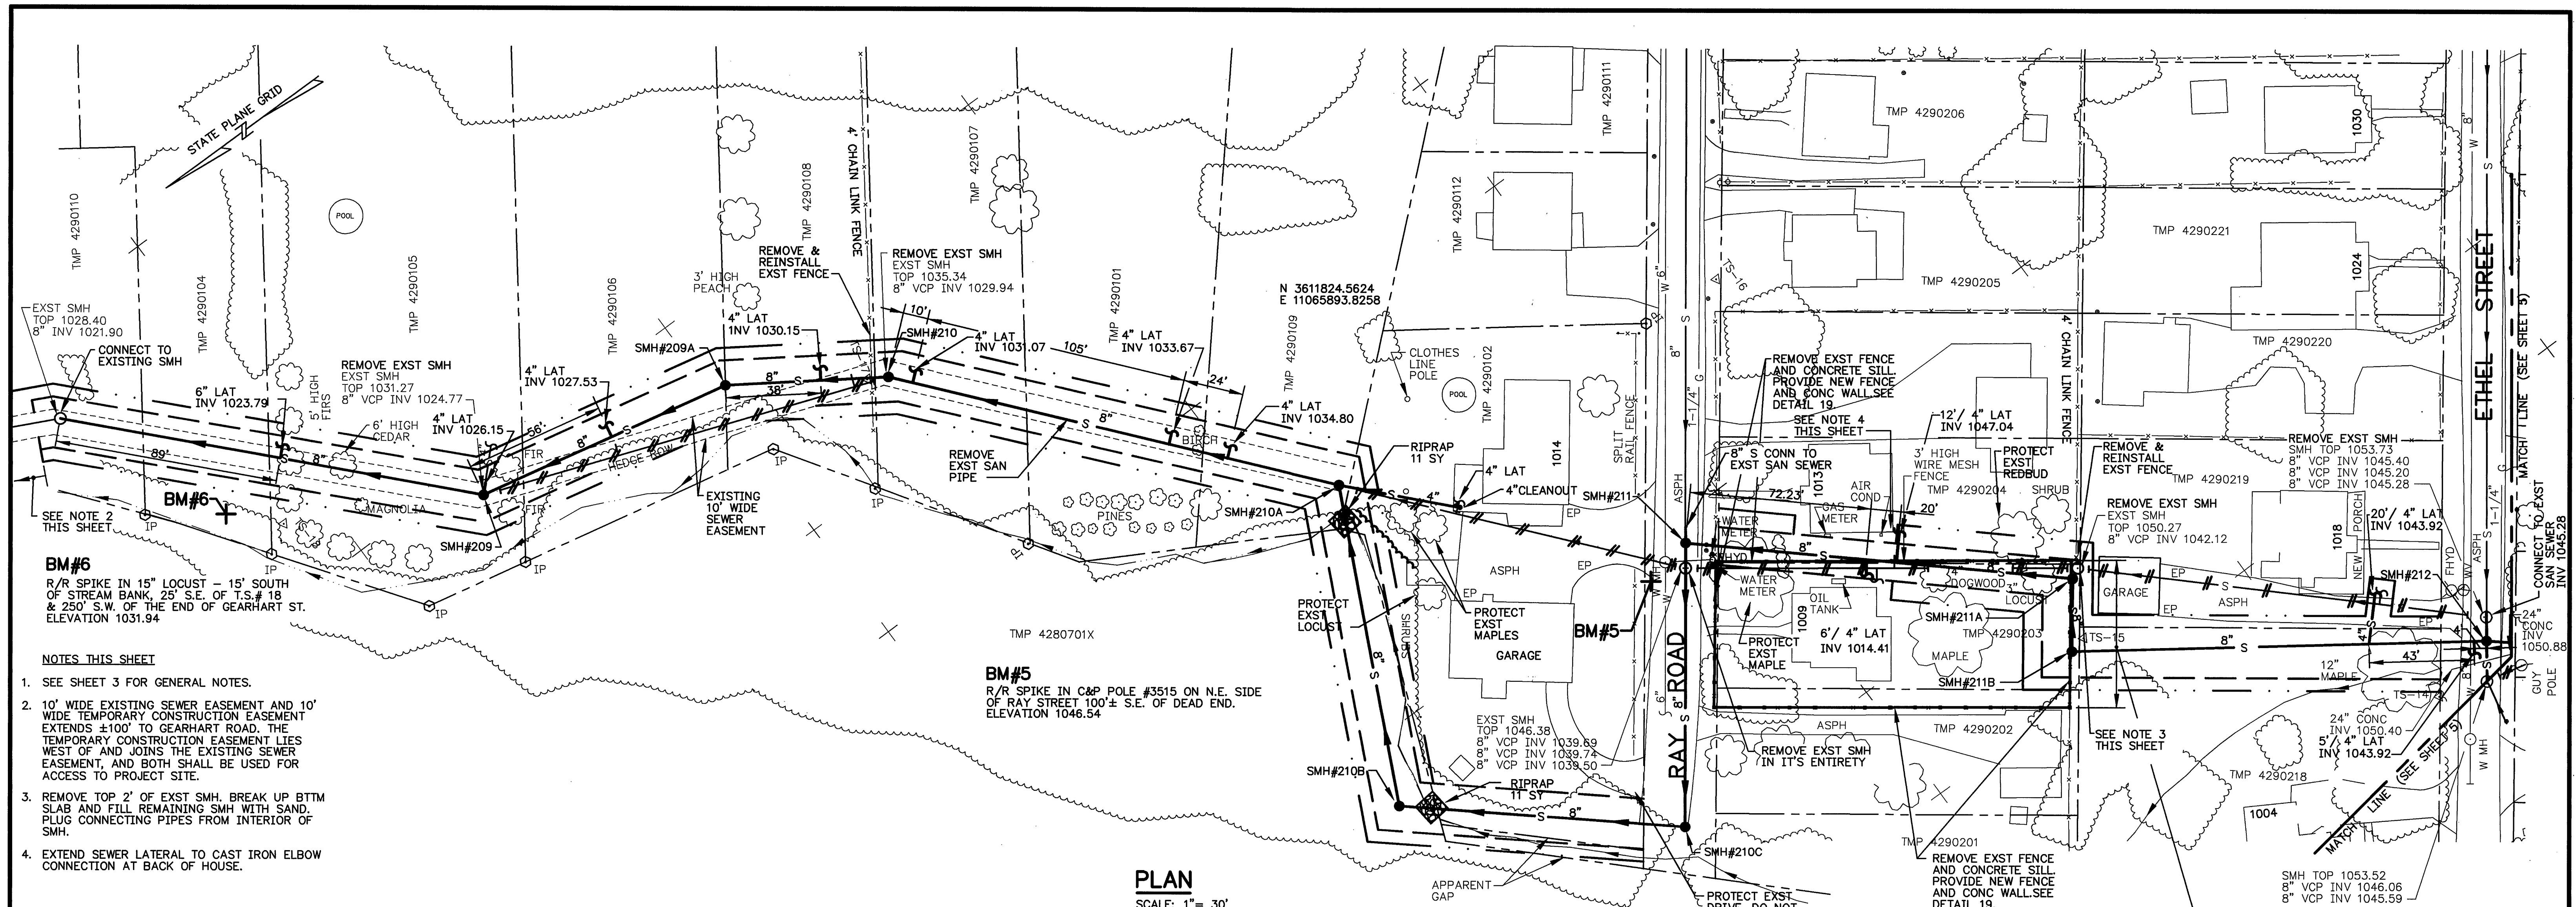

GRAPHIC SCALES

PROFILE
SCALE: 1" = 30' HORIZ.
1" = 10' VERT.

RECORD DRAWING

PROFILE
SCALE: 1" = 30' HORIZ.
1" = 10' VERT.

HAYES, SEAY, MATTERN AND MATTERN ARCHITECTS/ENGINEERS/PLANNERS	DESIGNED: DMC	DATE	BY	REVISIONS			SEWER REPLACEMENT PROJECT GC-1 GARDEN CITY SEWERSHED ROANOKE, VIRGINIA			SHEET NO. 4
		7/3/97	DMC	DESCRIPTION						
	DRAWN: DMC			RECORD DRAWINGS PREPARED FROM DRAWINGS AND INFORMATION PROVIDED BY PRILLAMAN AND PACE, INC.						
	CHECKED: DMH									
	APPROVED: DMH									
							PLAN AND PROFILE			
							COMM. NO.: 7122B	SCALE: AS SHOWN	DATE: JUNE 19 1996	