



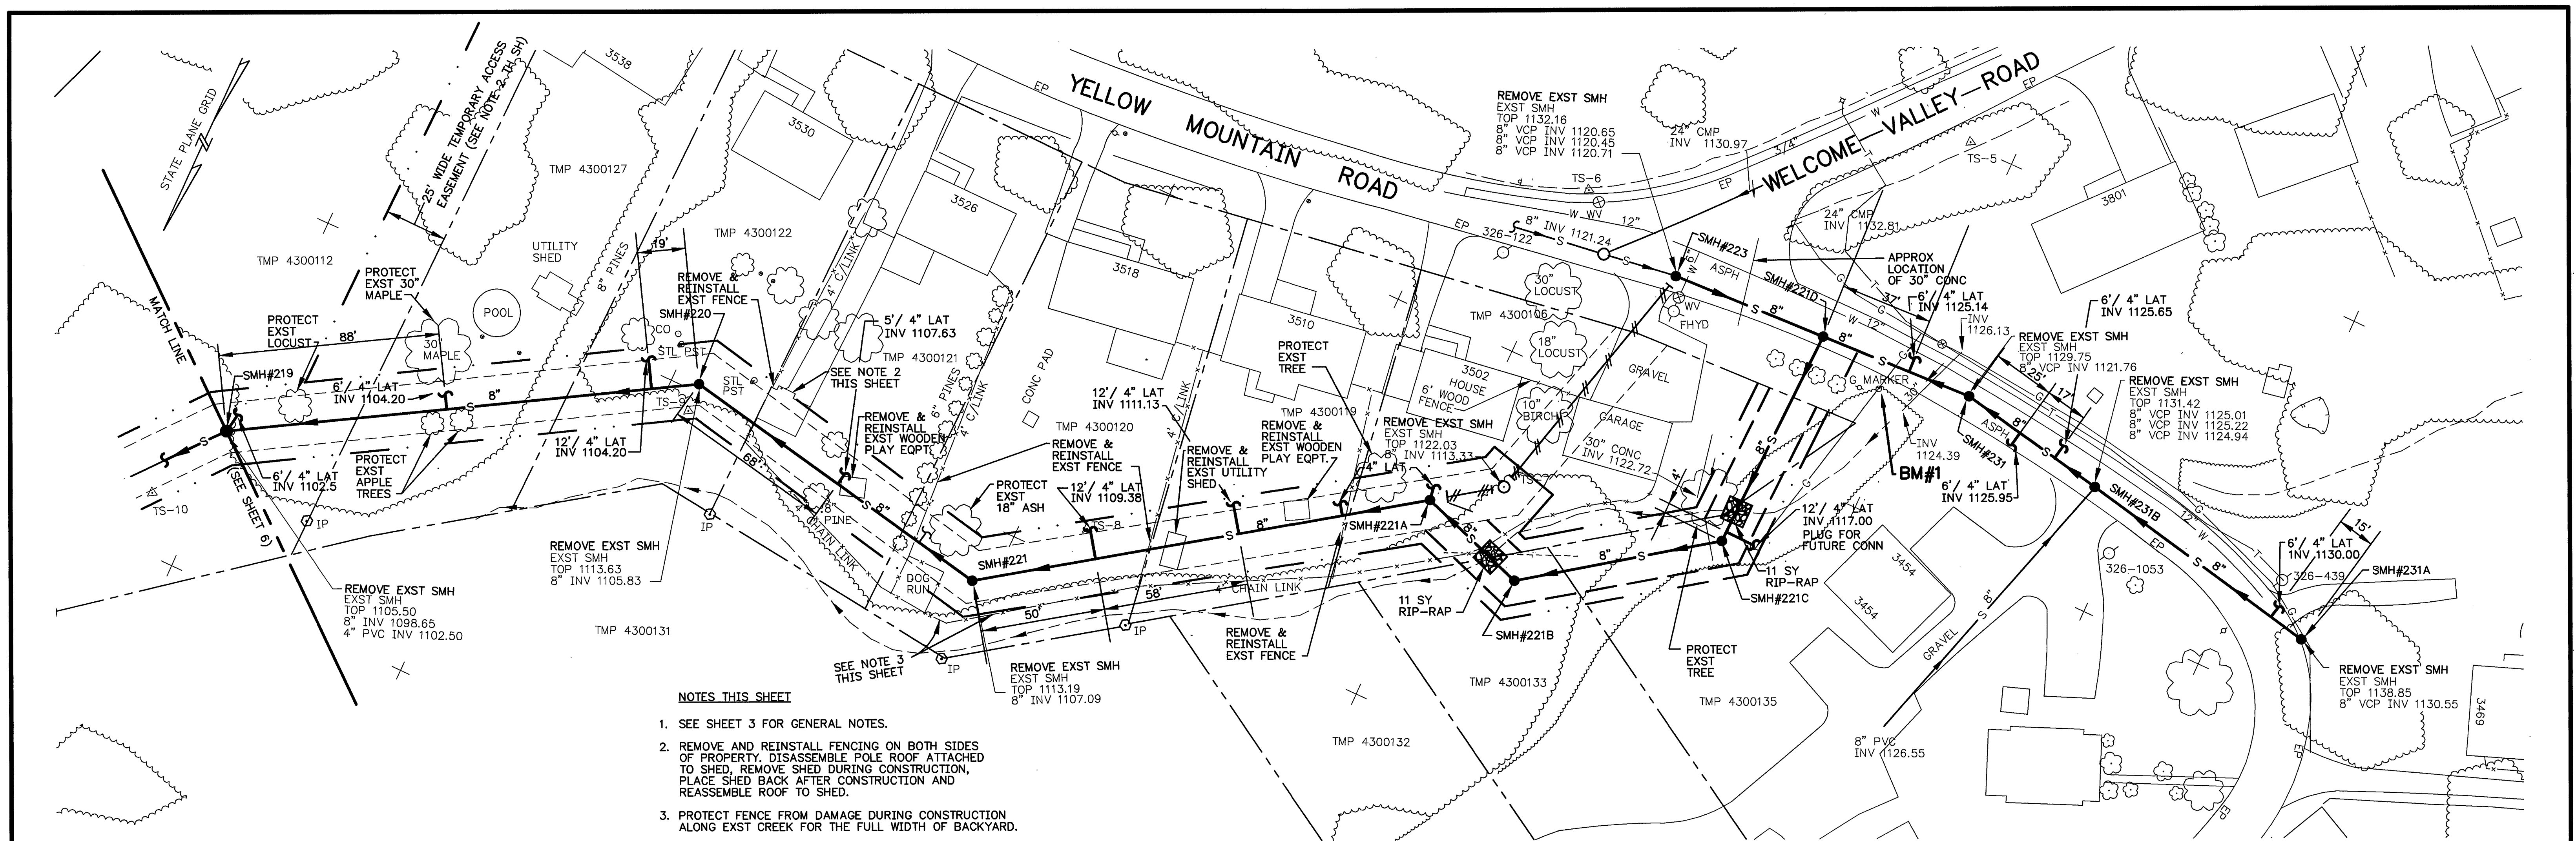

- NOTES THIS SHEET**
- SEE SHEET 3 FOR GENERAL NOTES.
 - REMOVE AND REINSTALL FENCING ON BOTH SIDES OF PROPERTY. DISASSEMBLE POLE ROOF ATTACHED TO SHED, REMOVE SHED DURING CONSTRUCTION, PLACE SHED BACK AFTER CONSTRUCTION AND REASSEMBLE ROOF TO SHED.
 - PROTECT FENCE FROM DAMAGE DURING CONSTRUCTION ALONG EXST CREEK FOR THE FULL WIDTH OF BACKYARD.
 - THE TEMPORARY EASEMENT FOR CONSTRUCTION AND ACCESS ONLY APPLY TO THIS SANITARY SEWER CONSTRUCTION PROJECT AND WILL CEASE TO EXIST AFTER CONSTRUCTION IS COMPLETED AND THE CONTRACTOR IS RELEASED FROM THIS PROJECT. REESTABLISH TO PRECONSTRUCTION CONDITION ALL AREAS DISTURBED DURING CONSTRUCTION OR DURING USE OF THE TEMPORARY CONSTRUCTION ACCESS EASEMENT (SEE GENERAL NOTES ON SH 3). ACCESS EASEMENT EXTENDS TO YELLOW MOUNTAIN ROAD AND IT IS UNDERSTOOD THAT THE CONTRACTOR SHALL ADDRESS THE TEMPORARY CONSTRUCTION ACCESS EASEMENT IN THE FOLLOWING WAY:
 - THE TOP SOIL ALONG THE ACCESS EASEMENT SHALL BE CAREFULLY REMOVED AND SAVED FOR LATER USE. AN ADEQUATE STONE BASE SHALL BE CONSTRUCTED FOR THE USE OF THE CONSTRUCTION VEHICLES, THEREBY CLEARLY IDENTIFYING ONLY THE AREA TO BE USED FOR ACCESS.
 - UPON COMPLETION OF THE SEWER LINE CONSTRUCTION, CAREFULLY AND COMPLETELY REMOVE THE STONE BASE USED FOR ACCESS AND REPLACE WITH TOP SOIL FROM THE STOCKPILE AS NOTED ABOVE. SEED AND COVER WITH STRAW AND REESTABLISH GRASS GROWTH TO ITS PRECONSTRUCTION CONDITION.
 - REESTABLISH THE EXISTING DRIVEWAY ENTRANCE AT 3548 YELLOW MOUNTAIN ROAD TO ITS PRECONSTRUCTION CONDITION.

PLAN
SCALE: 1" = 30'


BM#1
R/R SPIKE IN
APCO POLE #326-123
ELEV. 1129.71

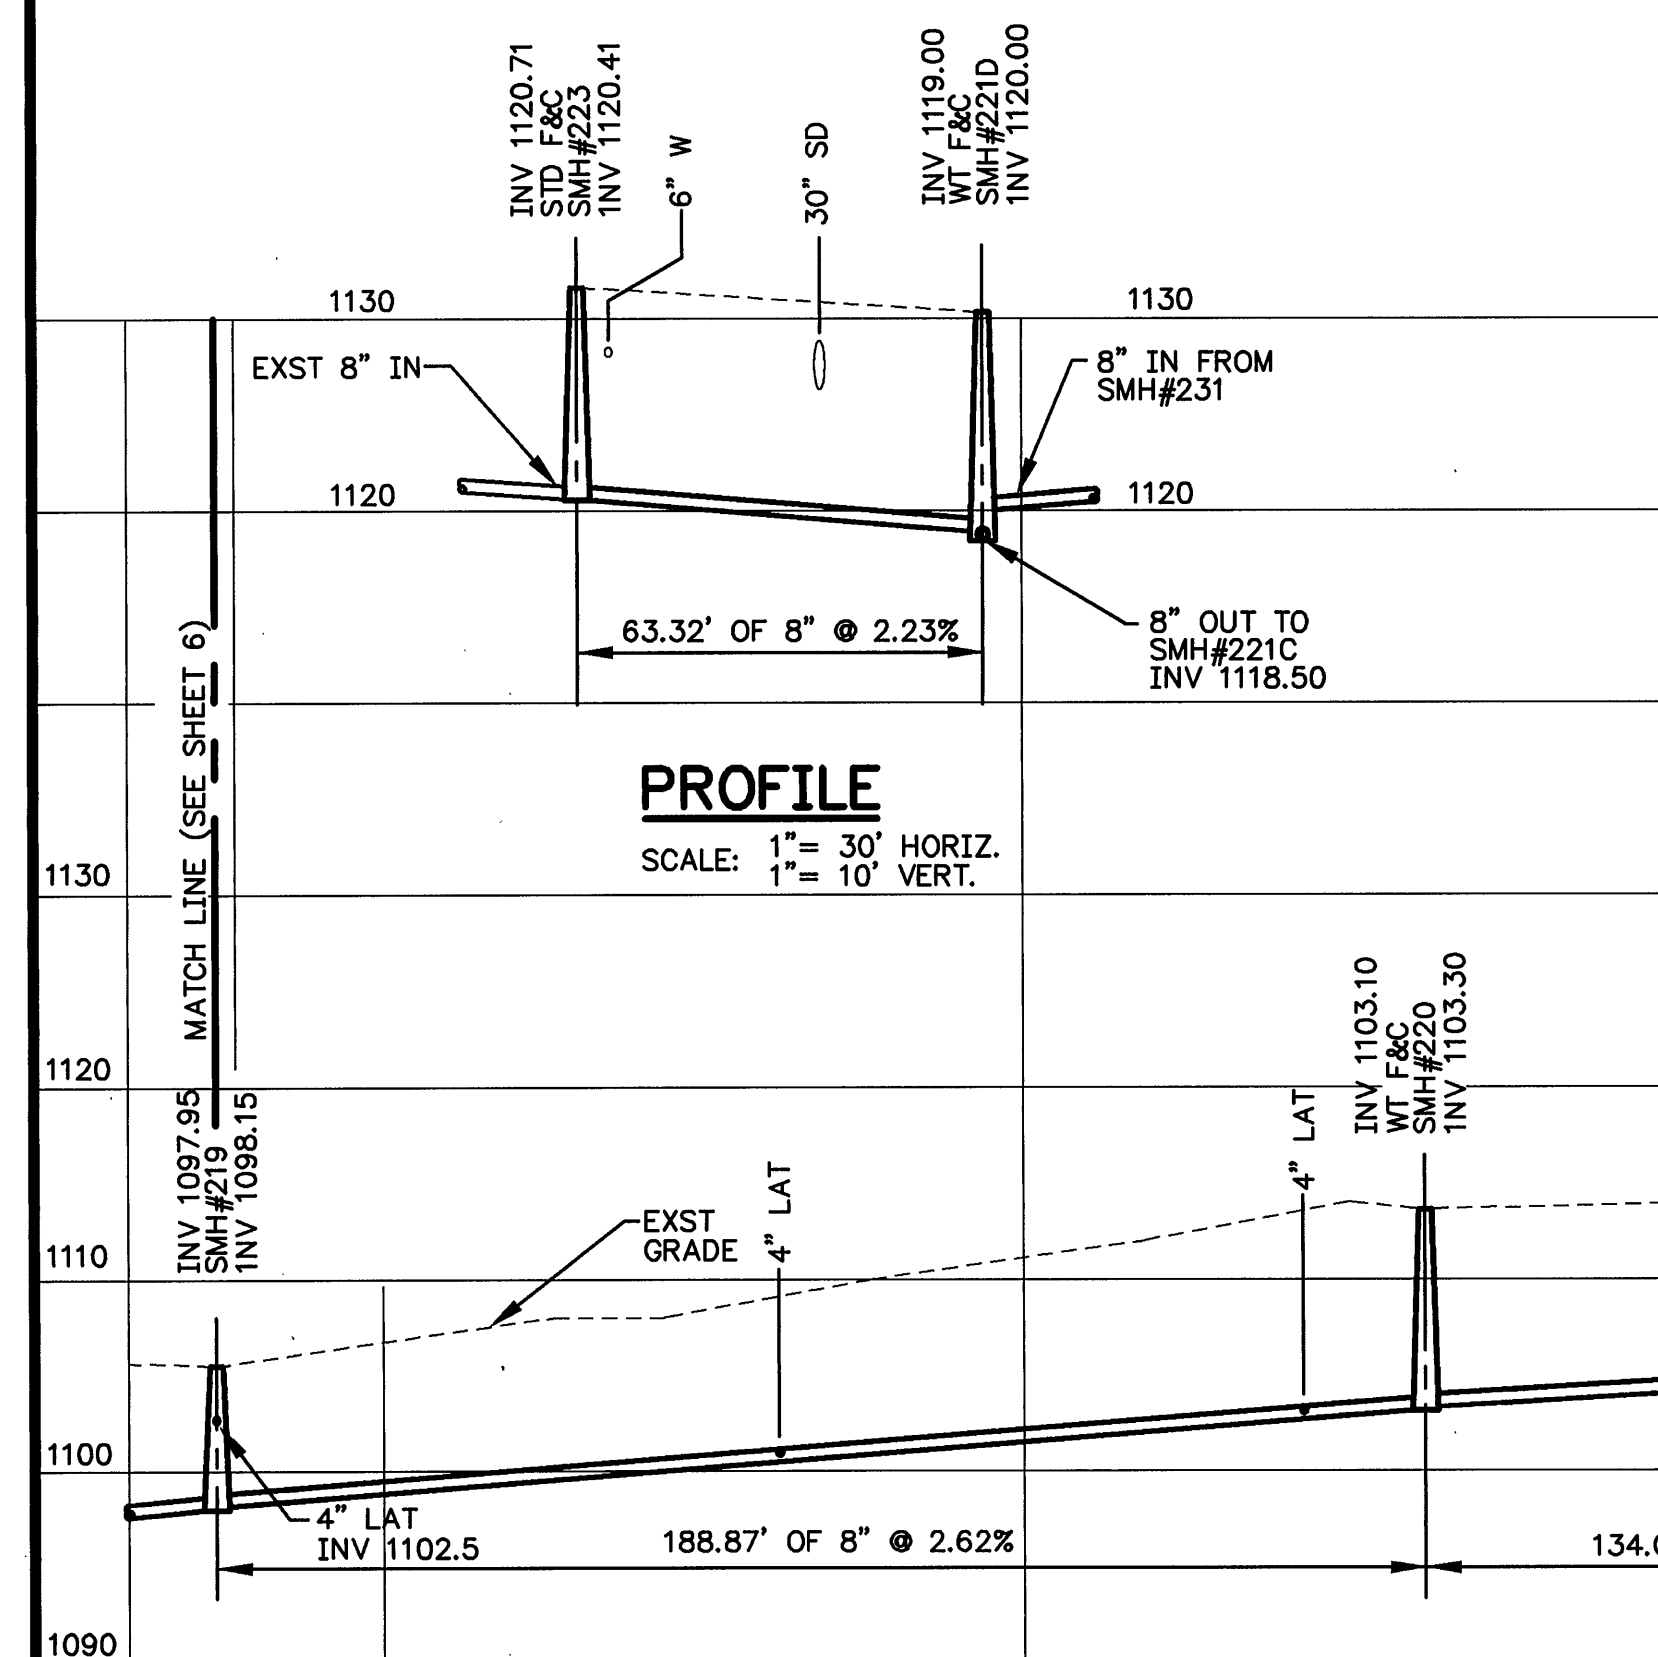

PROFILE
SCALE: 1" = 30' HORIZ.
1" = 10' VERT.

PROFILE
SCALE: 1" = 30' HORIZ.
1" = 10' VERT.

RECORD DRAWING

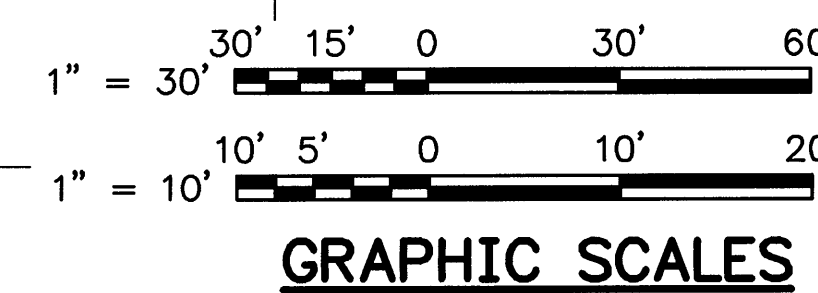

HAYES, SEAY, MATTERN AND MATTERN ARCHITECTS/ENGINEERS/PLANNERS	DESIGNED: DMC		DATE	BY	REVISIONS			SEWER REPLACEMENT PROJECT GC-1 GARDEN CITY SEWERSHED ROANOKE, VIRGINIA			SHEET NO. 7
	DRAWN: DMC		7/3/97	DMC	DESCRIPTION						
	CHECKED: DMH				RECORD DRAWINGS PREPARED FROM DRAWINGS AND INFORMATION PROVIDED BY PRILLAMAN AND PACE, INC.						
	APPROVED: DMH										
			PLAN AND PROFILE			COMM. NO.: 7122B		SCALE: AS SHOWN	DATE: JUNE 19 1996		