


419

418

438

437

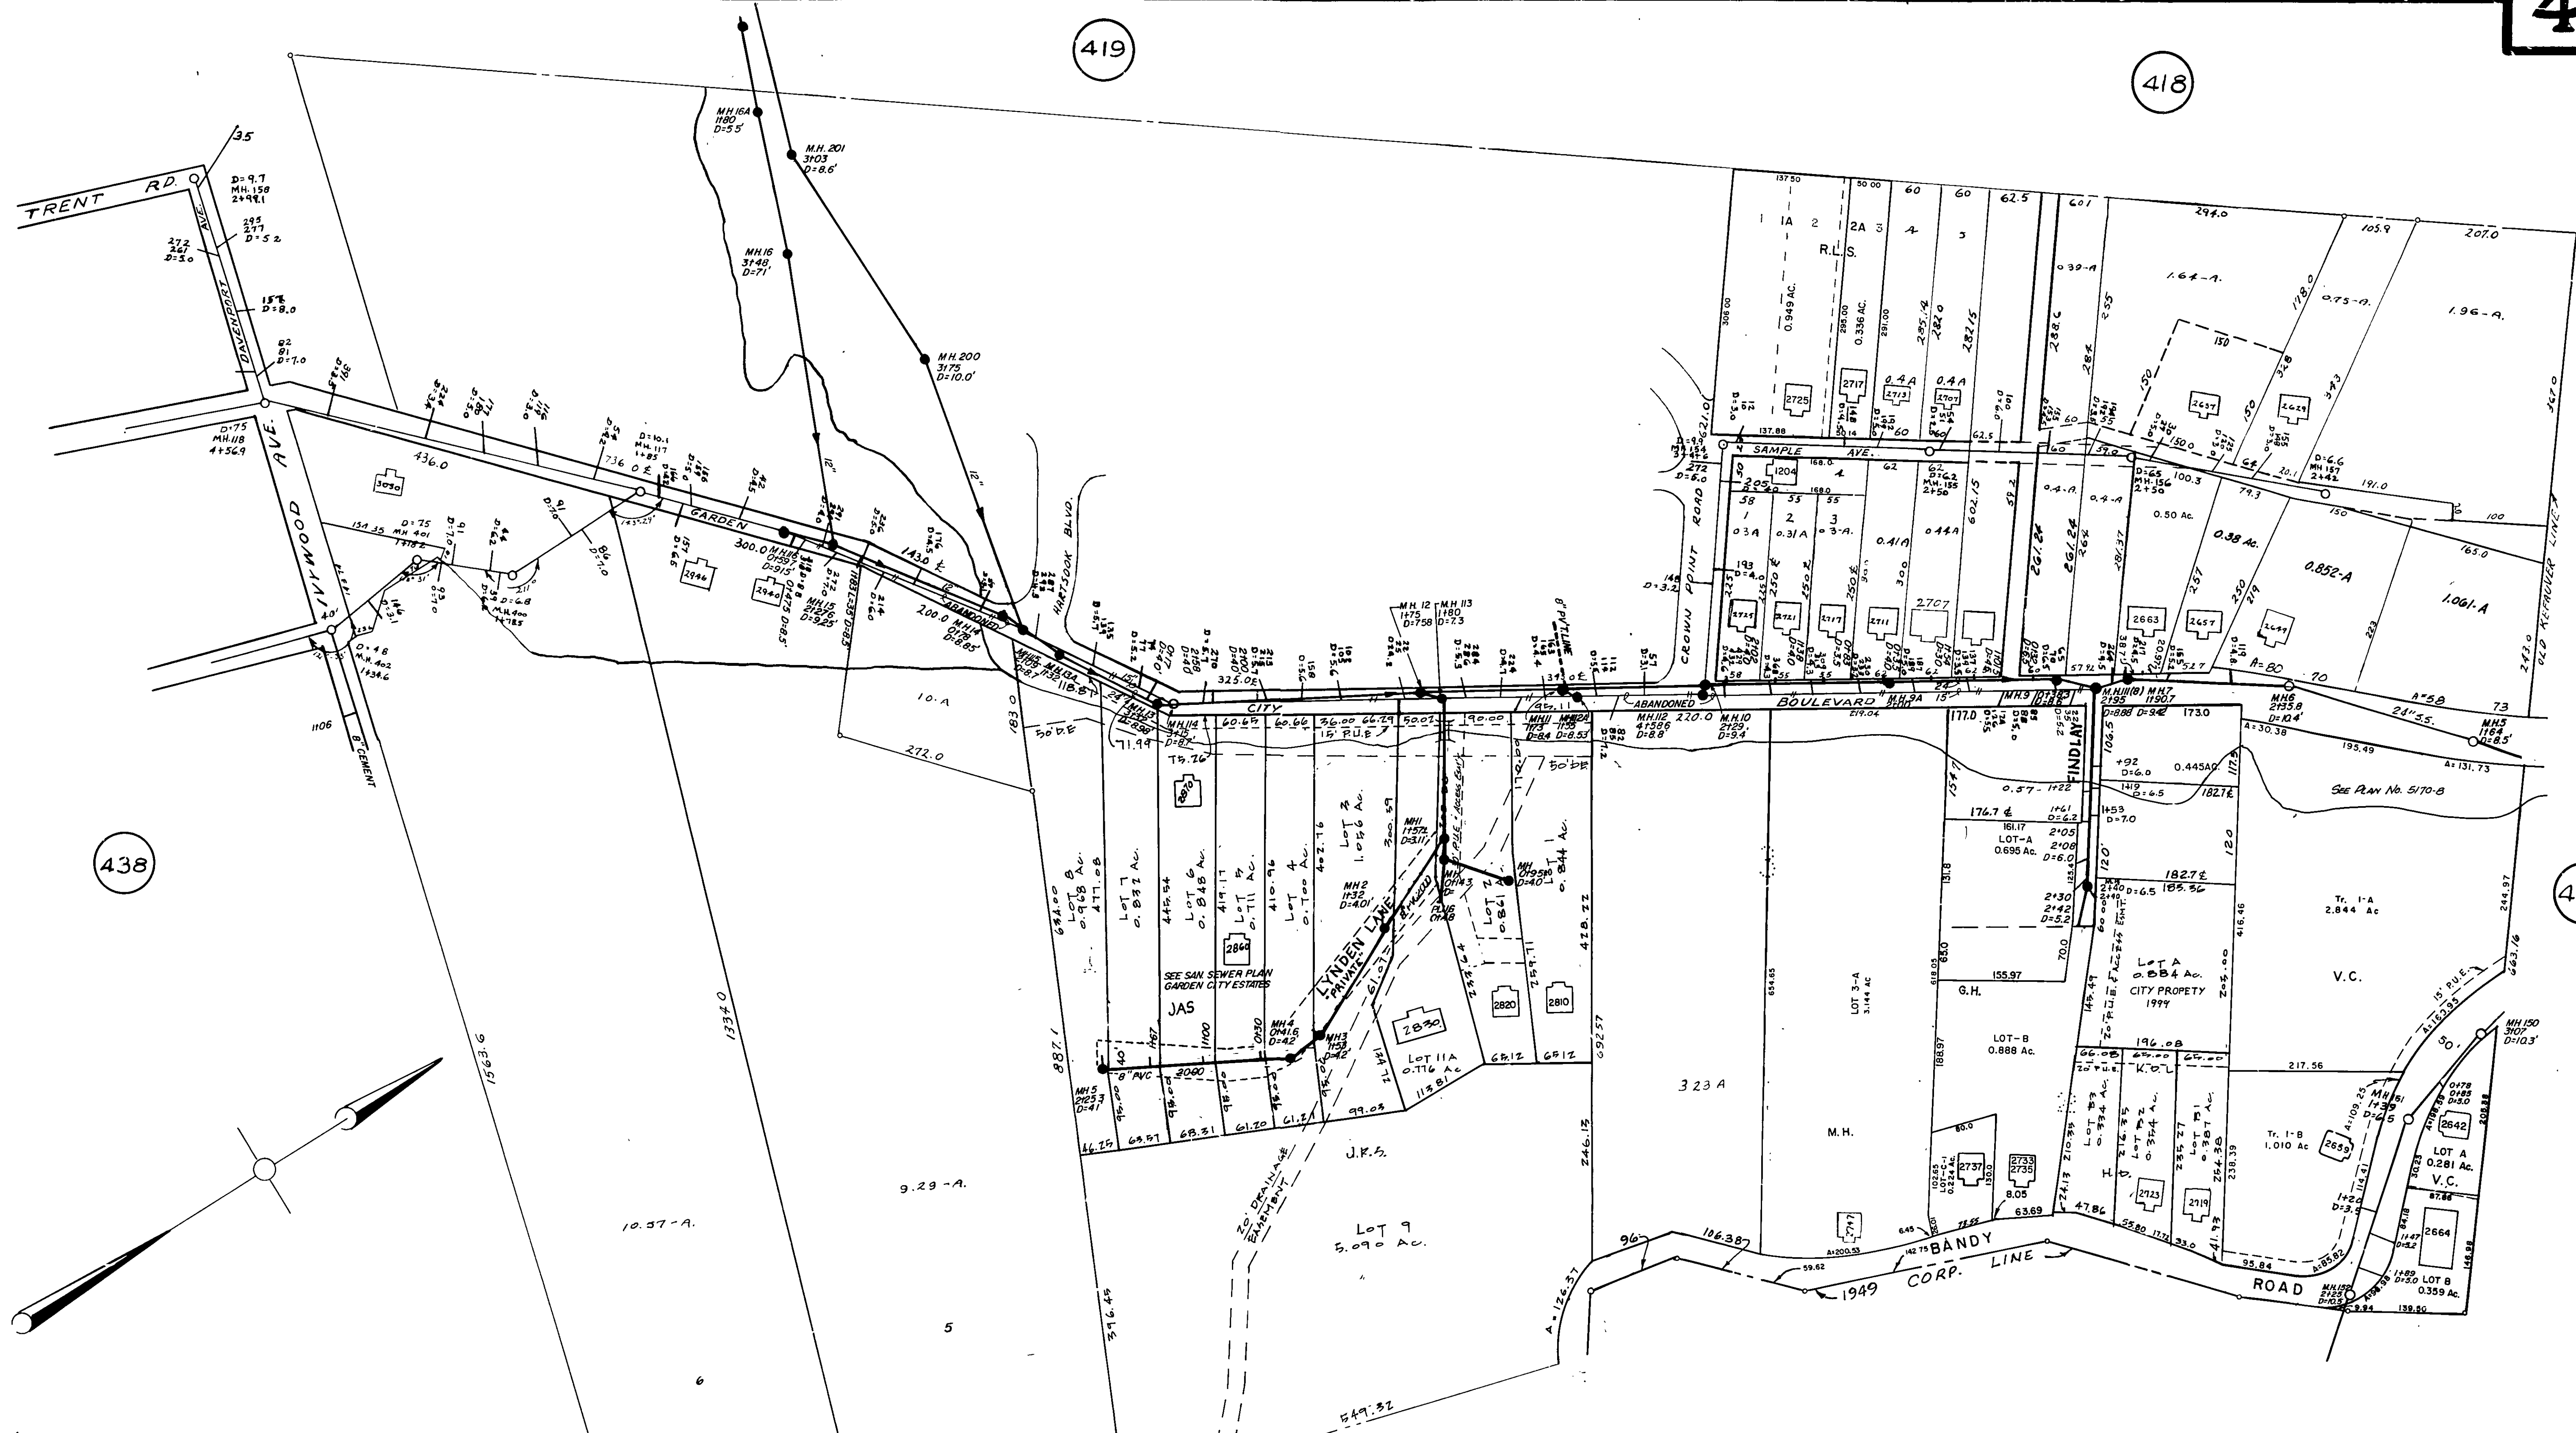

NOTICE:

The location of features and utilities are shown on this map in so far as their existence and location were known at the time of the preparation of this map. Nothing on this map shall be construed as a guarantee that any feature or utility are in the location indicated or that they actually exist.

NOTE:
JOHN GARNAND SR - 3502
S. J. JONES (GARNAND) - 3595
G.H. GARY HALE, M.B.I., Pg. 463
V.C. VERA C. CYPHERS, M.B.I., Pg. 868 & 896
R.L.S. ROBERT L. SIMPSON, M.B.I., Pg. 1254
M.H. McGEORGE-HARRIS-M.B.I., Pg. 1634
J.F.S. JAMES R. & AUGUSTINE D. SMITH-
M.B.I., Pg. 1682, 1710.
K.O.L. KATHERINE O. LEONARD-M.B.I., Pg. 1678.
H.P. HARTMAN DIVISION #2, M.B.I., Pg. 1977.
JAS-JAMES R. & AUGUSTINE D. SMITH-M.B.I., Pg. 2071

CITY OF ROANOKE

SEWER MAP

SCALE : 1" = 100'

Revised	WDC	6-1-52