


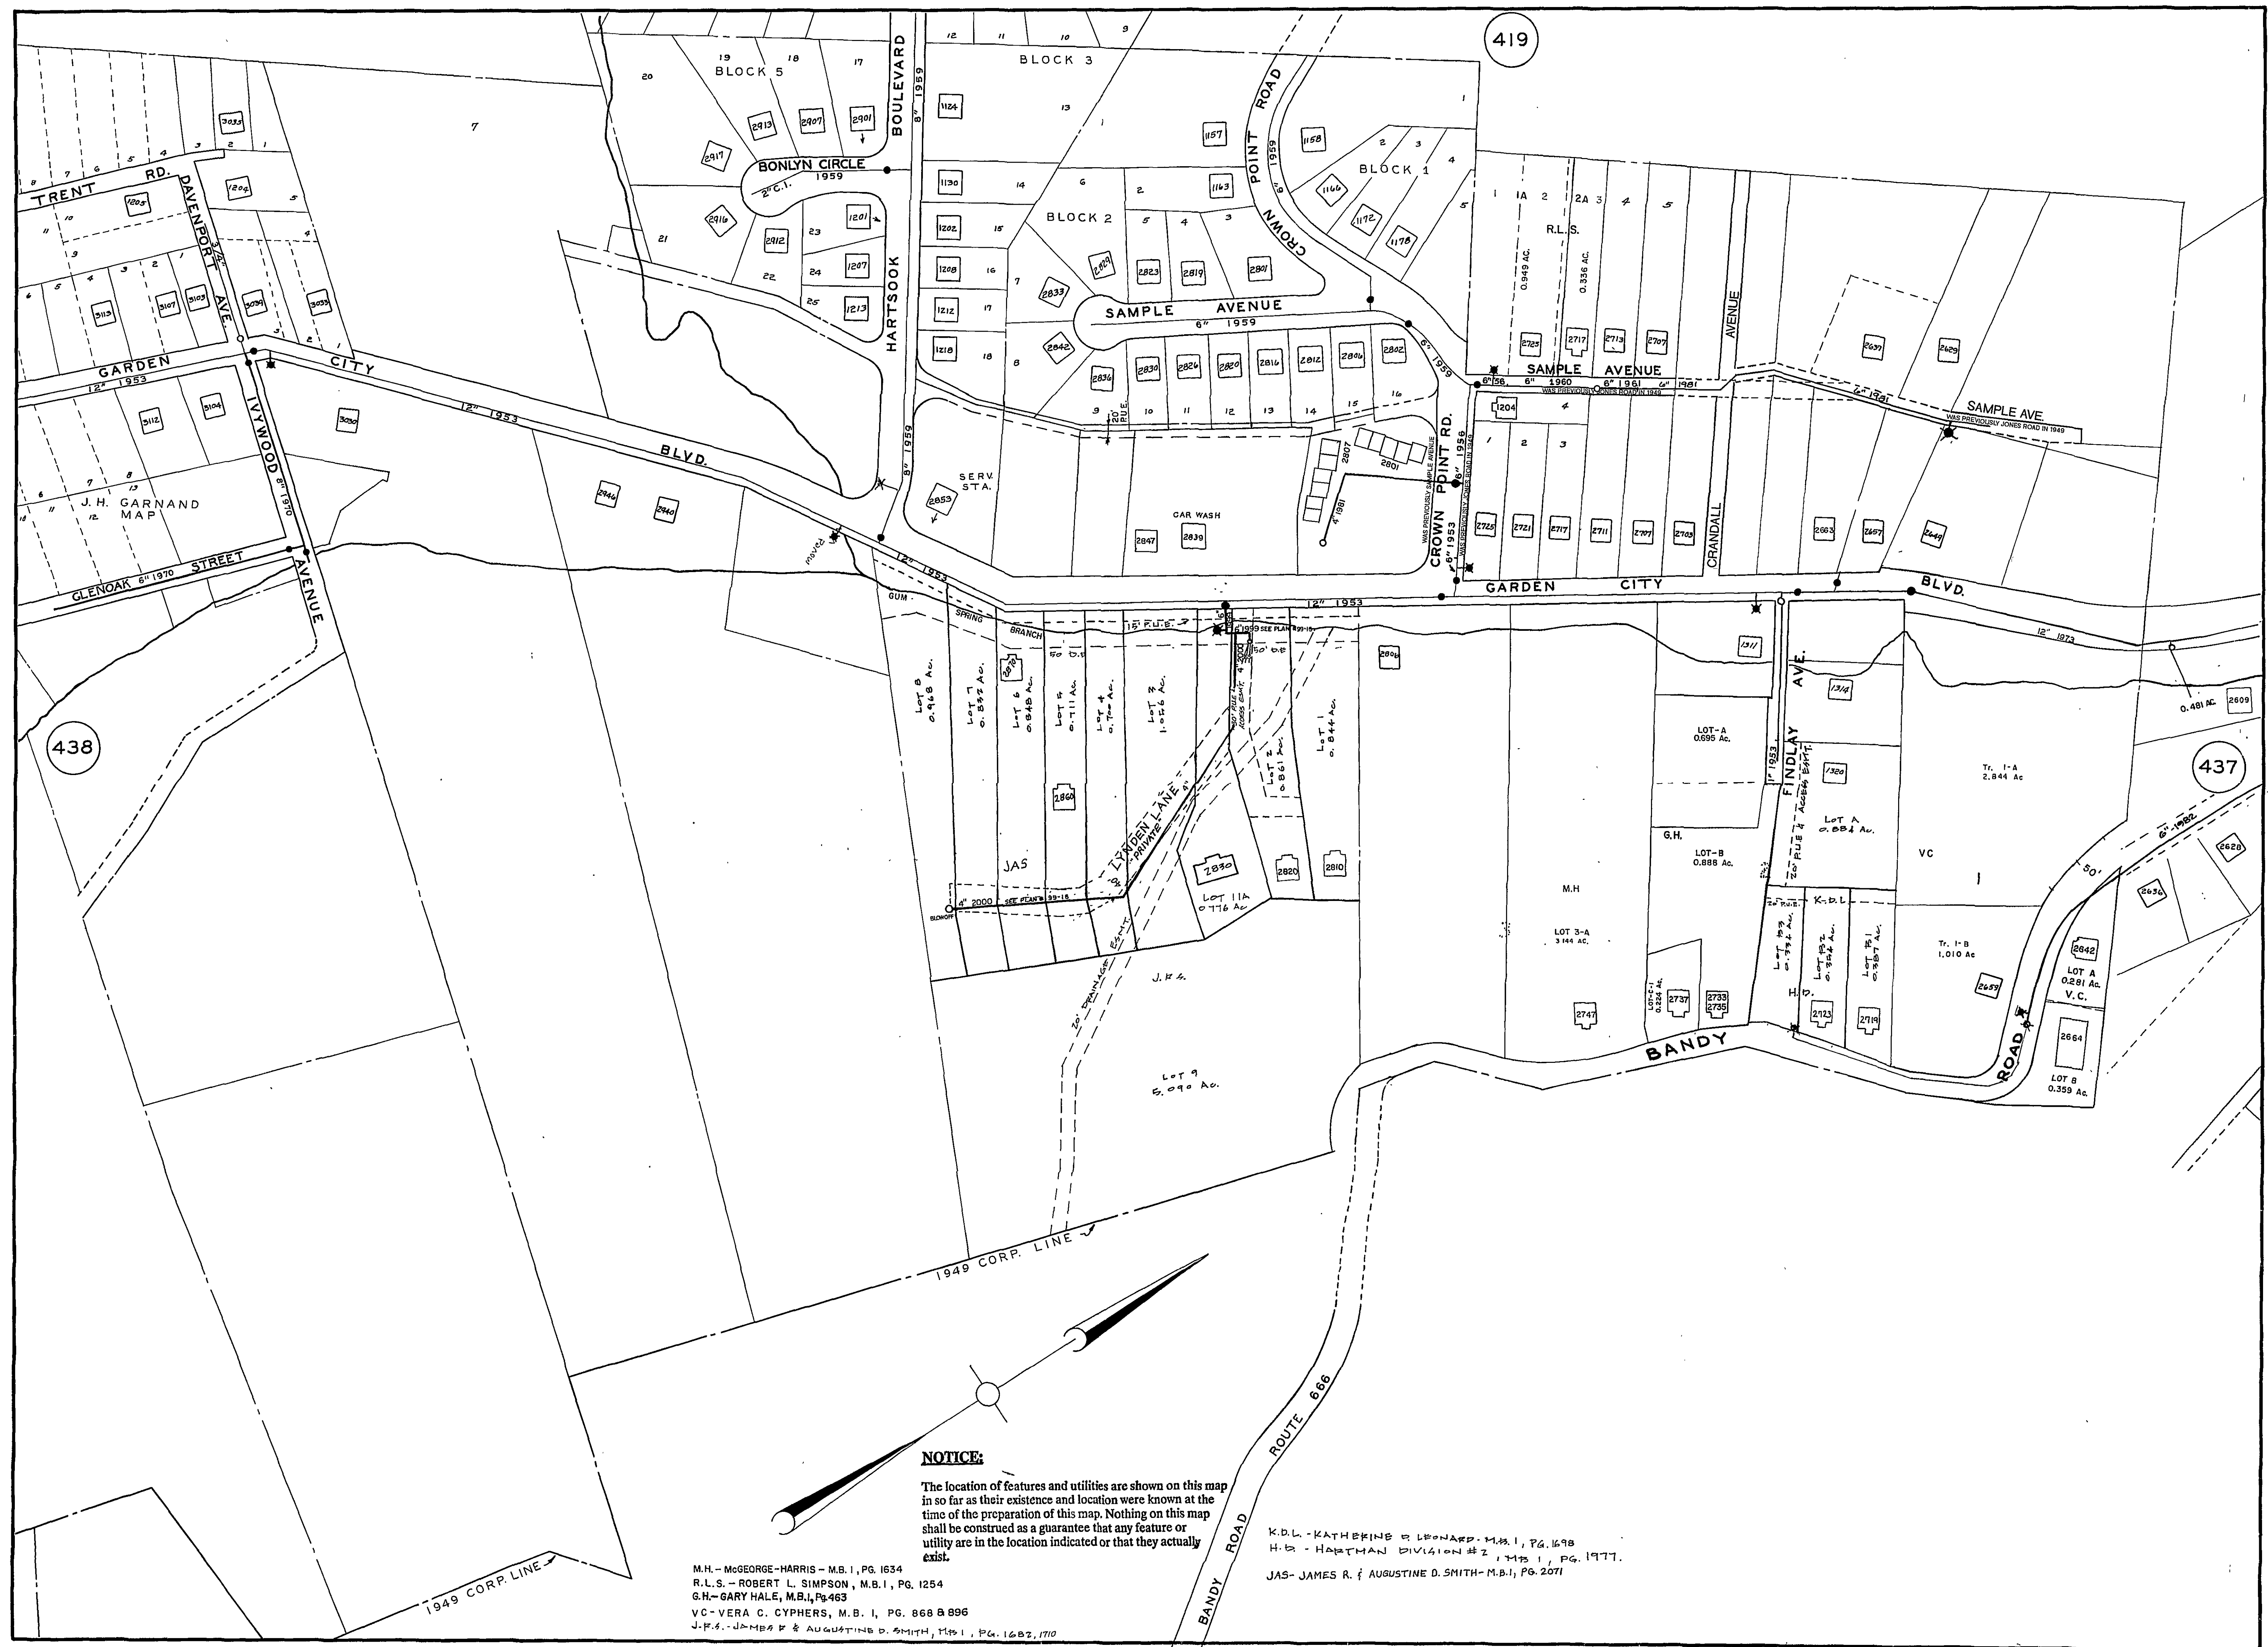

NOTICE:

The location of features and utilities are shown on this map in so far as their existence and location were known at the time of the preparation of this map. Nothing on this map shall be construed as a guarantee that any feature or utility are in the location indicated or that they actually exist.

M.H. - McGEORGE-HARRIS - M.B. 1, PG. 1634
R.L.S. - ROBERT L. SIMPSON, M.B. 1, PG. 1254
G.H. - GARY HALE, M.B. 1, PG. 463
V.C. - VERA C. CYPHERS, M.B. 1, PG. 868 & 896
J.F.S. - JAMES F. & AUGUSTINE D. SMITH, M.B. 1, PG. 1682, 1710

K.D.L. - KATHERINE D. LEONARD, M.B. 1, PG. 1698
H.B. - HARTMAN DIVISION #2, M.B. 1, PG. 1977.
JAS. - JAMES R. & AUGUSTINE D. SMITH - M.B. 1, PG. 2071