

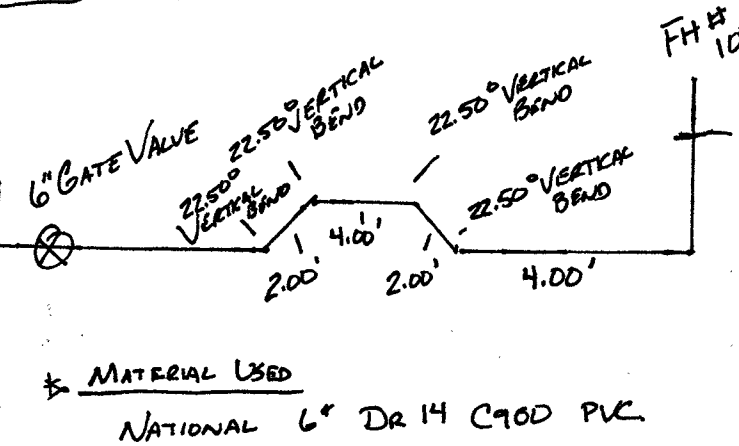


\* WATER RELOCATIONS DONE AS PART OF GARDEN CITY BLVD. WATERLINE REPLACEMENT C.I.P. PROJECT PHASE I. UNLESS OTHERWISE NOTED.


\* 12-21-15 CONTRACTOR RE-LOCATED 6" LINE TO FIRE HYDRANT # 10467.  
AS-BUILT

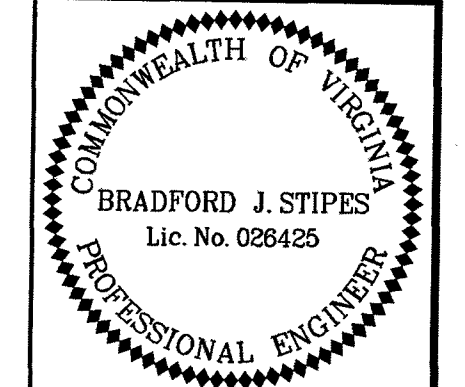


\* MATERIAL USED  
NATIONAL 6" DR 14 C900 PVC

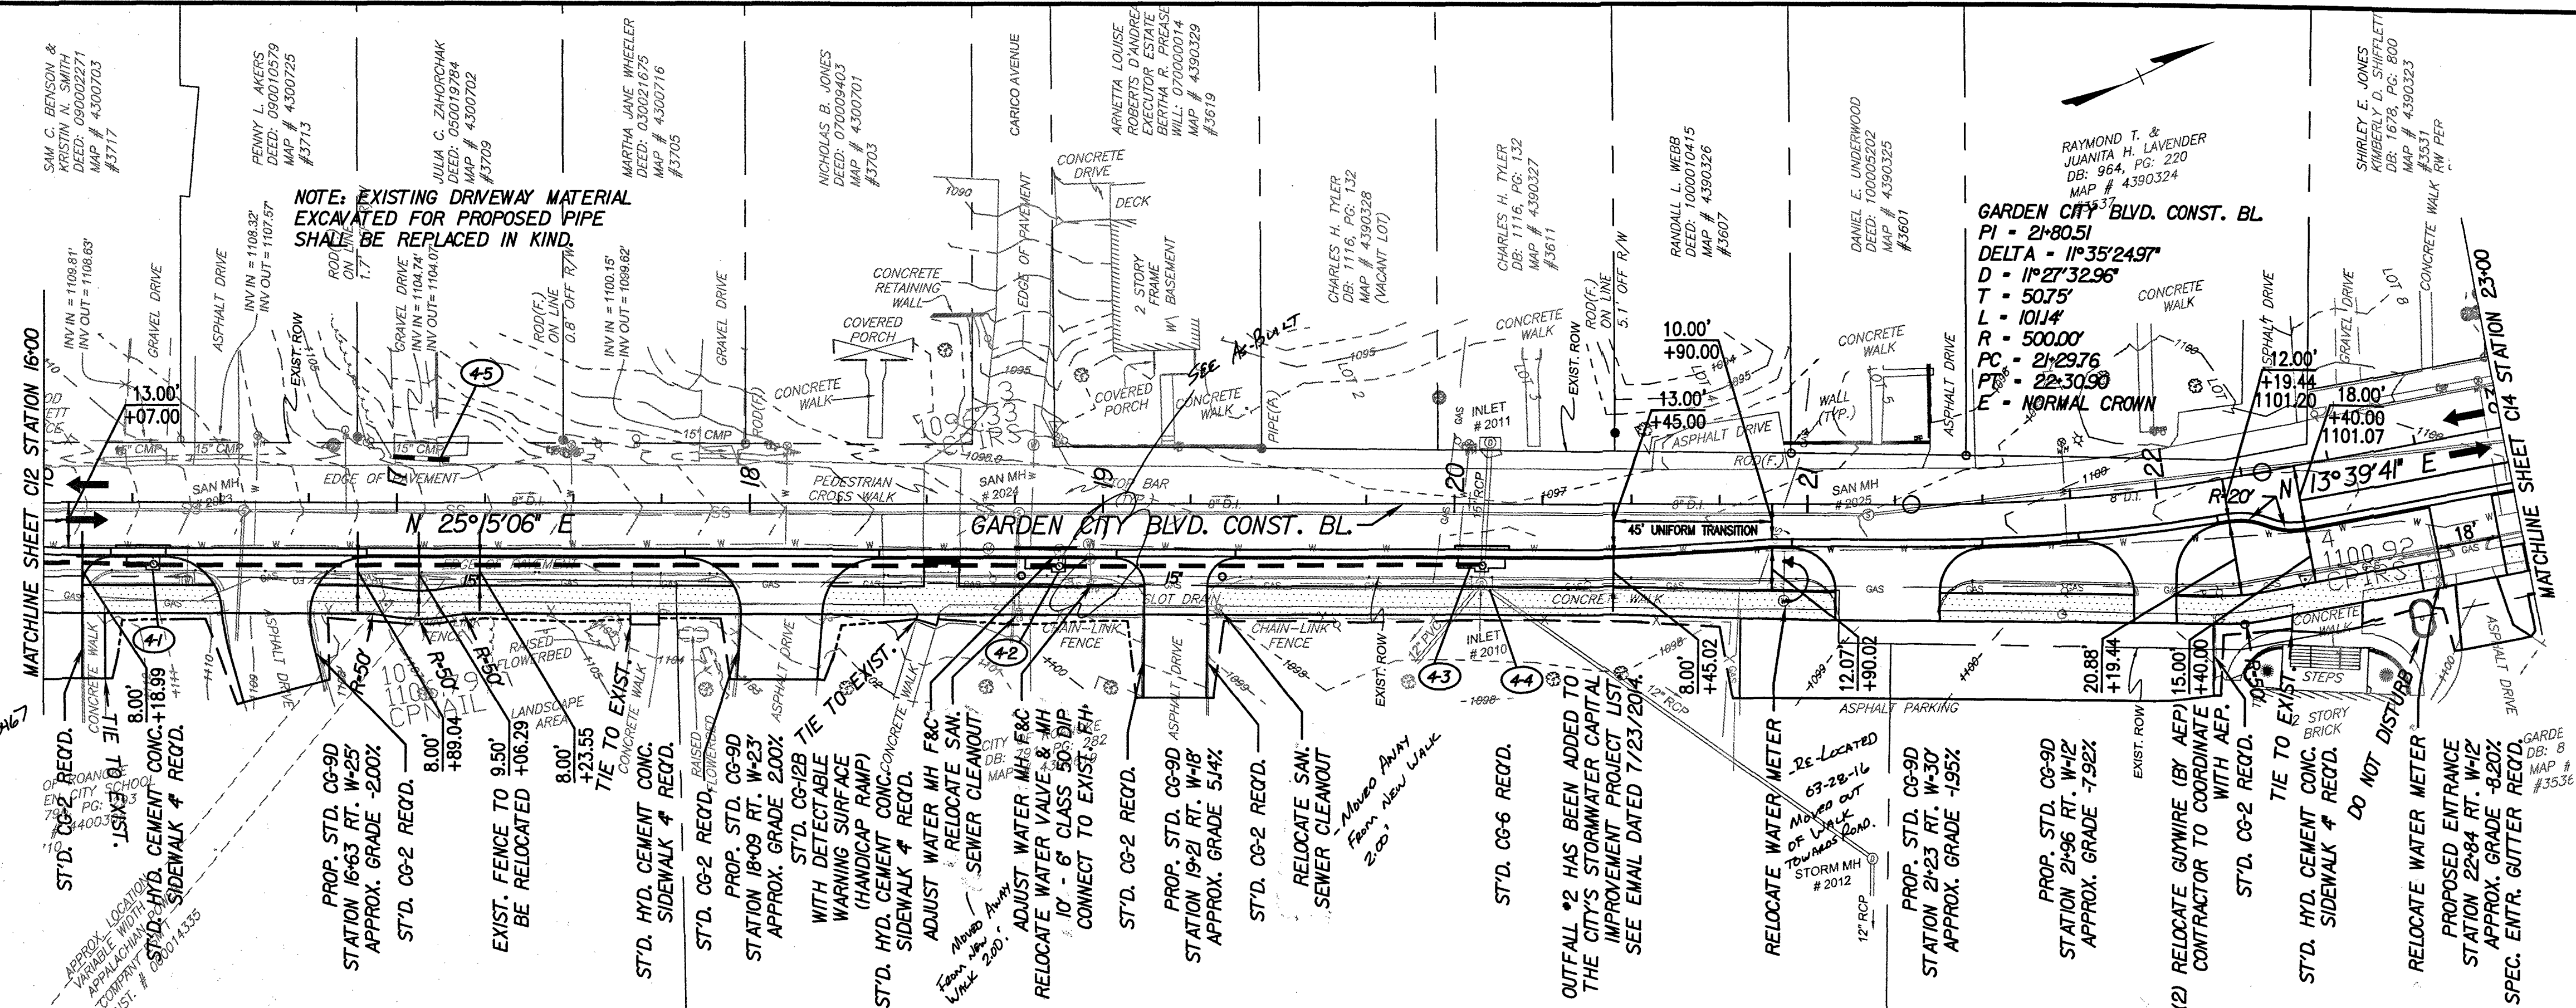



Bradford J Stipes  
2015.02.18 09:27:36 -05'00'  
ROADWAY ENGINEER

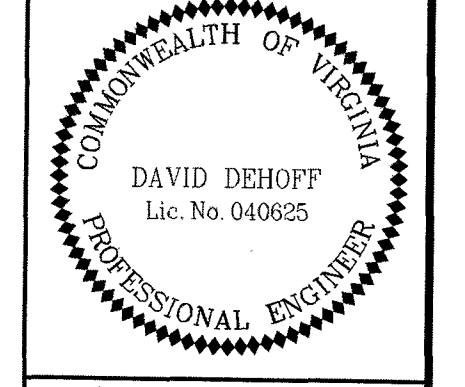

David B Dehoff  
2015.02.18 12:50:20 -05'00'  
DRAINAGE ENGINEER

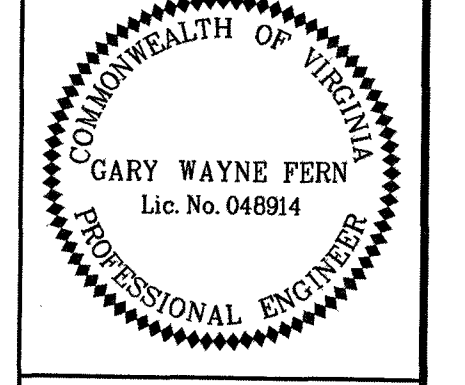

Gary W Fern  
2015.02.16 12:44:59 -05'00'  
UTILITY ENGINEER

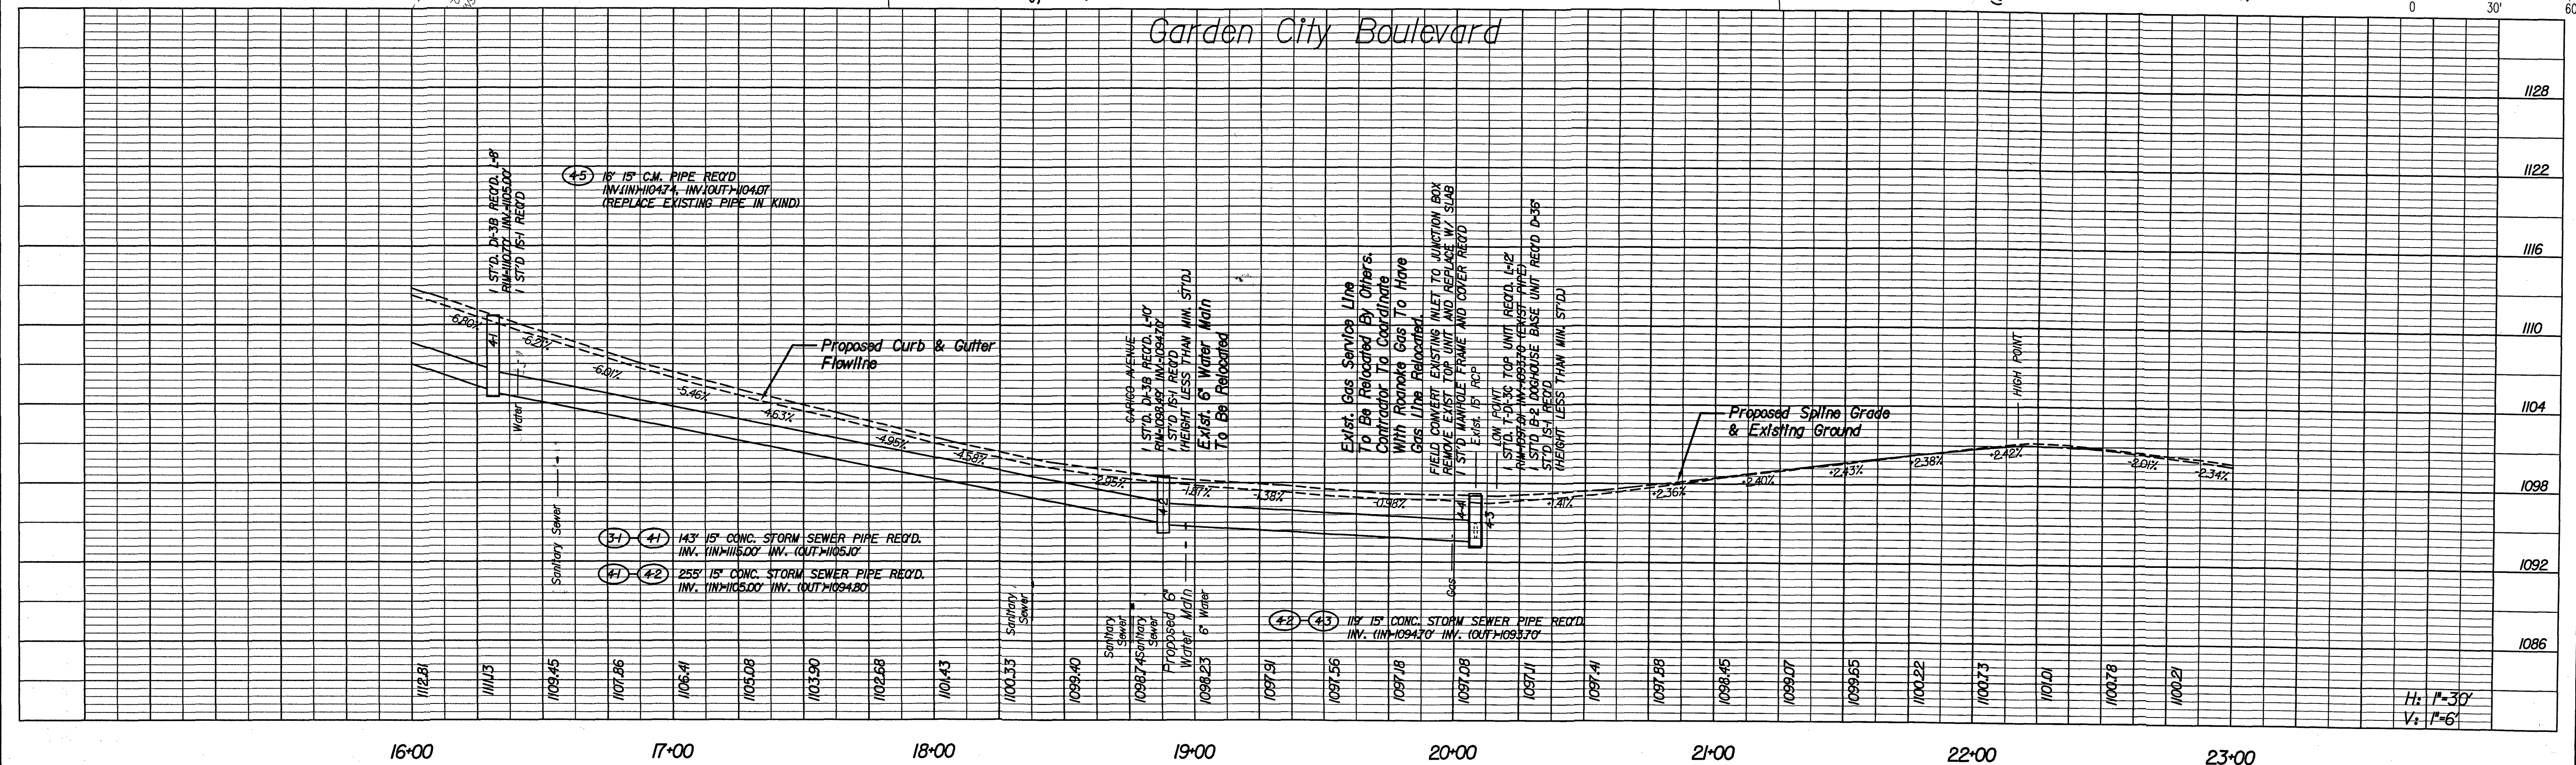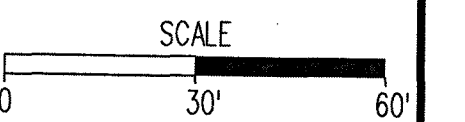

OFFICE OF THE CITY ENGINEER  
215 CHURCH AVENUE, SW  
ROOM 350  
ROANOKE, VIRGINIA 24011-1587  
PHONE: (540) 853-2731  
FAX: (540) 853-1364  
ENGINEER@ROANOKEVA.GOV

--- DENOTES PROPOSED PAVEMENT

**WR&A** WHITMAN, REQUARDT  
& ASSOCIATES, LLP  
1700 KRAFT DRIVE, SUITE 1200  
BLACKSBURG, VA 24060

NOTES: 1. WORK IS TO BE PERFORMED PER THE CITY OF ROANOKE RIGHT OF WAY EXCAVATION AND RESTORATION STANDARDS.

- CONTRACTOR SHALL RELOCATE ALL WATER METERS, VALVE BOXES, AND SANITARY SEWER CLEANOUTS TO A LOCATION OUTSIDE OF THE PROPOSED PAVED WALKWAY AND WITHIN THE RIGHT OF WAY.
- CONTRACTOR SHALL RELOCATE ALL WATER AND SEWER SERVICE LINES AS NEEDED OR SHOWN TO AVOID CONFLICTS WITH PROPOSED IMPROVEMENTS.
- CONSTRUCT ALL DRIVEWAYS AT THE SAME WIDTH AS THE EXISTING DRIVEWAY.
- ALL NEW UTILITIES SHALL BE LOCATED UNDERGROUND IN ACCORDANCE WITH THE CITY CODE SEC. 36.2-610.

SAFE ROUTES TO SCHOOL  
GARDEN CITY BOULEVARD

PLAN & PROFILE VIEW

APPROVED  
AUG 13 2015

Designed: A.J.K./D.B.D.  
Drawn: R.D.W.  
Checked: R.D.P.

DATE  
FEB 2015

SHEET NUMBER  
C13