


"AS-BUILT"
DEVELOPMENT PLANS
FOR
SECTION 1
"THE GARDENS OF COTTON HILL"

SITUATED IN
CAVE SPRING MAGISTERIAL DISTRICT
ROANOKE COUNTY, VIRGINIA

DATE: ~~2 MAY 1994~~
~~REVISED 20 MAY 1994~~

PROPERTY OF
STRAUSS CONSTRUCTION CORPORATION

"AS-BUILT" 11/21/94
NOTE:
1. "AS-BUILT" INFORMATION TAKEN FROM
PLANS FURNISHED BY J.P. TURNER &
BROTHERS, INC., CONTRACTOR.
2. "AS-BUILT" DIMENSIONS SHOWN IN
BRACKETS.

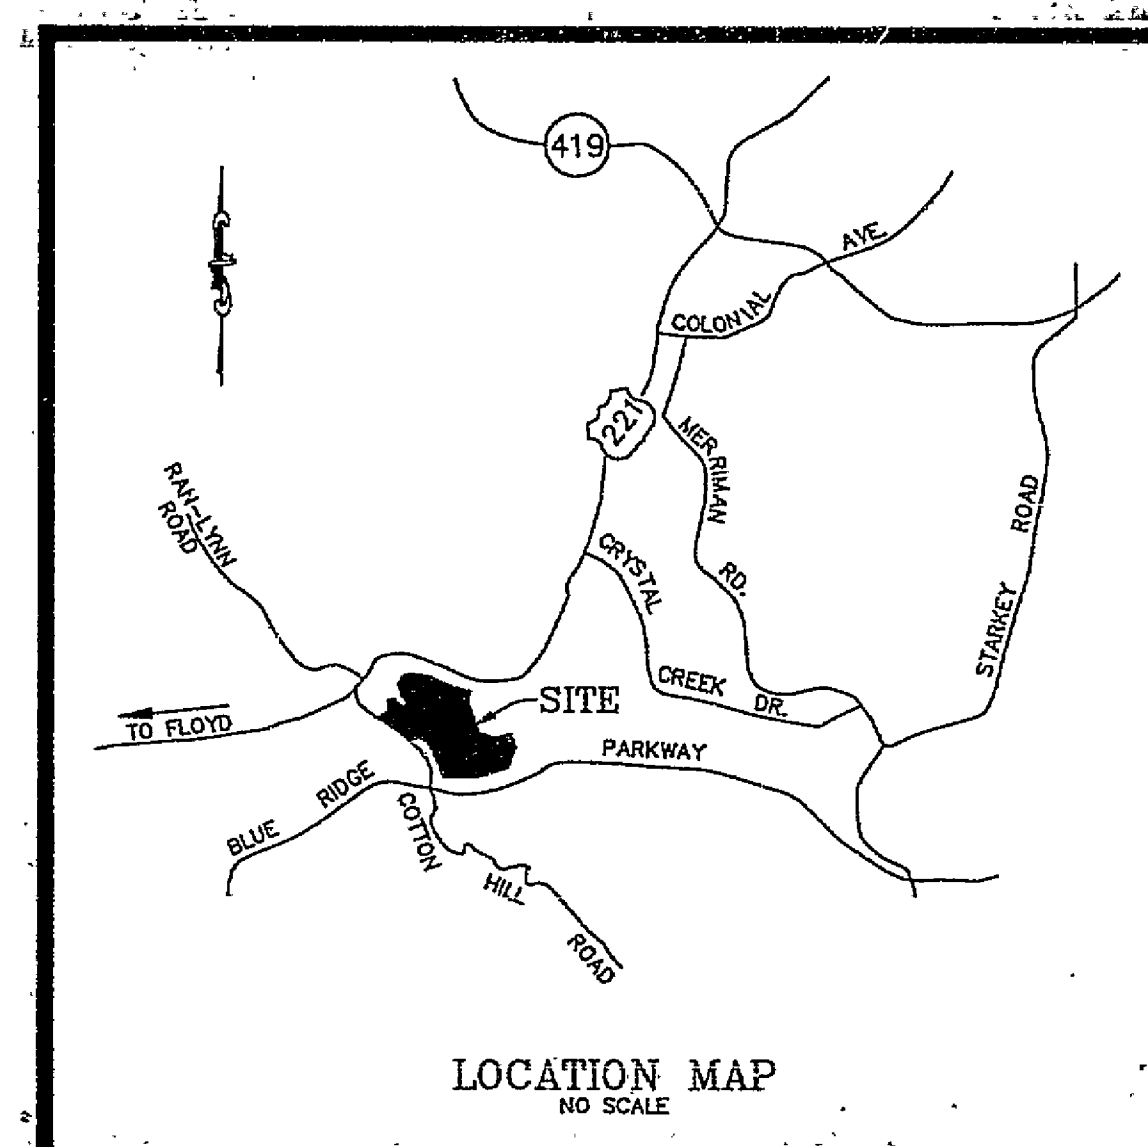

INDEX OF DRAWINGS

SHEET No.	DESCRIPTION
1.	LUMSDEN ASSOCIATES COVER SHEET
2.	ROANOKE CO. STD. COVER SHEET
3.	RECORD MAP
4.	NOTES & DETAILS
5.	DIMENSIONAL LAYOUT & UTILITY PLAN
6.	GRADING & STORM DRAINAGE PLAN
7.	DETENTION POND GRADING PLAN
8.	ROAD PROFILES
9.	SANITARY SEWER & STORM SEWER PROFILES
10.	DETENTION POND DETAILS
11.	EROSION CONTROL PLAN
12.	SEDIMENT BASIN DETAILS (NOT USED)
13.	EROSION CONTROL DETAILS
14.	ROANOKE CO. STD. WATER DETAIL SHEET
15.	ROANOKE CO. STD. SAN. SEWER DETAIL SHEET
16.	SEWER PUMP STATION DETAIL

LUMSDEN ASSOCIATES, P.C.
ENGINEERS-SURVEYORS-PLANNERS
ROANOKE, VIRGINIA

* 78-208 *

RC-5478

SHEET #1 OF 16