
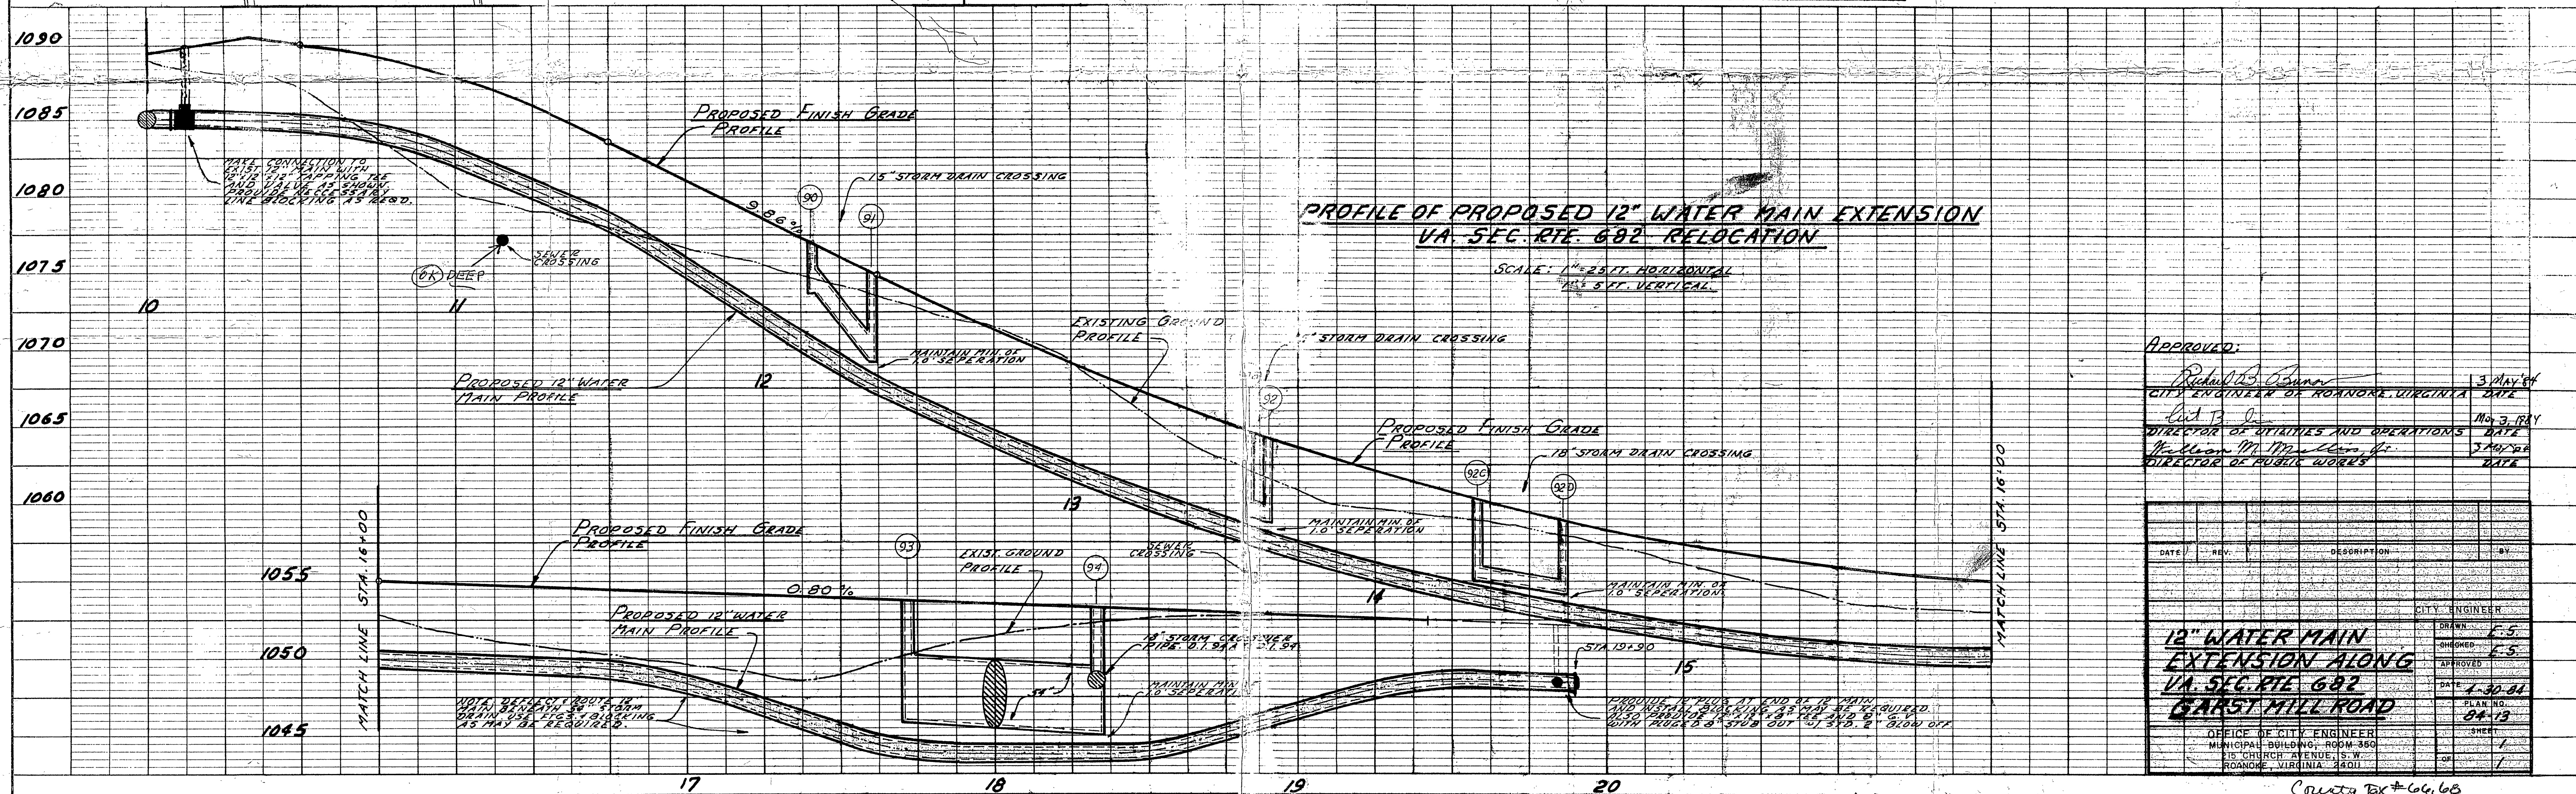


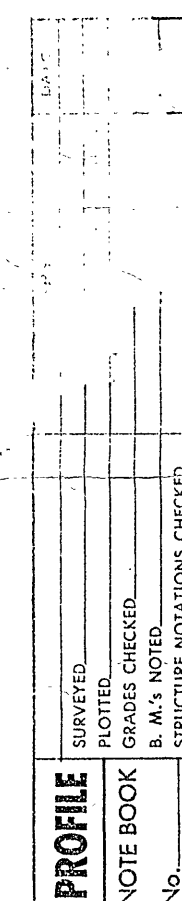

1,023 TOTAL FT. 12" PIPE:
40' FROM 12" V TO 2" V @ END
21' FROM 12" V TO POLE #300-57
48' FROM 2" V TO POLE #300-57

BREXIT → 605-1-605-010 2024-00001

70-2-5110-904-01
605-2-320-183-6004-00621