
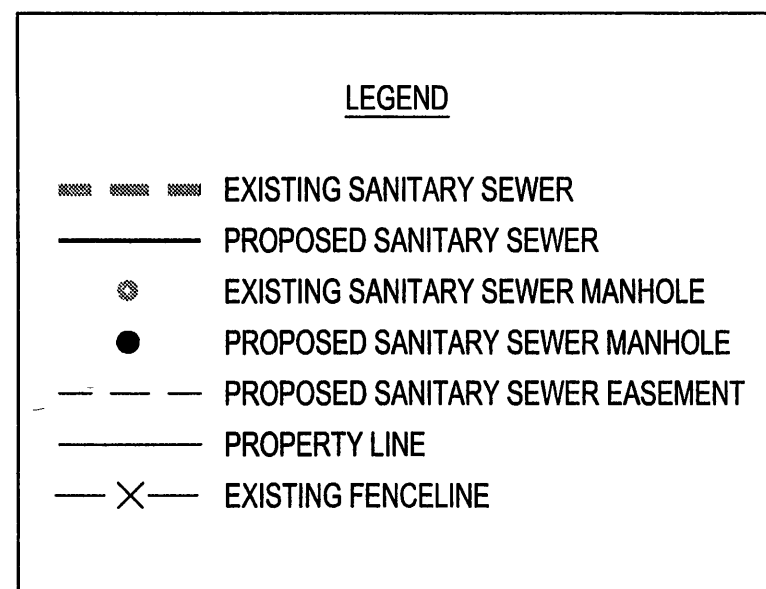
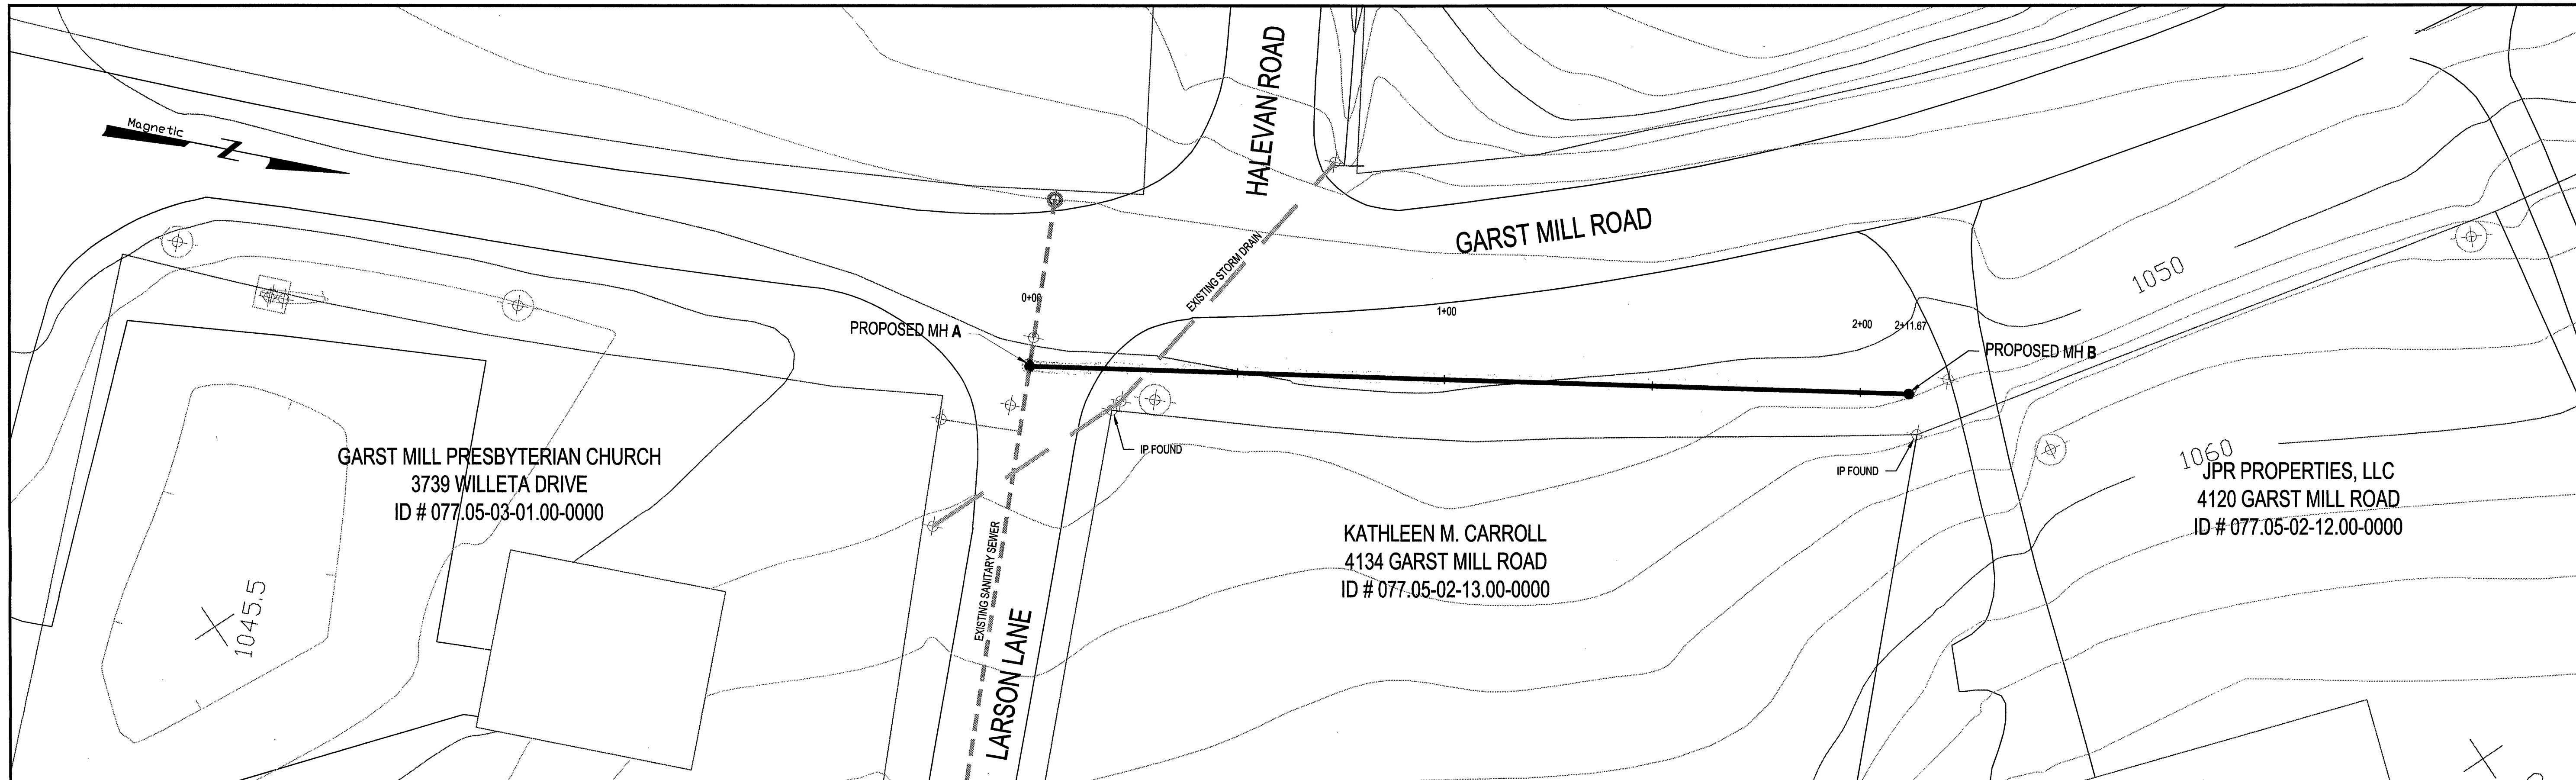


NOTES:

1. ALL WORK SHALL CONFORM TO WESTERN VIRGINIA WATER AUTHORITY DESIGN & CONSTRUCTION STANDARDS LATEST EDITION.

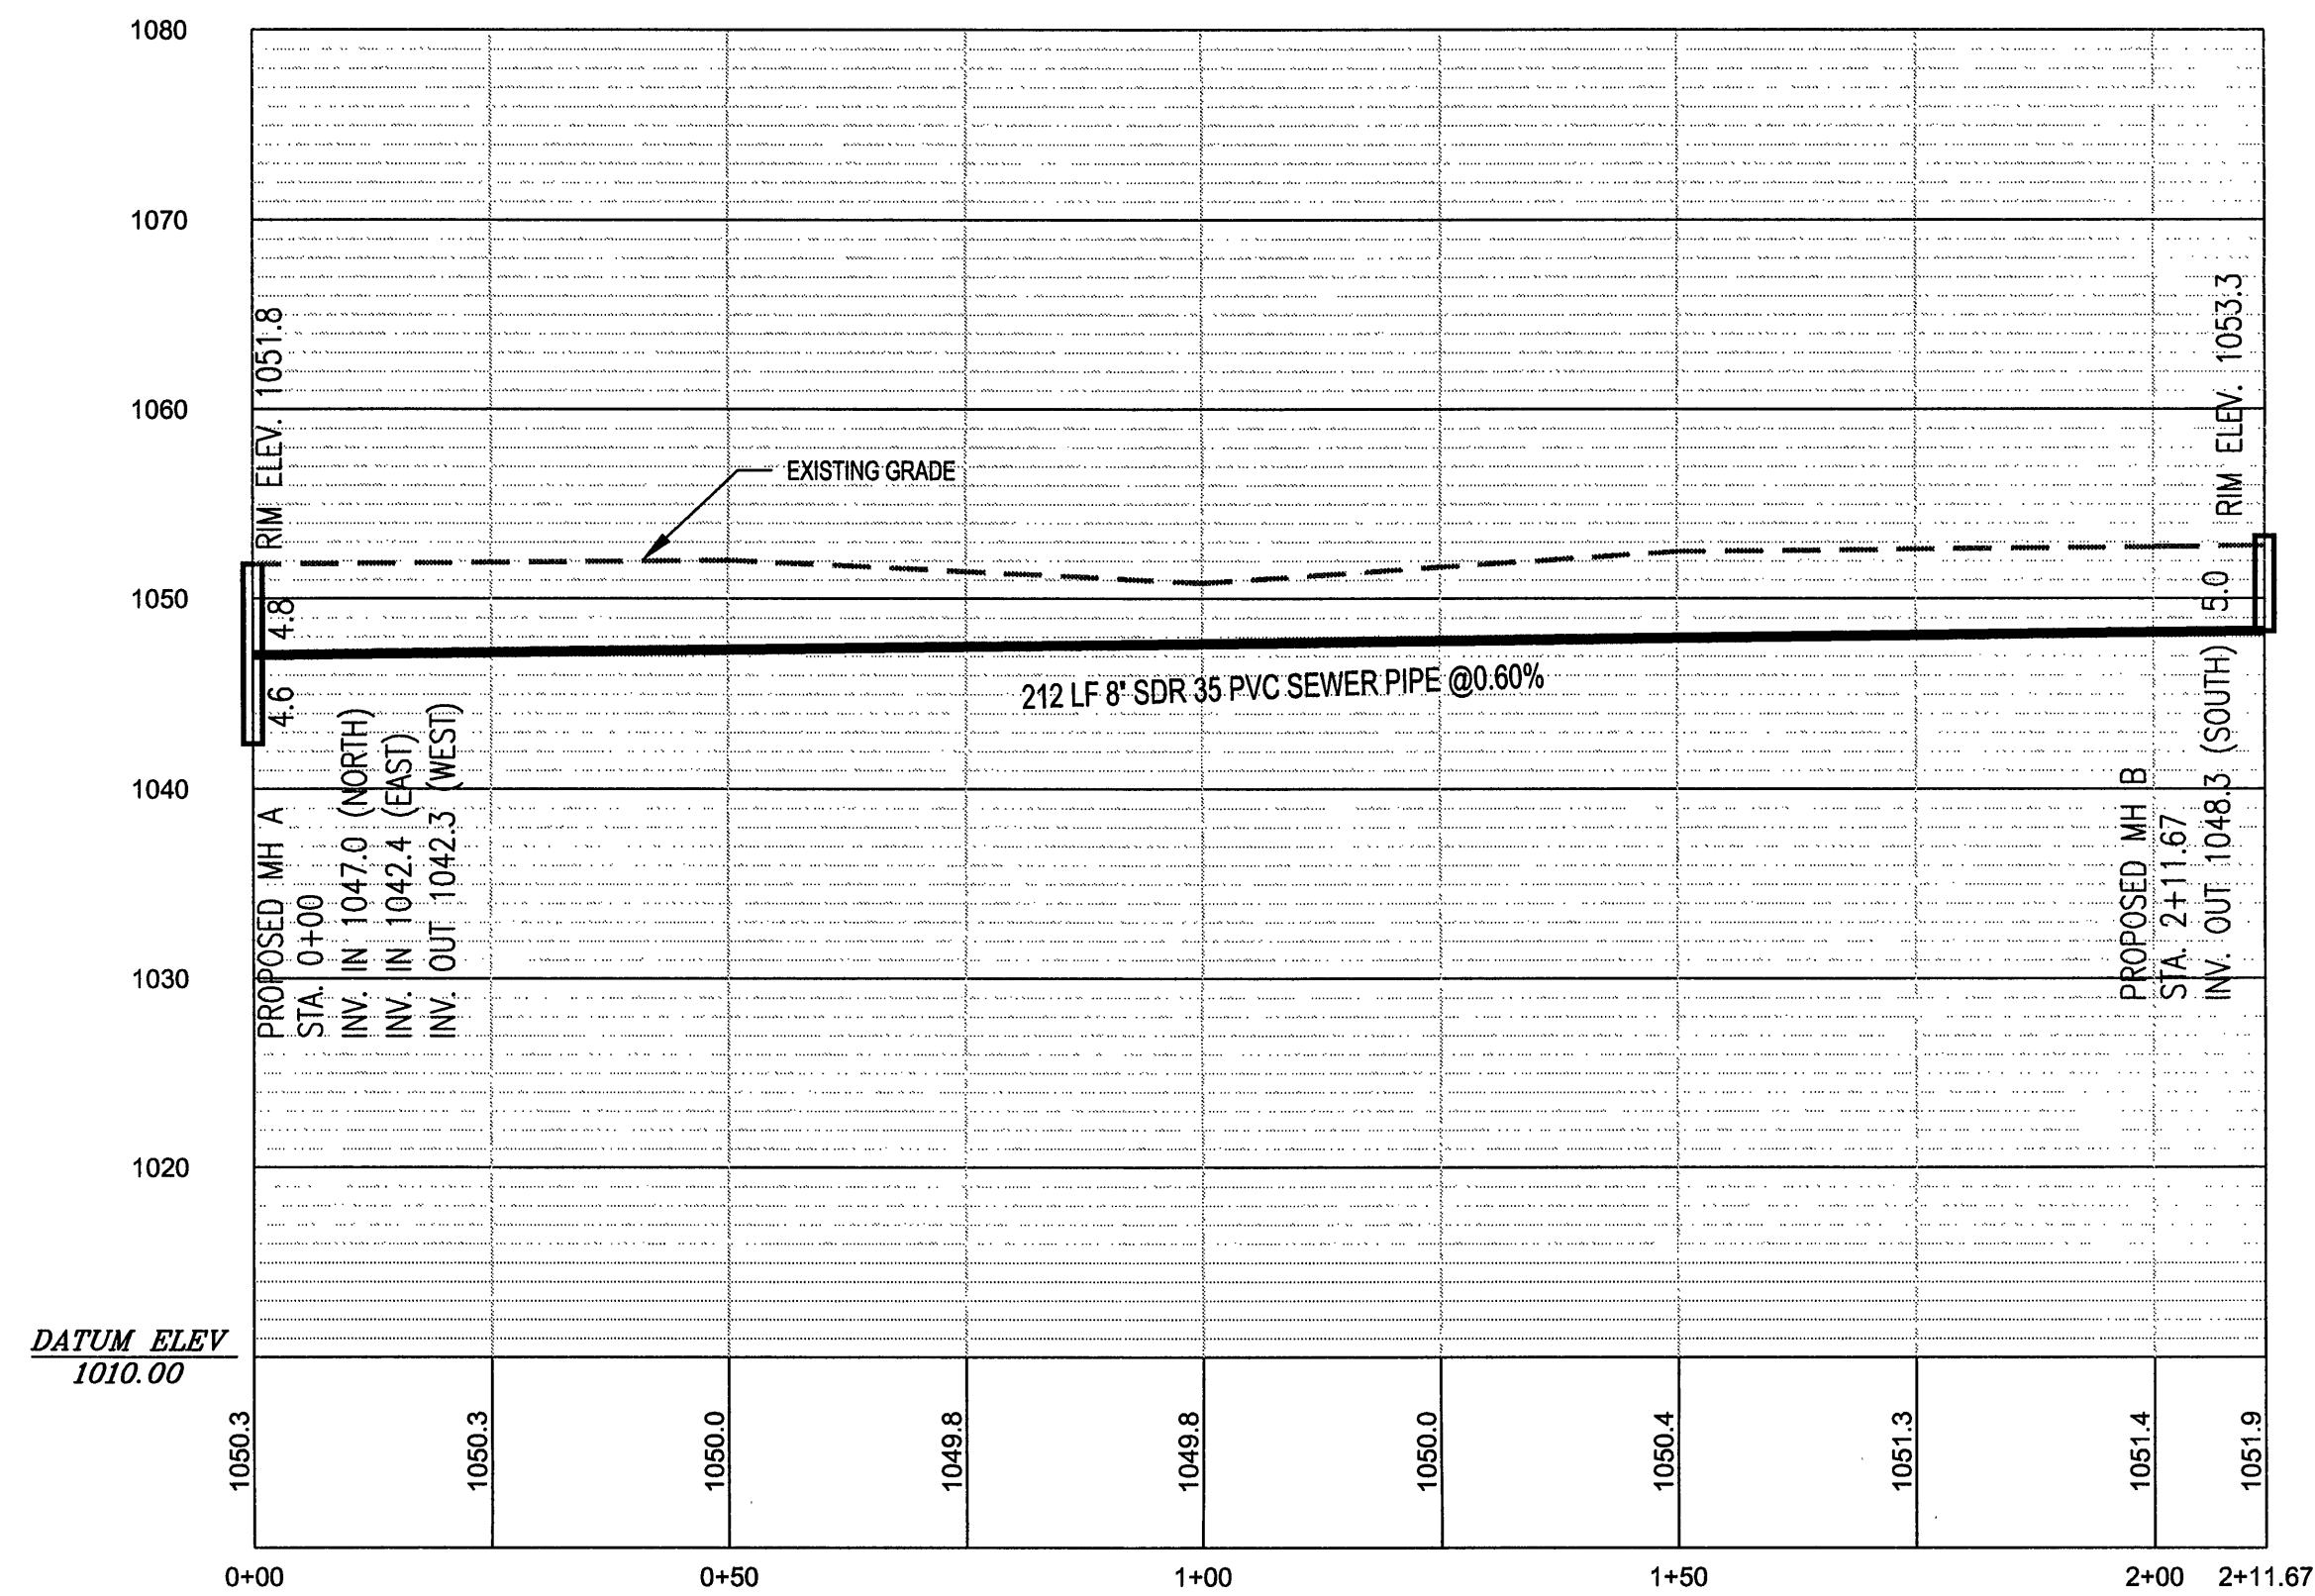

SCALE: HOR. 1 IN. = 20 FT.
VERT. 1 IN. = 10 FT.

Inspector's As-Built

WVWA ID# 80RFTU

WESTERN VIRGINIA
WATER AUTHORITY

ENGINEERING SERVICES

2012 SOUTH JEFFERSON STREET
ROANOKE, VIRGINIA 24014
PHONE: (800) 853-5841

J. GREGORY REED
027721
PROFESSIONAL ENGINEER

**GARST MILL ROAD
PROPOSED SEWER LATERAL EXTENSION**

Designed By: JAD

Drawn By: JAD

Checked By: JGR

Date: 02/11/05

Scale: AS NOTED

Plan #:

Sheet: 1 OF 1