



PLAN	DATE	BY	CHKD	APPD
SAVED				
NOTED				
NOTE BOOK				
No.				

PROFILE	DATE	BY	CHKD	APPD
SAVED				
NOTED				
NOTE BOOK				
No.				

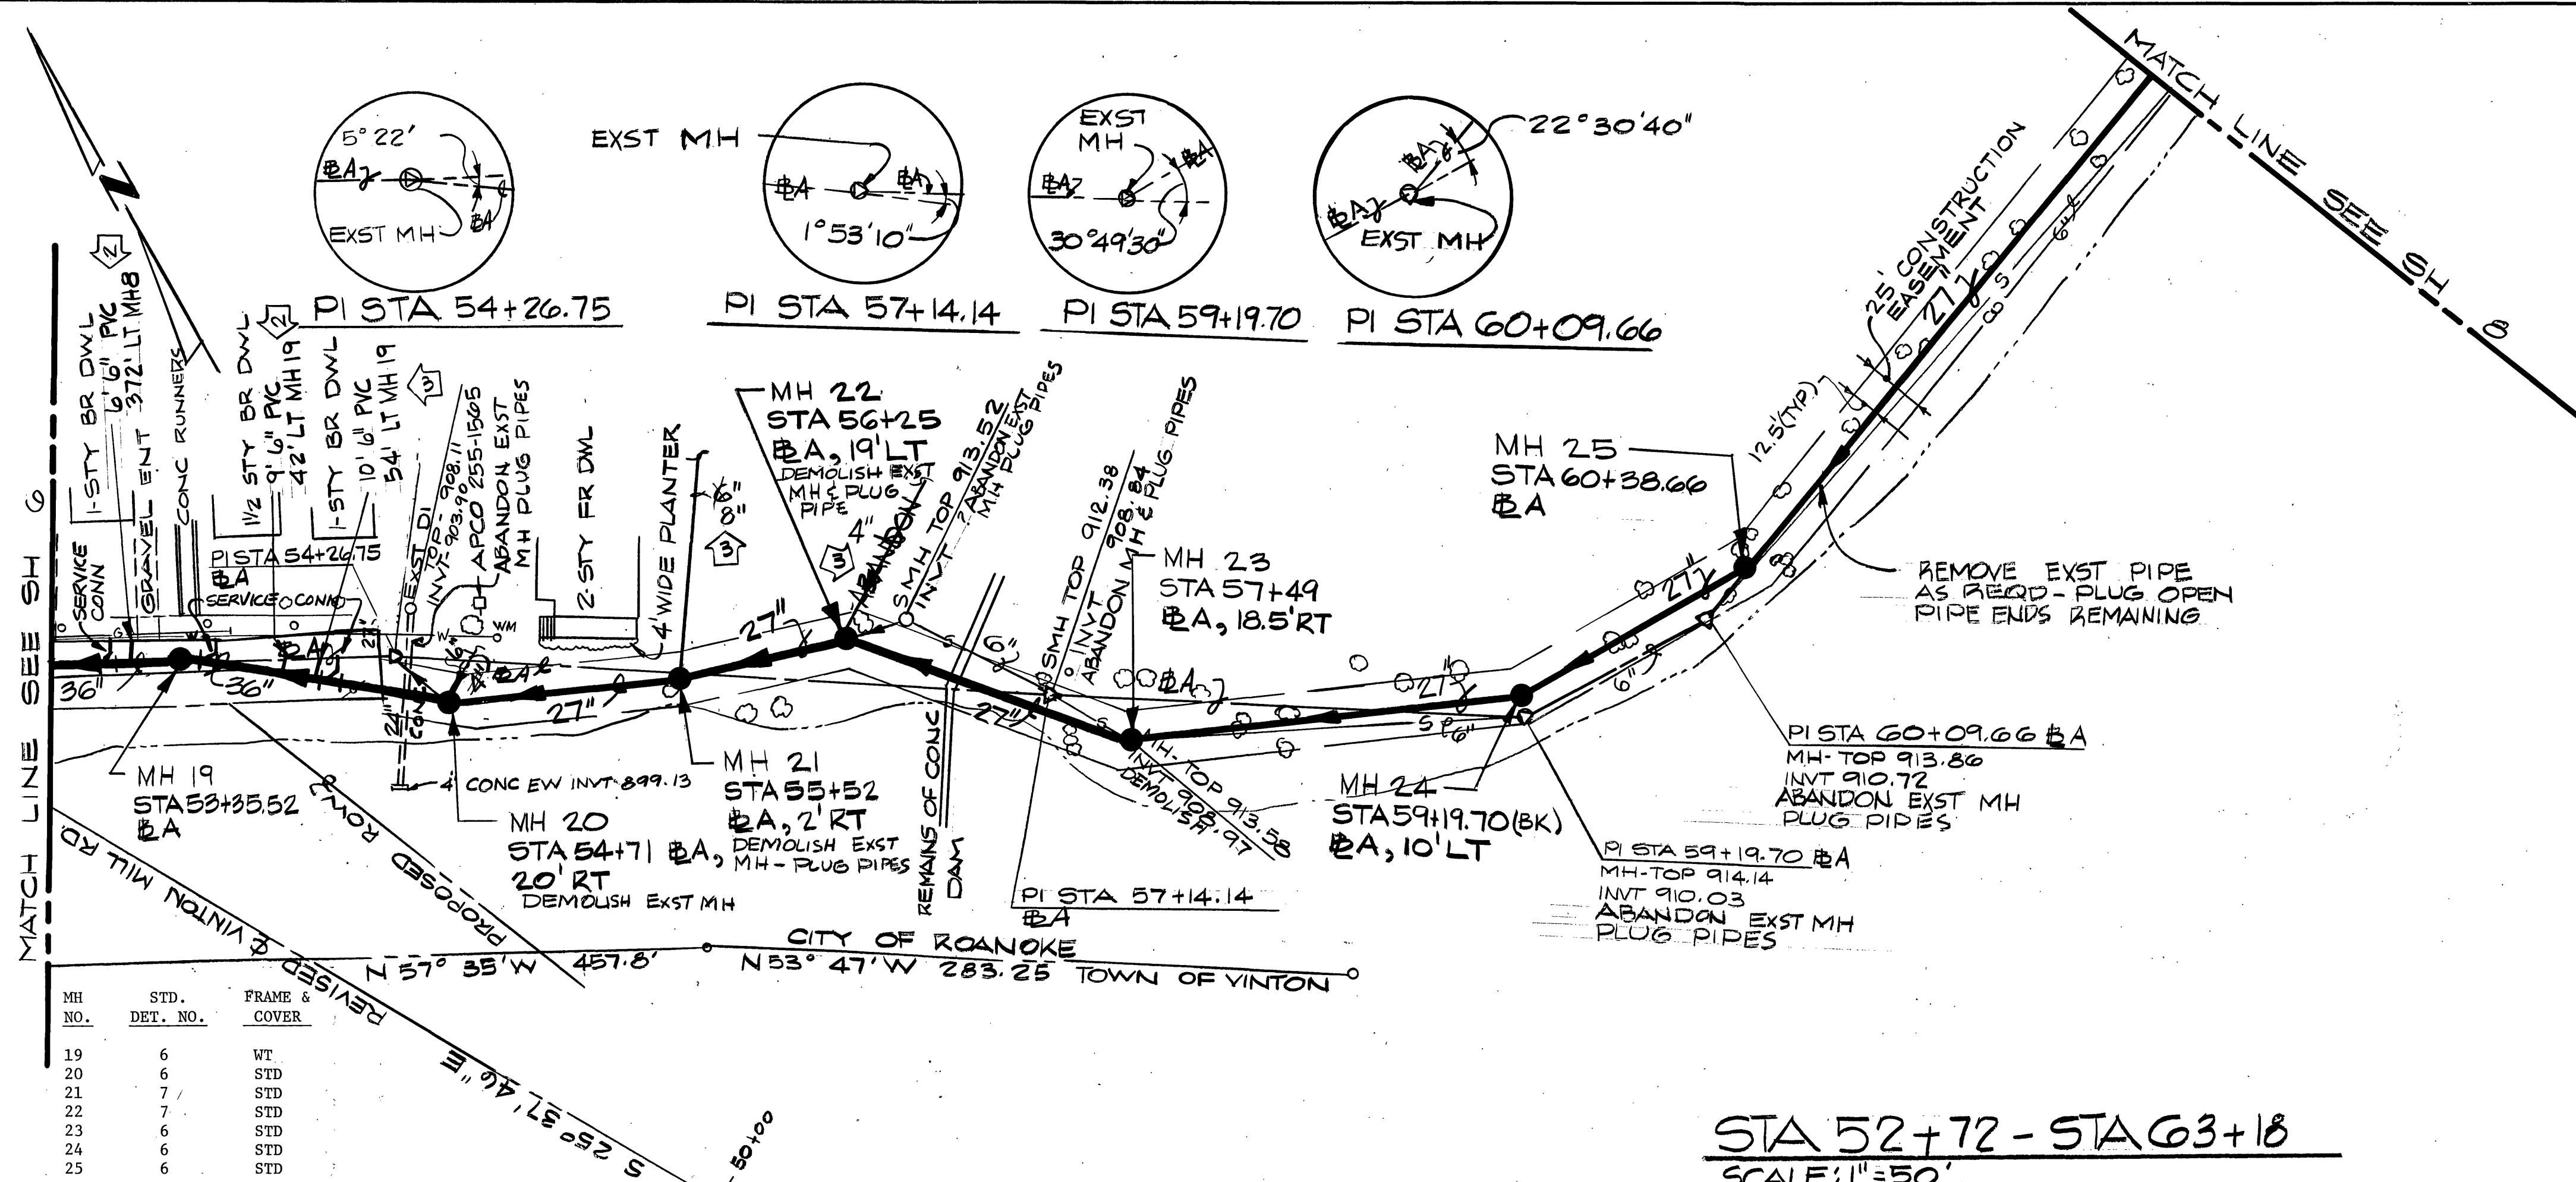

NOTES:
(1) SERVICE CONNECTIONS SHOWN ARE BASED ON AVAILABLE RECORDS - EXACT NUMBER AND THEIR LOCATIONS SHALL BE FIELD VERIFIED

STA 52+72 - STA 63+18
SCALE: 1" = 50'

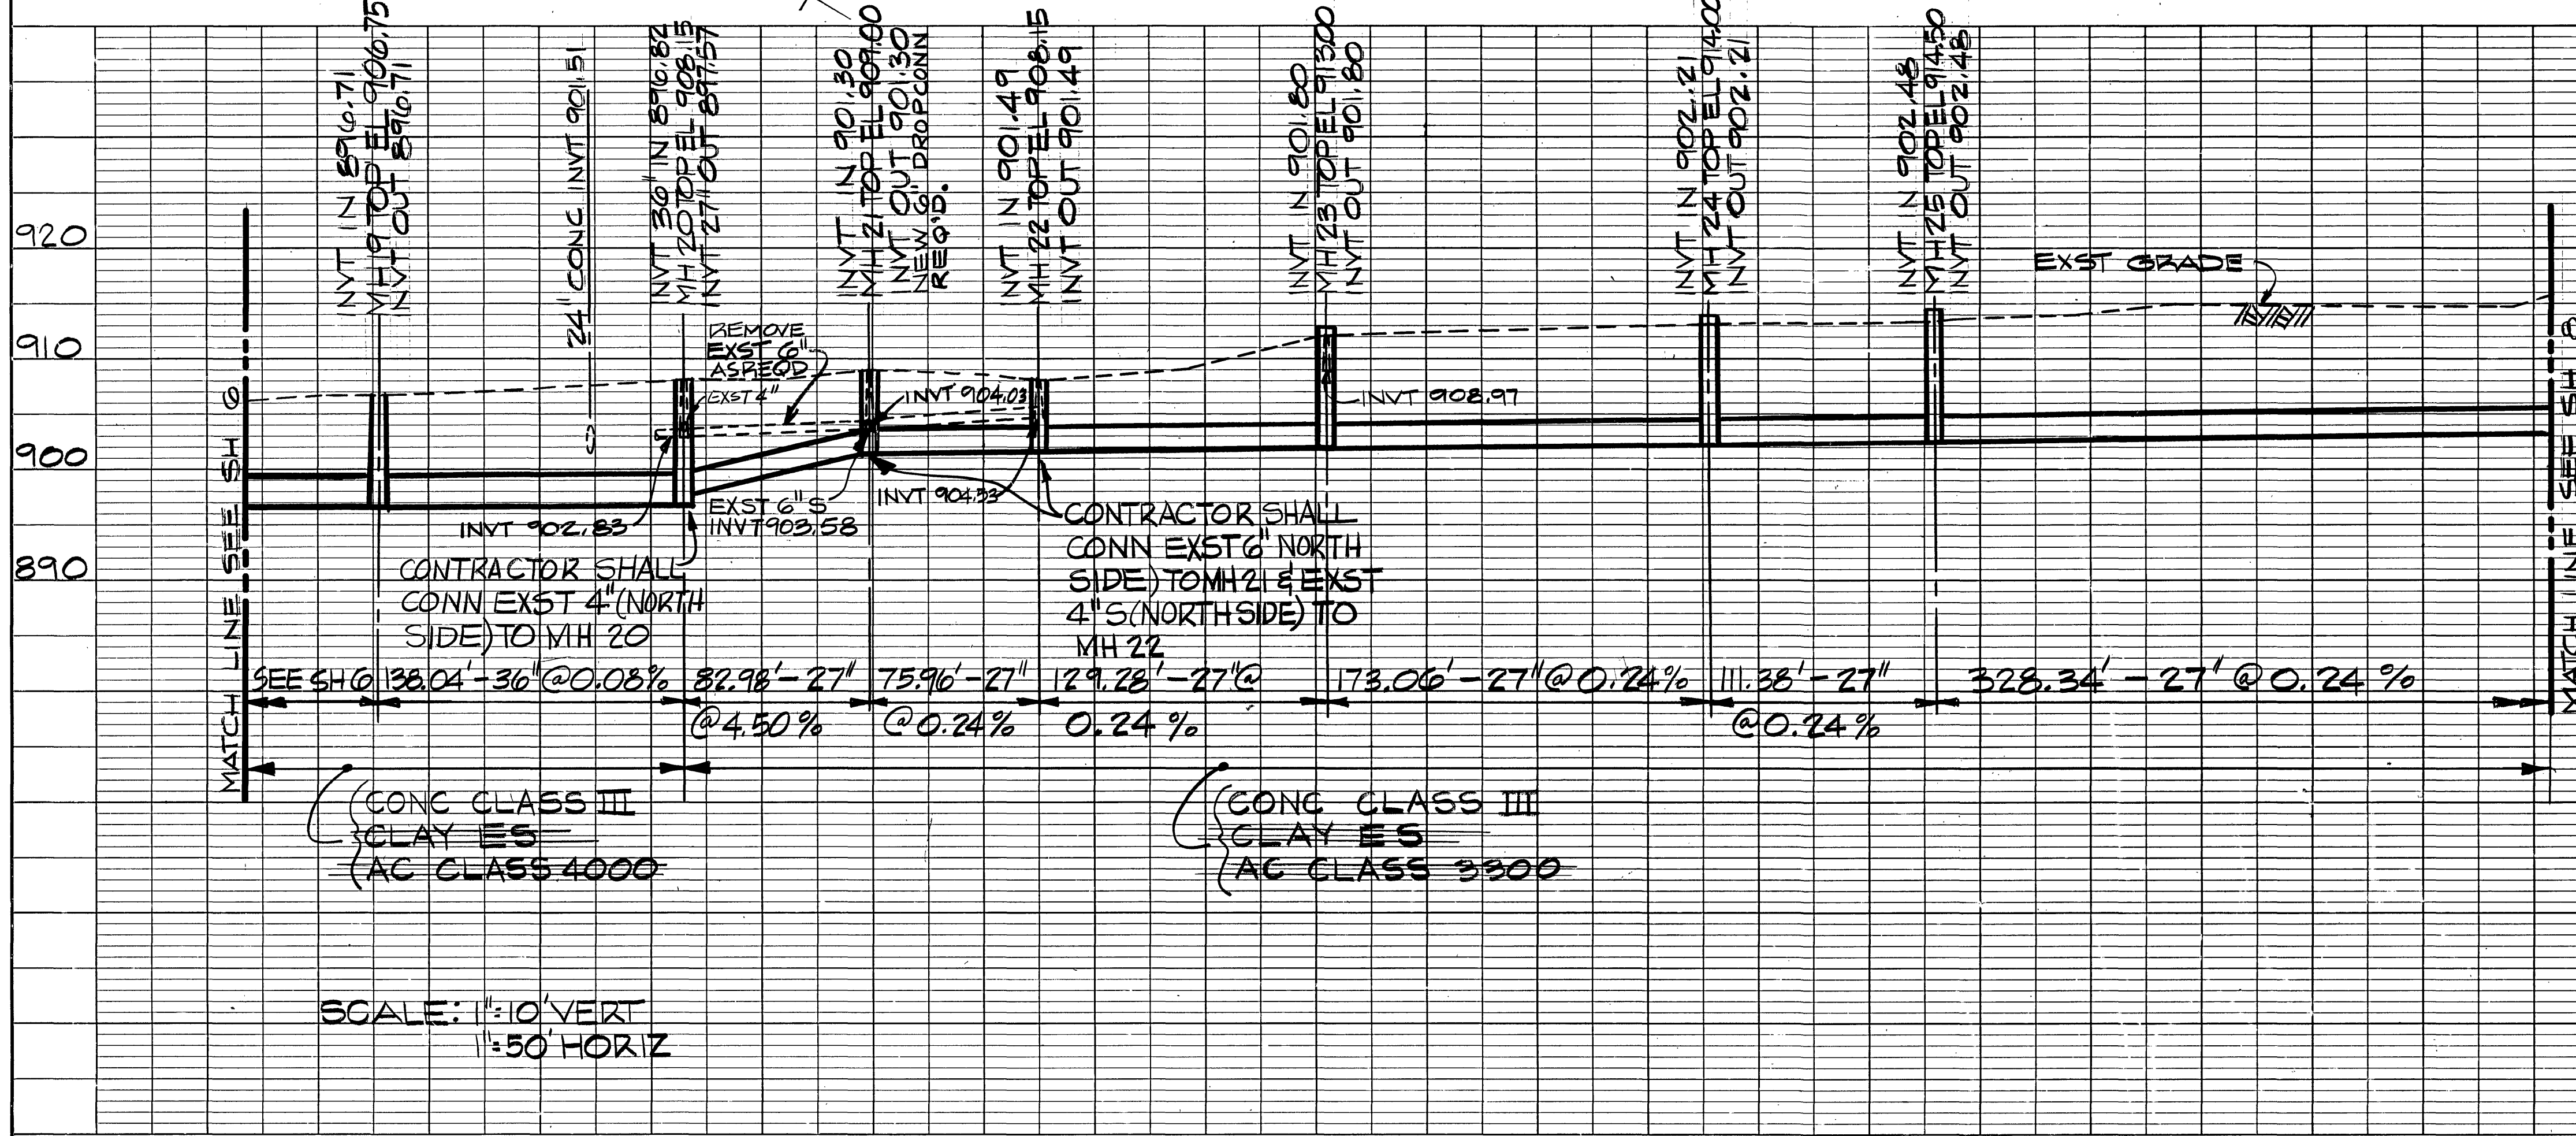

137	JAN 1982	AS BUILT	CAT	SWA
REVISION	DATE	DESCRIPTION	BY	APP
DESIGNED	DATE	DESCRIPTION	BY	APP
DRAWN	DATE	DESCRIPTION	BY	APP
CHECKED	DATE	DESCRIPTION	BY	APP
APPROVED	DATE	DESCRIPTION	BY	APP
SUBMITTED	DATE	DESCRIPTION	BY	APP
GLADE CREEK SANITARY SEWER INTERCEPTOR				
CITY OF ROANOKE, VIRGINIA				
Mattern and Craig CONSULTING ENGINEERS ROANOKE, VIRGINIA			SCALE: AS NOTED	COMM. NO. 329
			DATE: FEB. 1980	SHEET 7