

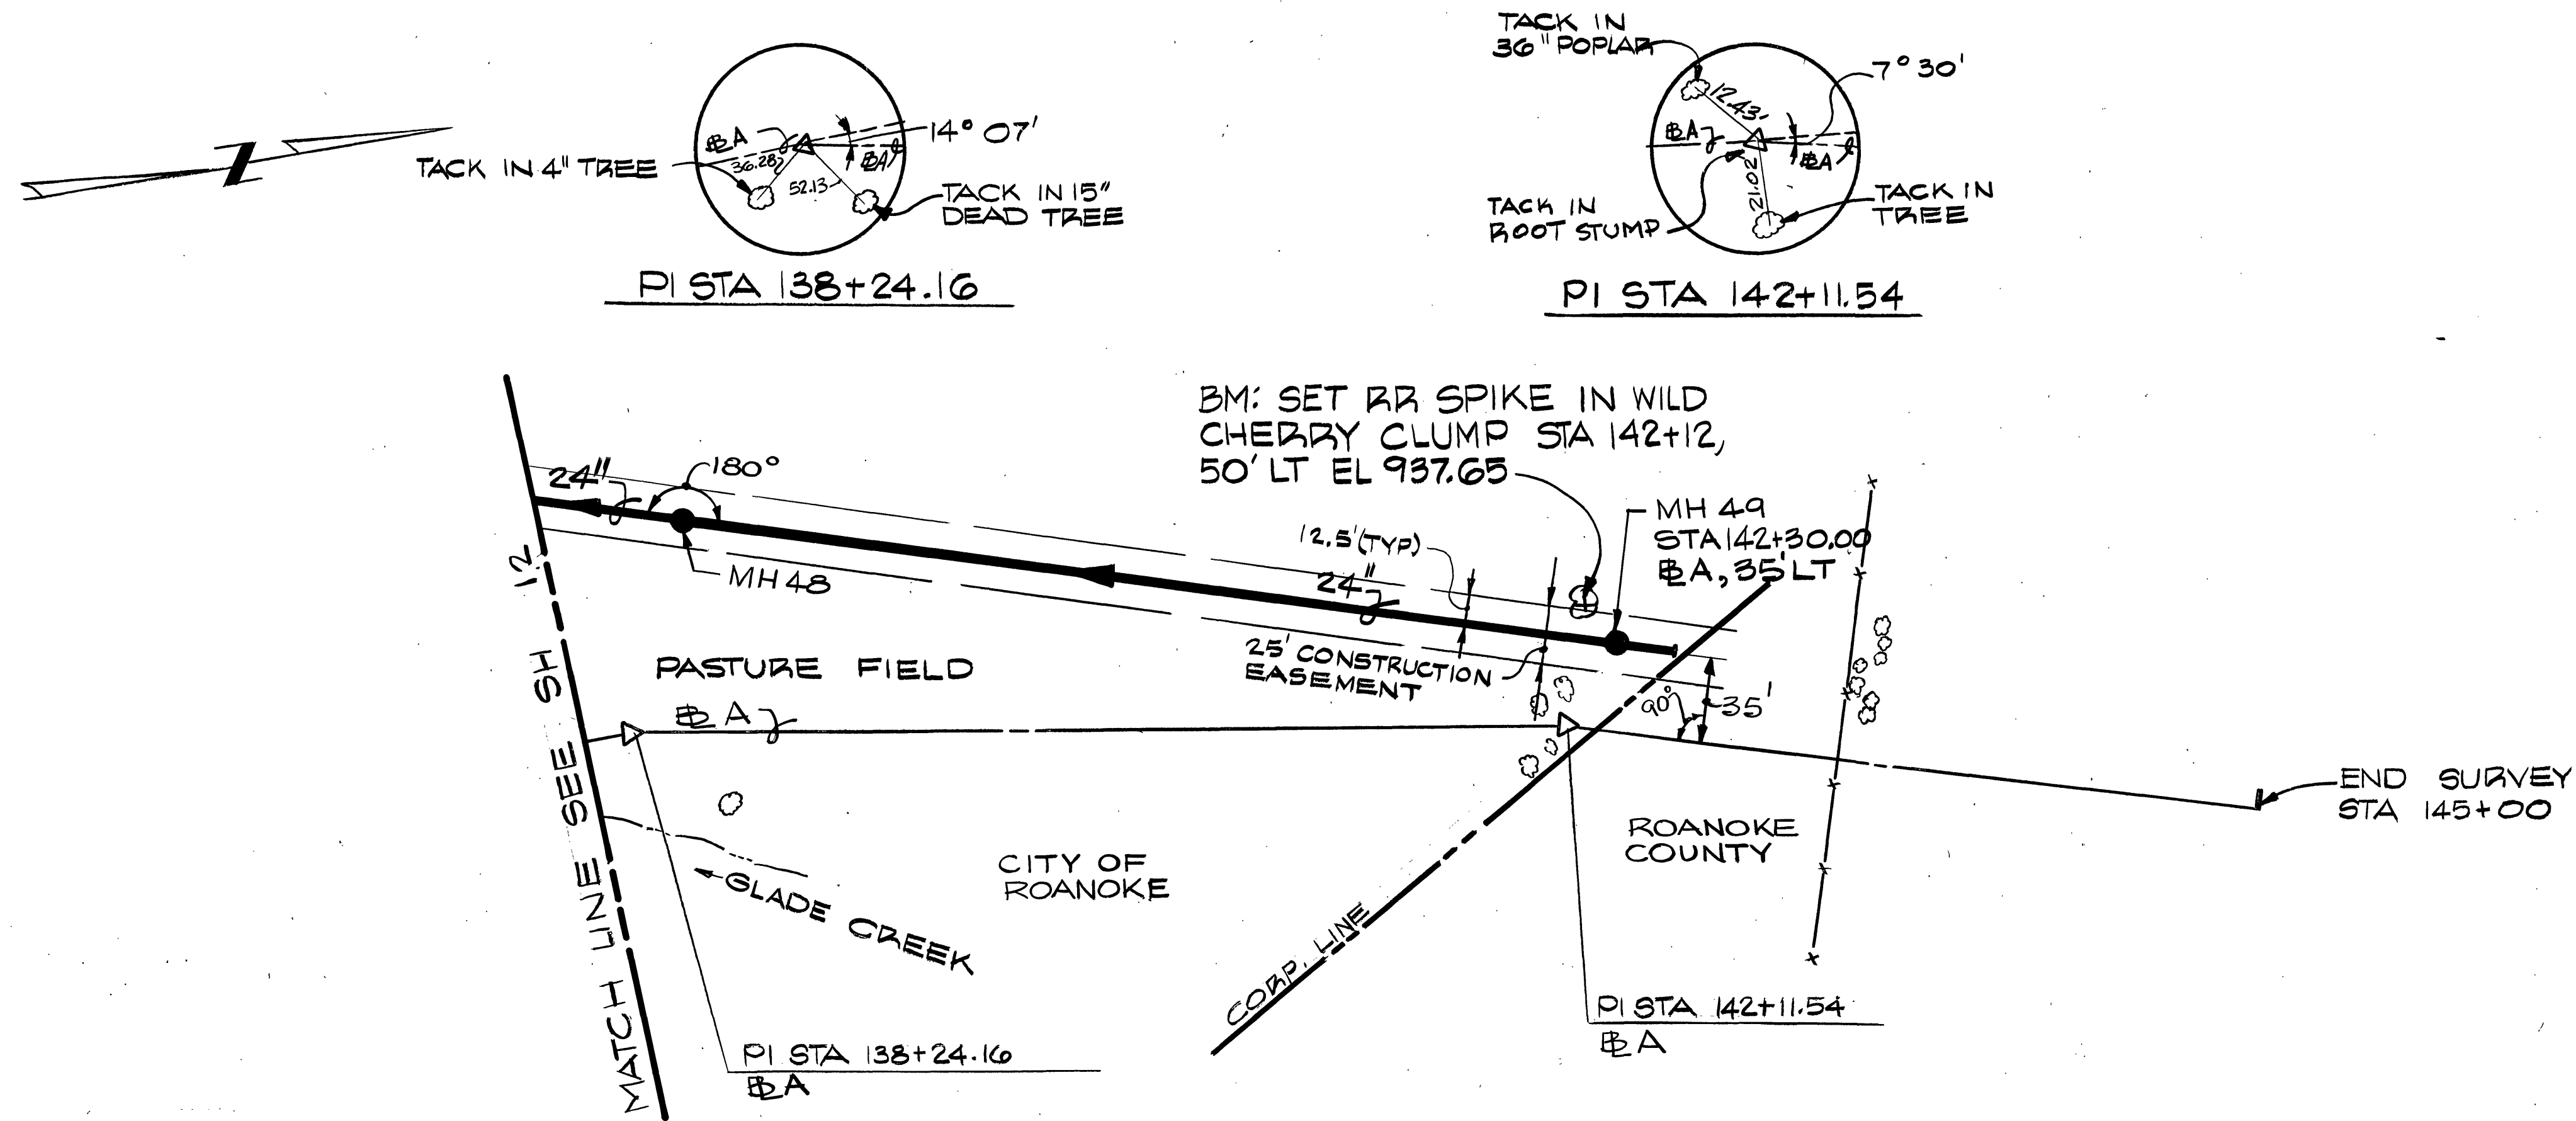


|      |           |      |
|------|-----------|------|
| PLAN | SURVEYED  | DATE |
|      | NOTED     | BY   |
|      | NOTE BOOK |      |
|      | No.       |      |

|         |           |      |
|---------|-----------|------|
| PROFILE | SURVEYED  | DATE |
|         | NOTED     | BY   |
|         | NOTE BOOK |      |
|         | No.       |      |

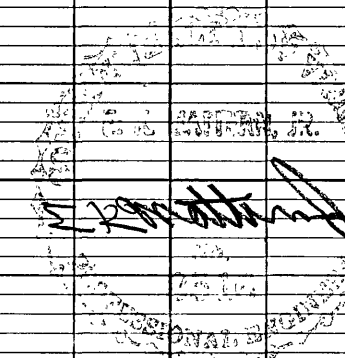

| MH NO. | STD. DET. NO. | FRAME & COVER |
|--------|---------------|---------------|
| 48     | 1             | STD           |
| 49     | 1             | STD           |

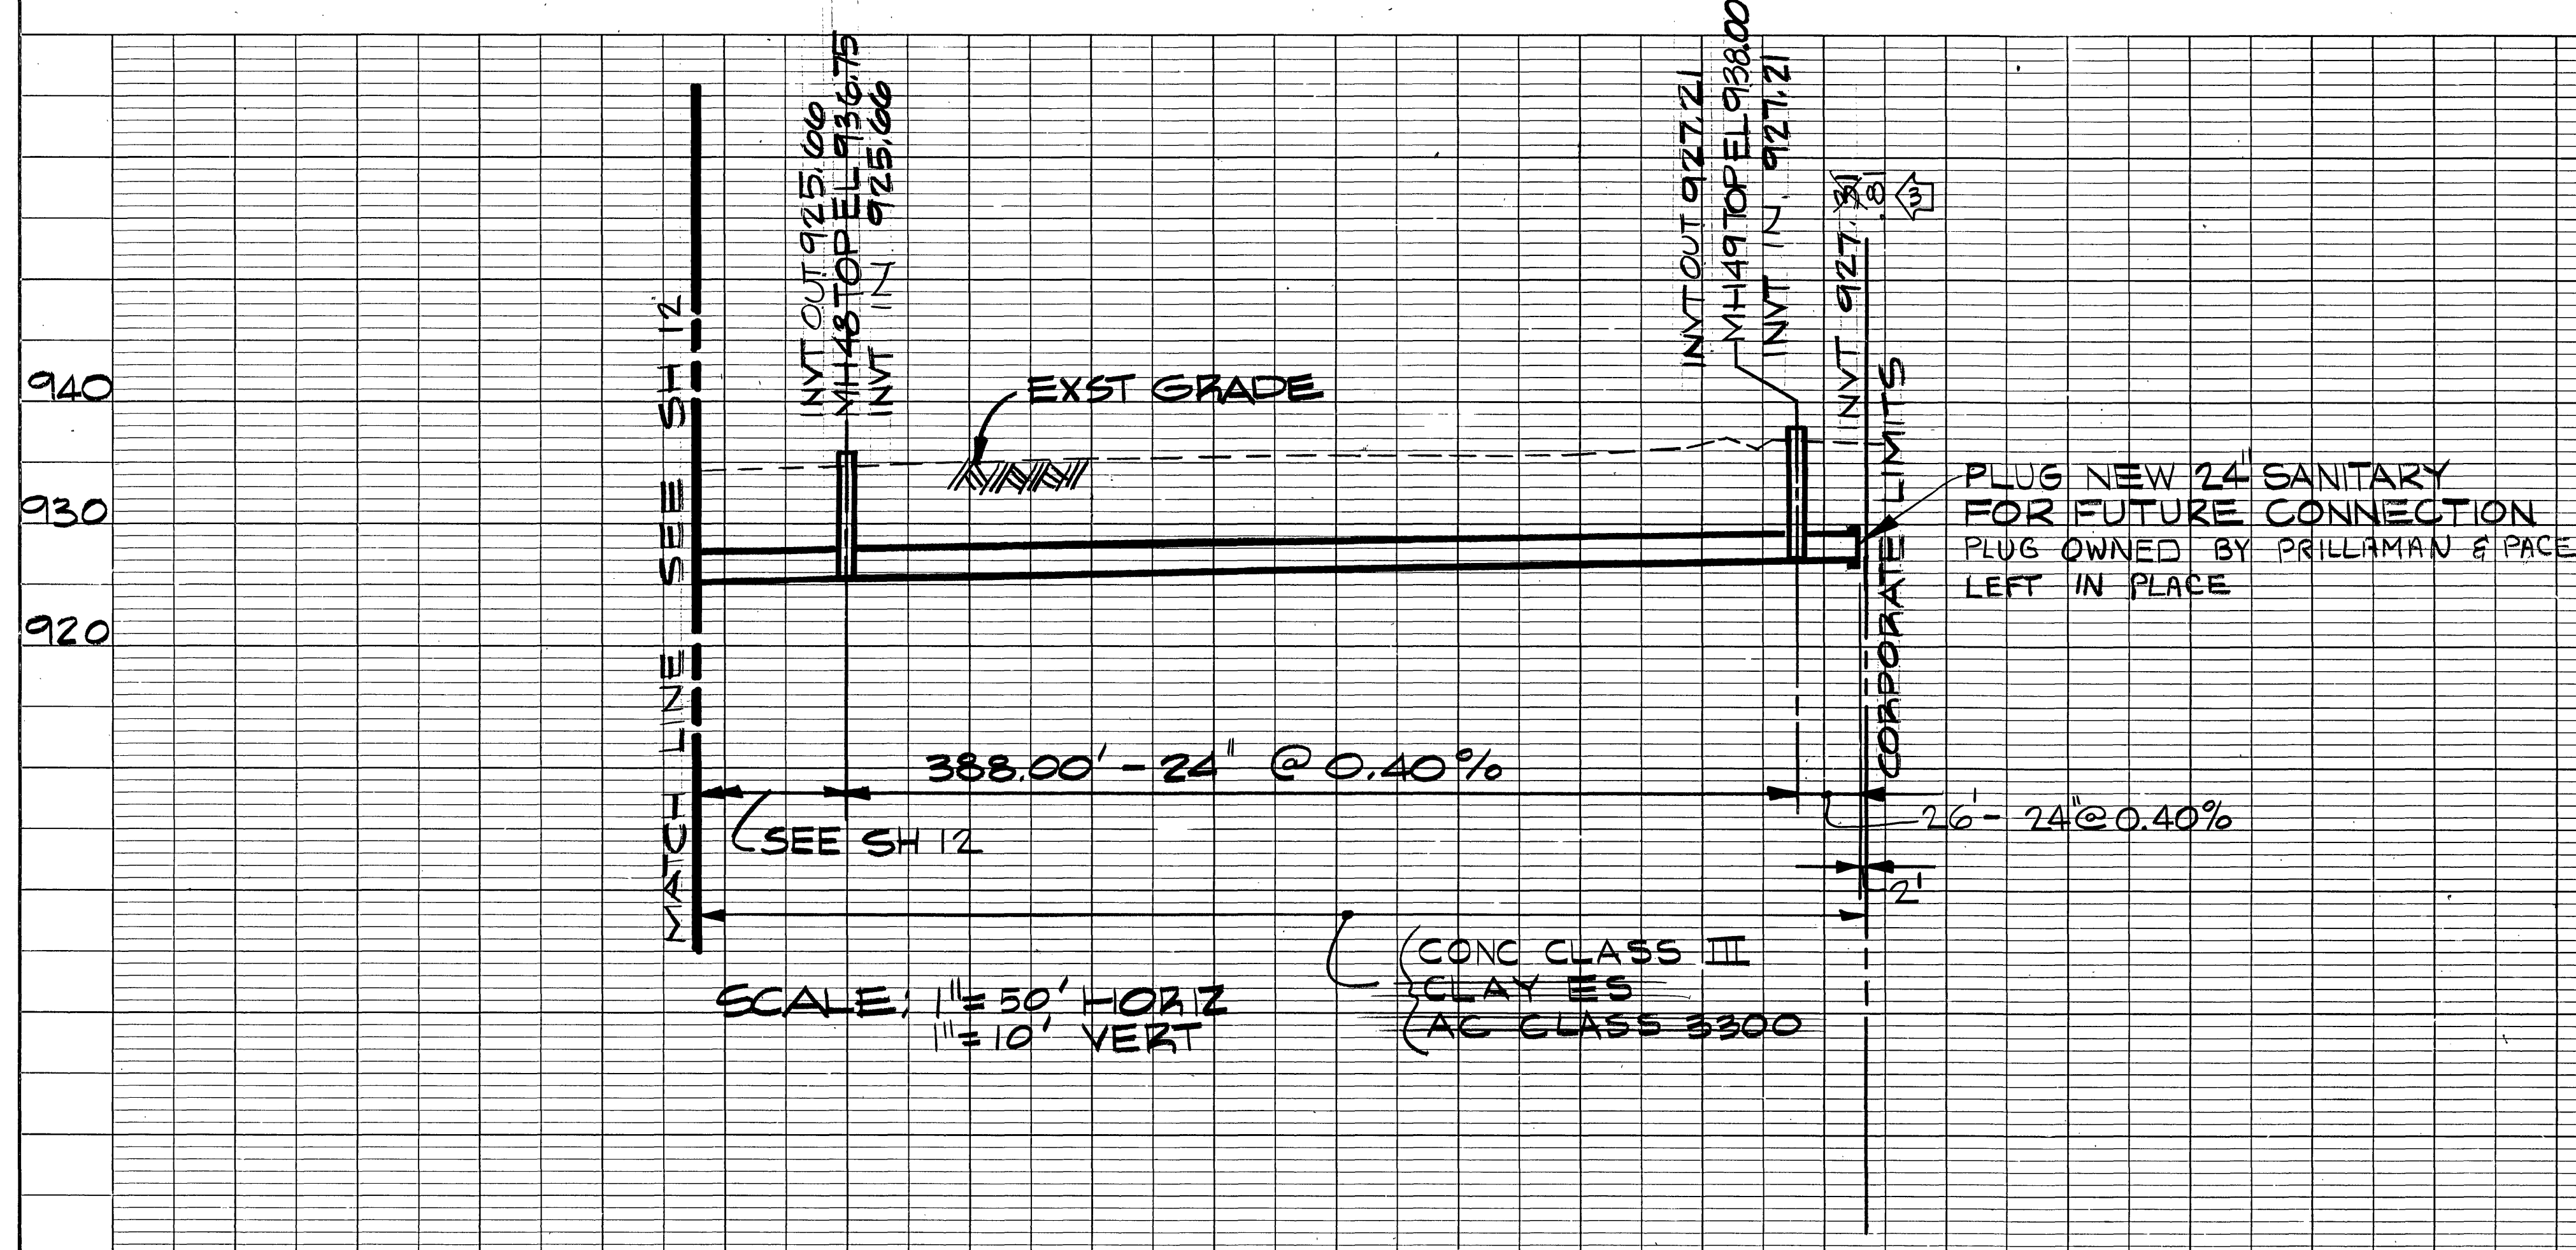

|                      |          |                                        |               |     |
|----------------------|----------|----------------------------------------|---------------|-----|
| 3                    | JAN 1982 | AS BUILT                               | CAT           | SWH |
| REVISION             | DATE     | DESCRIPTION                            | BY            | APP |
| DESIGNED             | DATE     | DESCRIPTION                            | BY            | APP |
| DRAWN                | DATE     | DESCRIPTION                            | BY            | APP |
| CHECKED              | DATE     | DESCRIPTION                            | BY            | APP |
| APPROVED             | DATE     | DESCRIPTION                            | BY            | APP |
| SUBMITTED            | DATE     | DESCRIPTION                            | BY            | APP |
| Mattern and Craig    |          | GLADE CREEK SANITARY SEWER INTERCEPTOR |               |     |
| CONSULTING ENGINEERS |          | CITY OF ROANOKE, VIRGINIA              |               |     |
| ROANOKE, VIRGINIA    |          | SCALE: AS NOTED                        | COMM. NO. 329 |     |
|                      |          | DATE: FEB. 1980                        | SHEET 13      |     |