
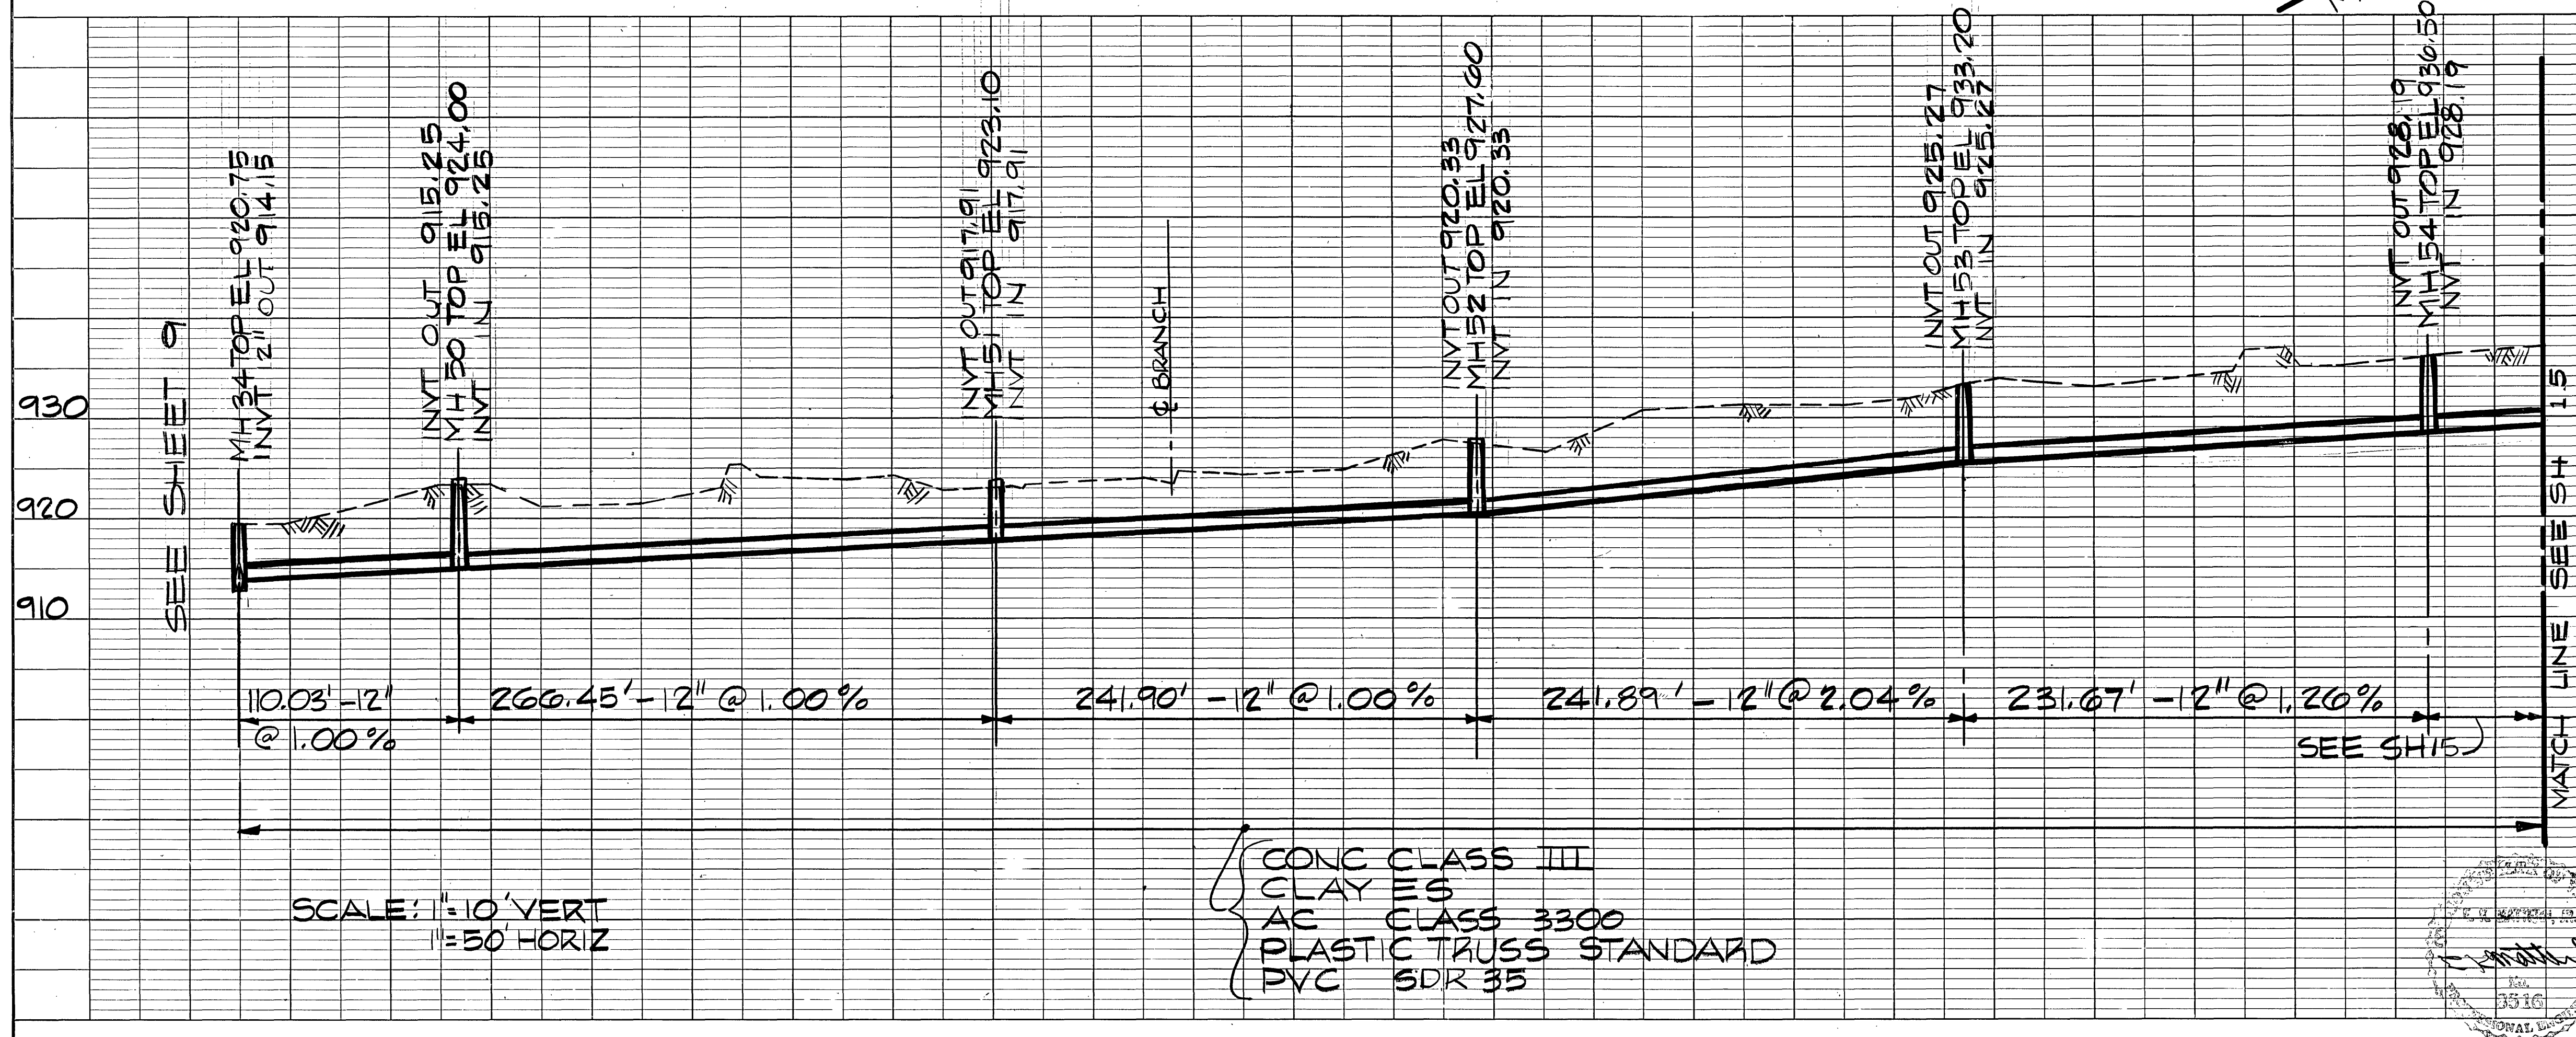


PLAN	DATE
DESIGNED	
DRAWN	
CHECKED	
APPROVED	
NO.	

PROFILE	DATE
DESIGNED	
DRAWN	
CHECKED	
APPROVED	
NO.	

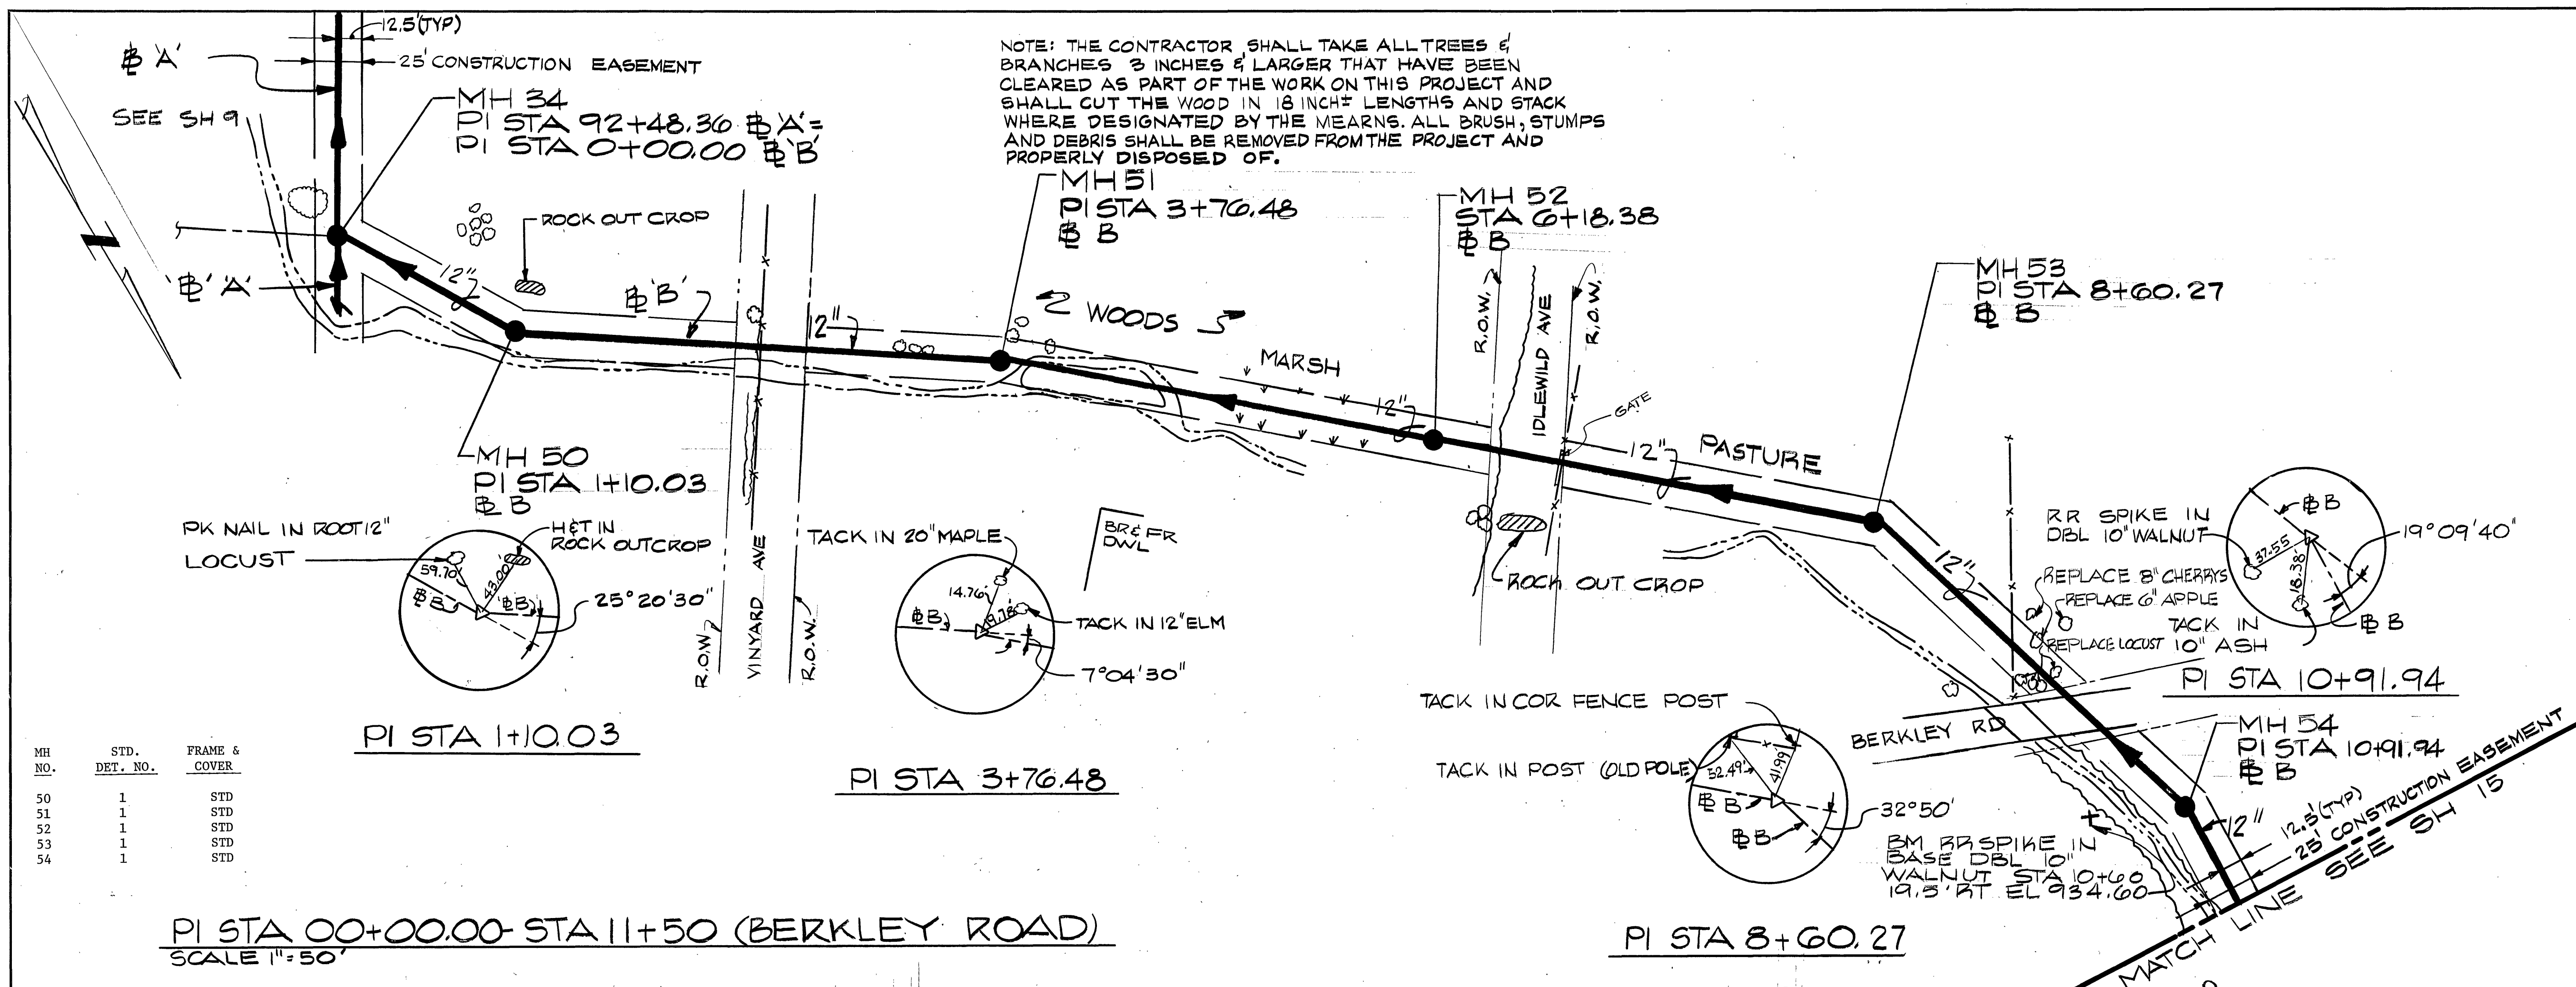

REVISION	DATE	DESCRIPTION	BY	APP
DESIGNED	JAN 1982	AS BUILT	CRT	SWA
DRAWN				
CHECKED				
APPROVED				
SUBMITTED				
GLADE CREEK SANITARY SEWER INTERCEPTOR				
CITY OF ROANOKE, VIRGINIA				
Mattern and Craig			SCALE: AS NOTED	COMM. NO. 329
CONSULTING ENGINEERS ROANOKE, VIRGINIA			DATE: FEB. 1980	SHEET 14

#5670