


PROFILE	SURVEYED _____		BY _____	DATE _____
	PLOTTED _____			
NOTE BOOK	GRADES CHECKED _____			
	B. M.'s NOTED _____			
No. _____	STRUCTURE MEASUREMENTS CHECKED _____			

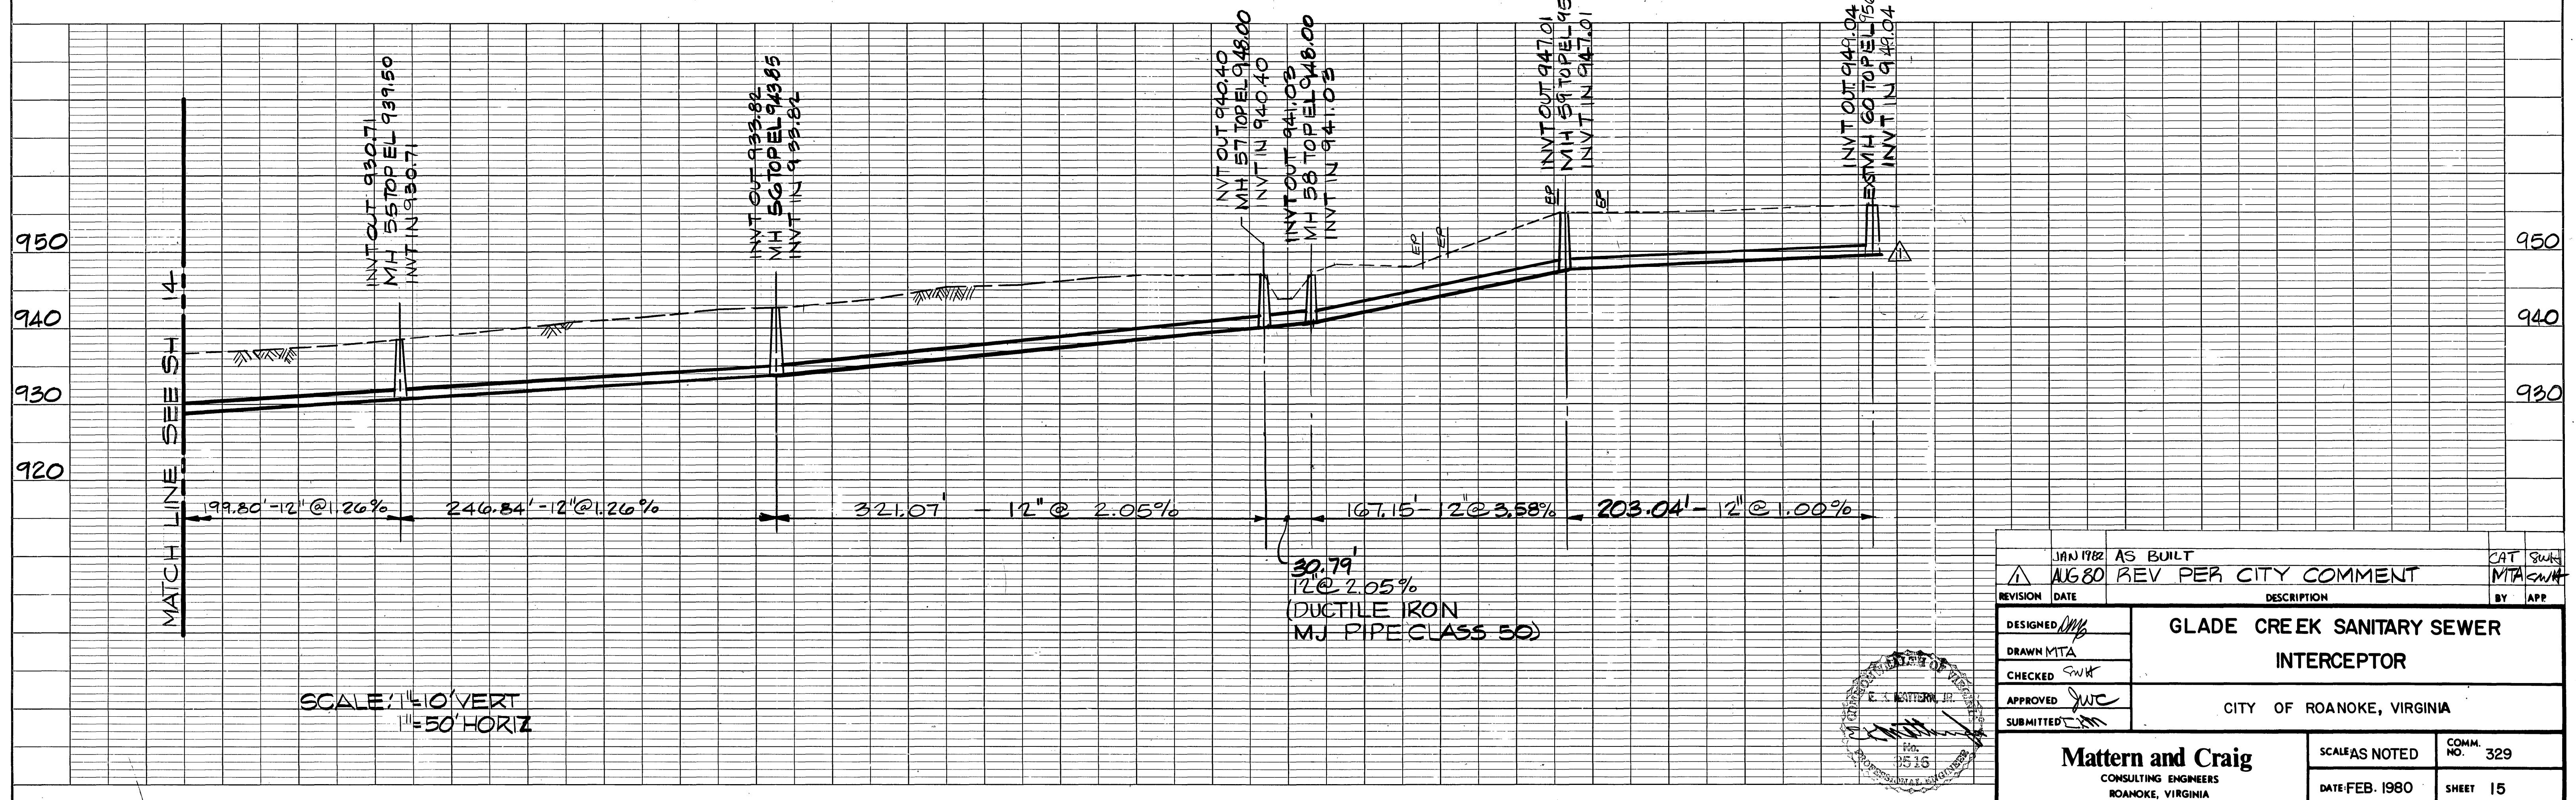

JAN 1982		AS BUILT		CAT	SWK
AUG 80		REV PER CITY COMMENT		MTA	SWK
REVISION	DATE	DESCRIPTION			BY APP
DESIGNED	SWK	GLADE CREEK SANITARY SEWER INTERCEPTOR			
DRAWN	MTA				
CHECKED	SWK				
APPROVED	JWC	CITY OF ROANOKE, VIRGINIA			
SUBMITTED	SWK				
Mattern and Craig CONSULTING ENGINEERS ROANOKE, VIRGINIA		SCALE	AS NOTED	COMM. NO.	329
		DATE	FEB. 1980	SHEET	15

5670