


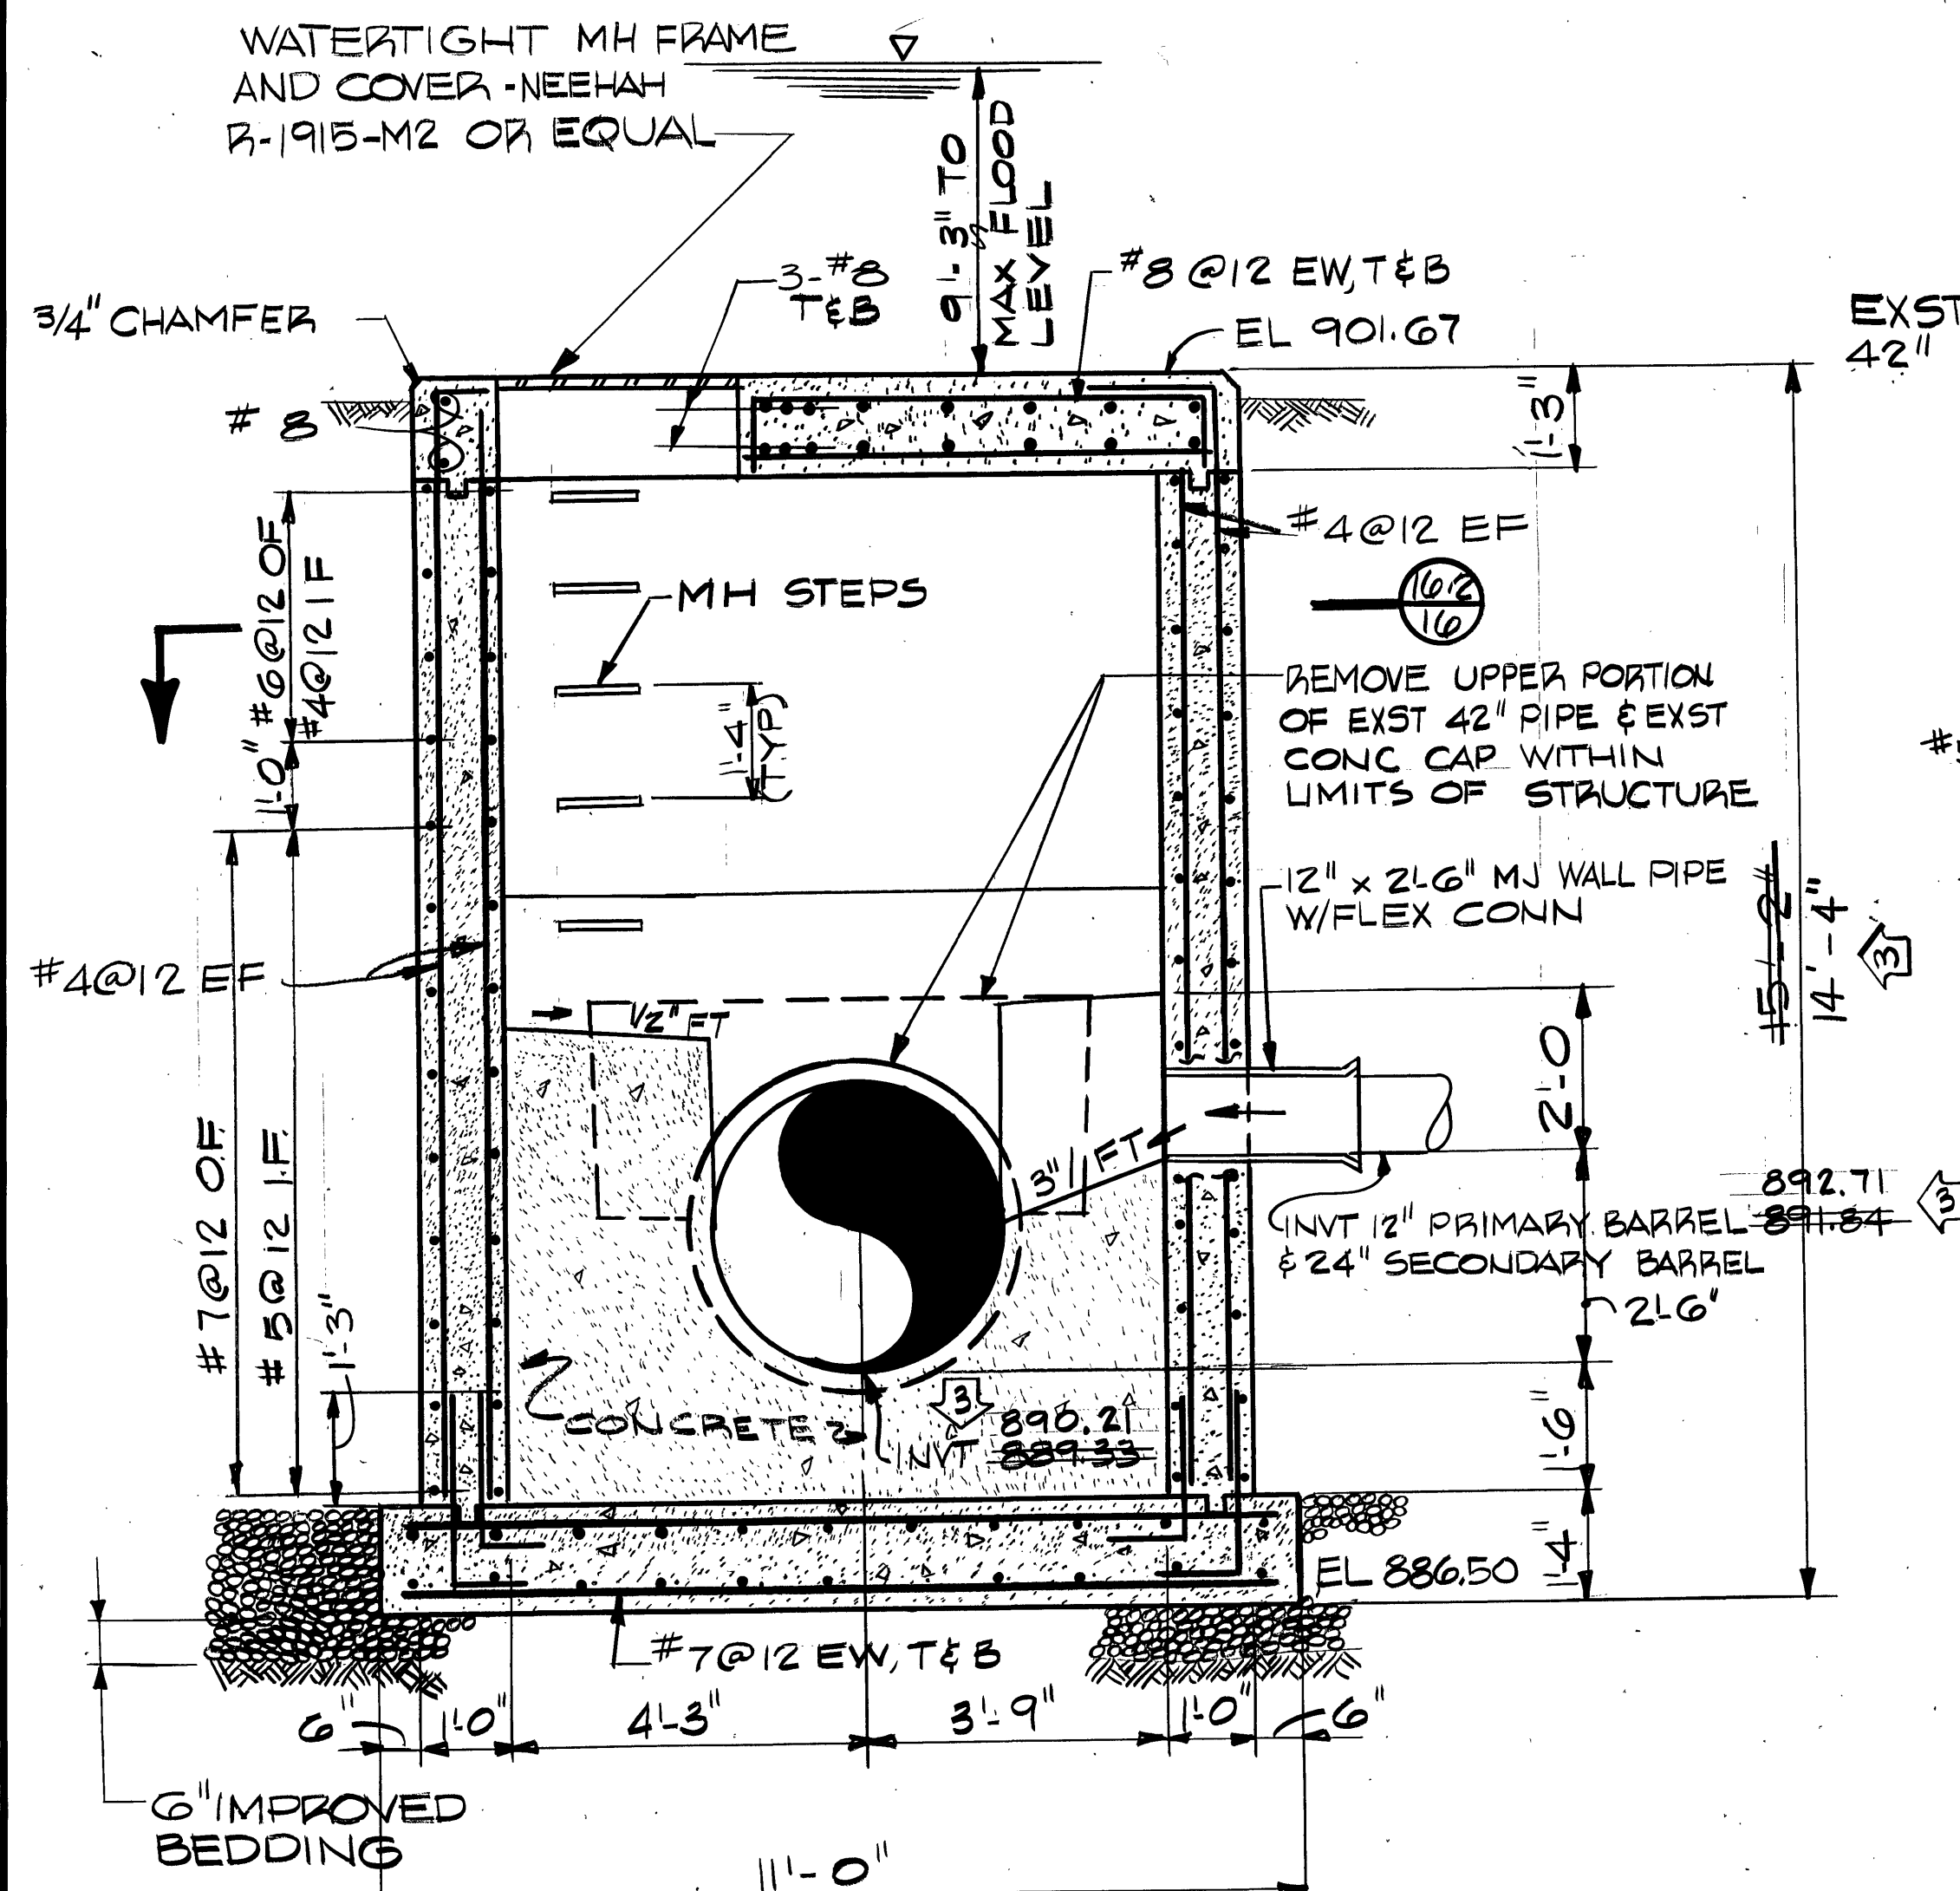


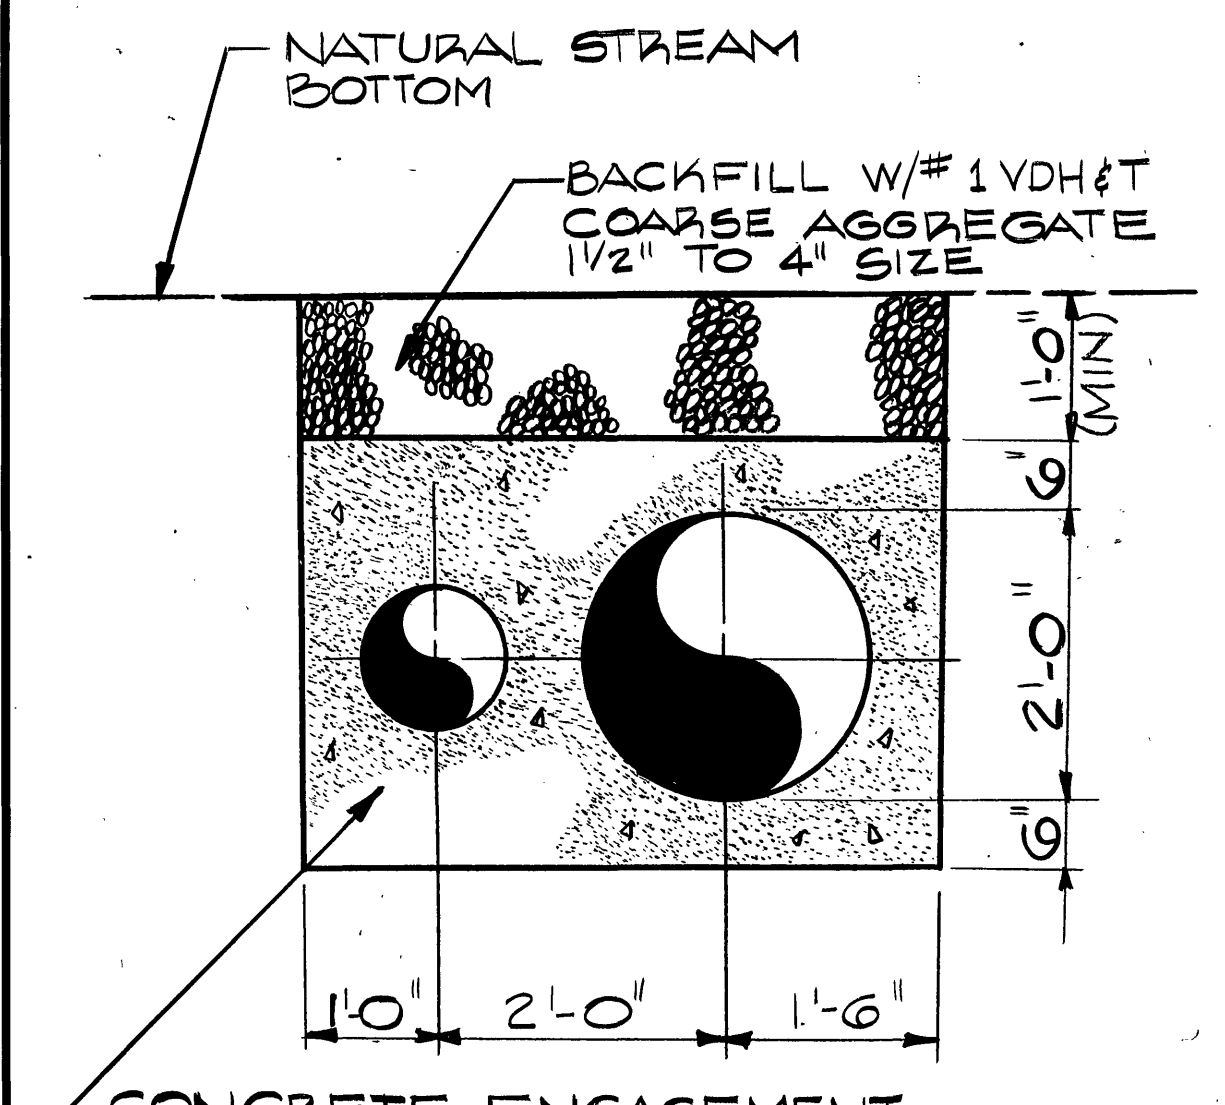


SECTION
SCALE: 1/2" = 1'-0"

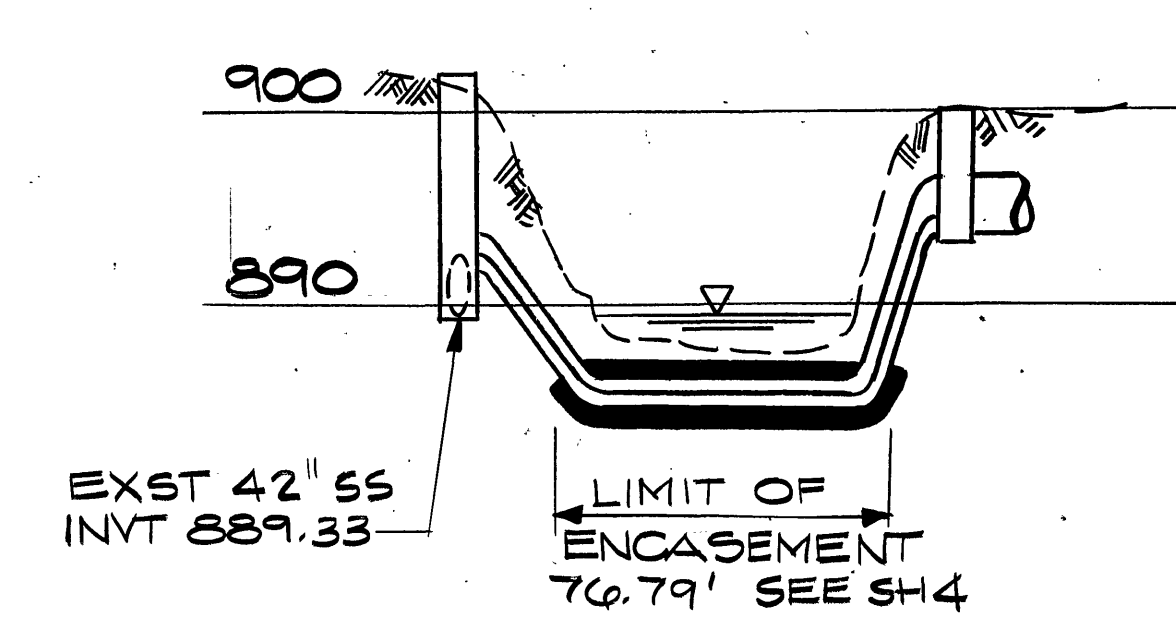


SECTION
SCALE: 3/4" = 1'-0"

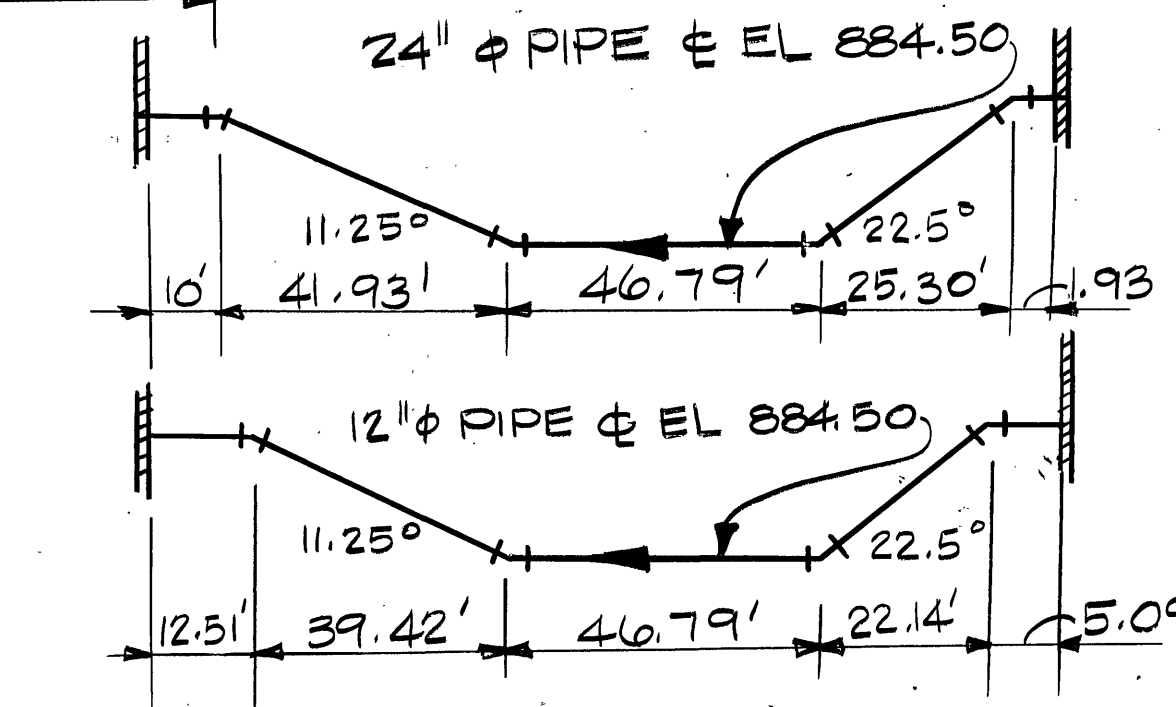


SIPHON PROFILE
SCALE: NONE

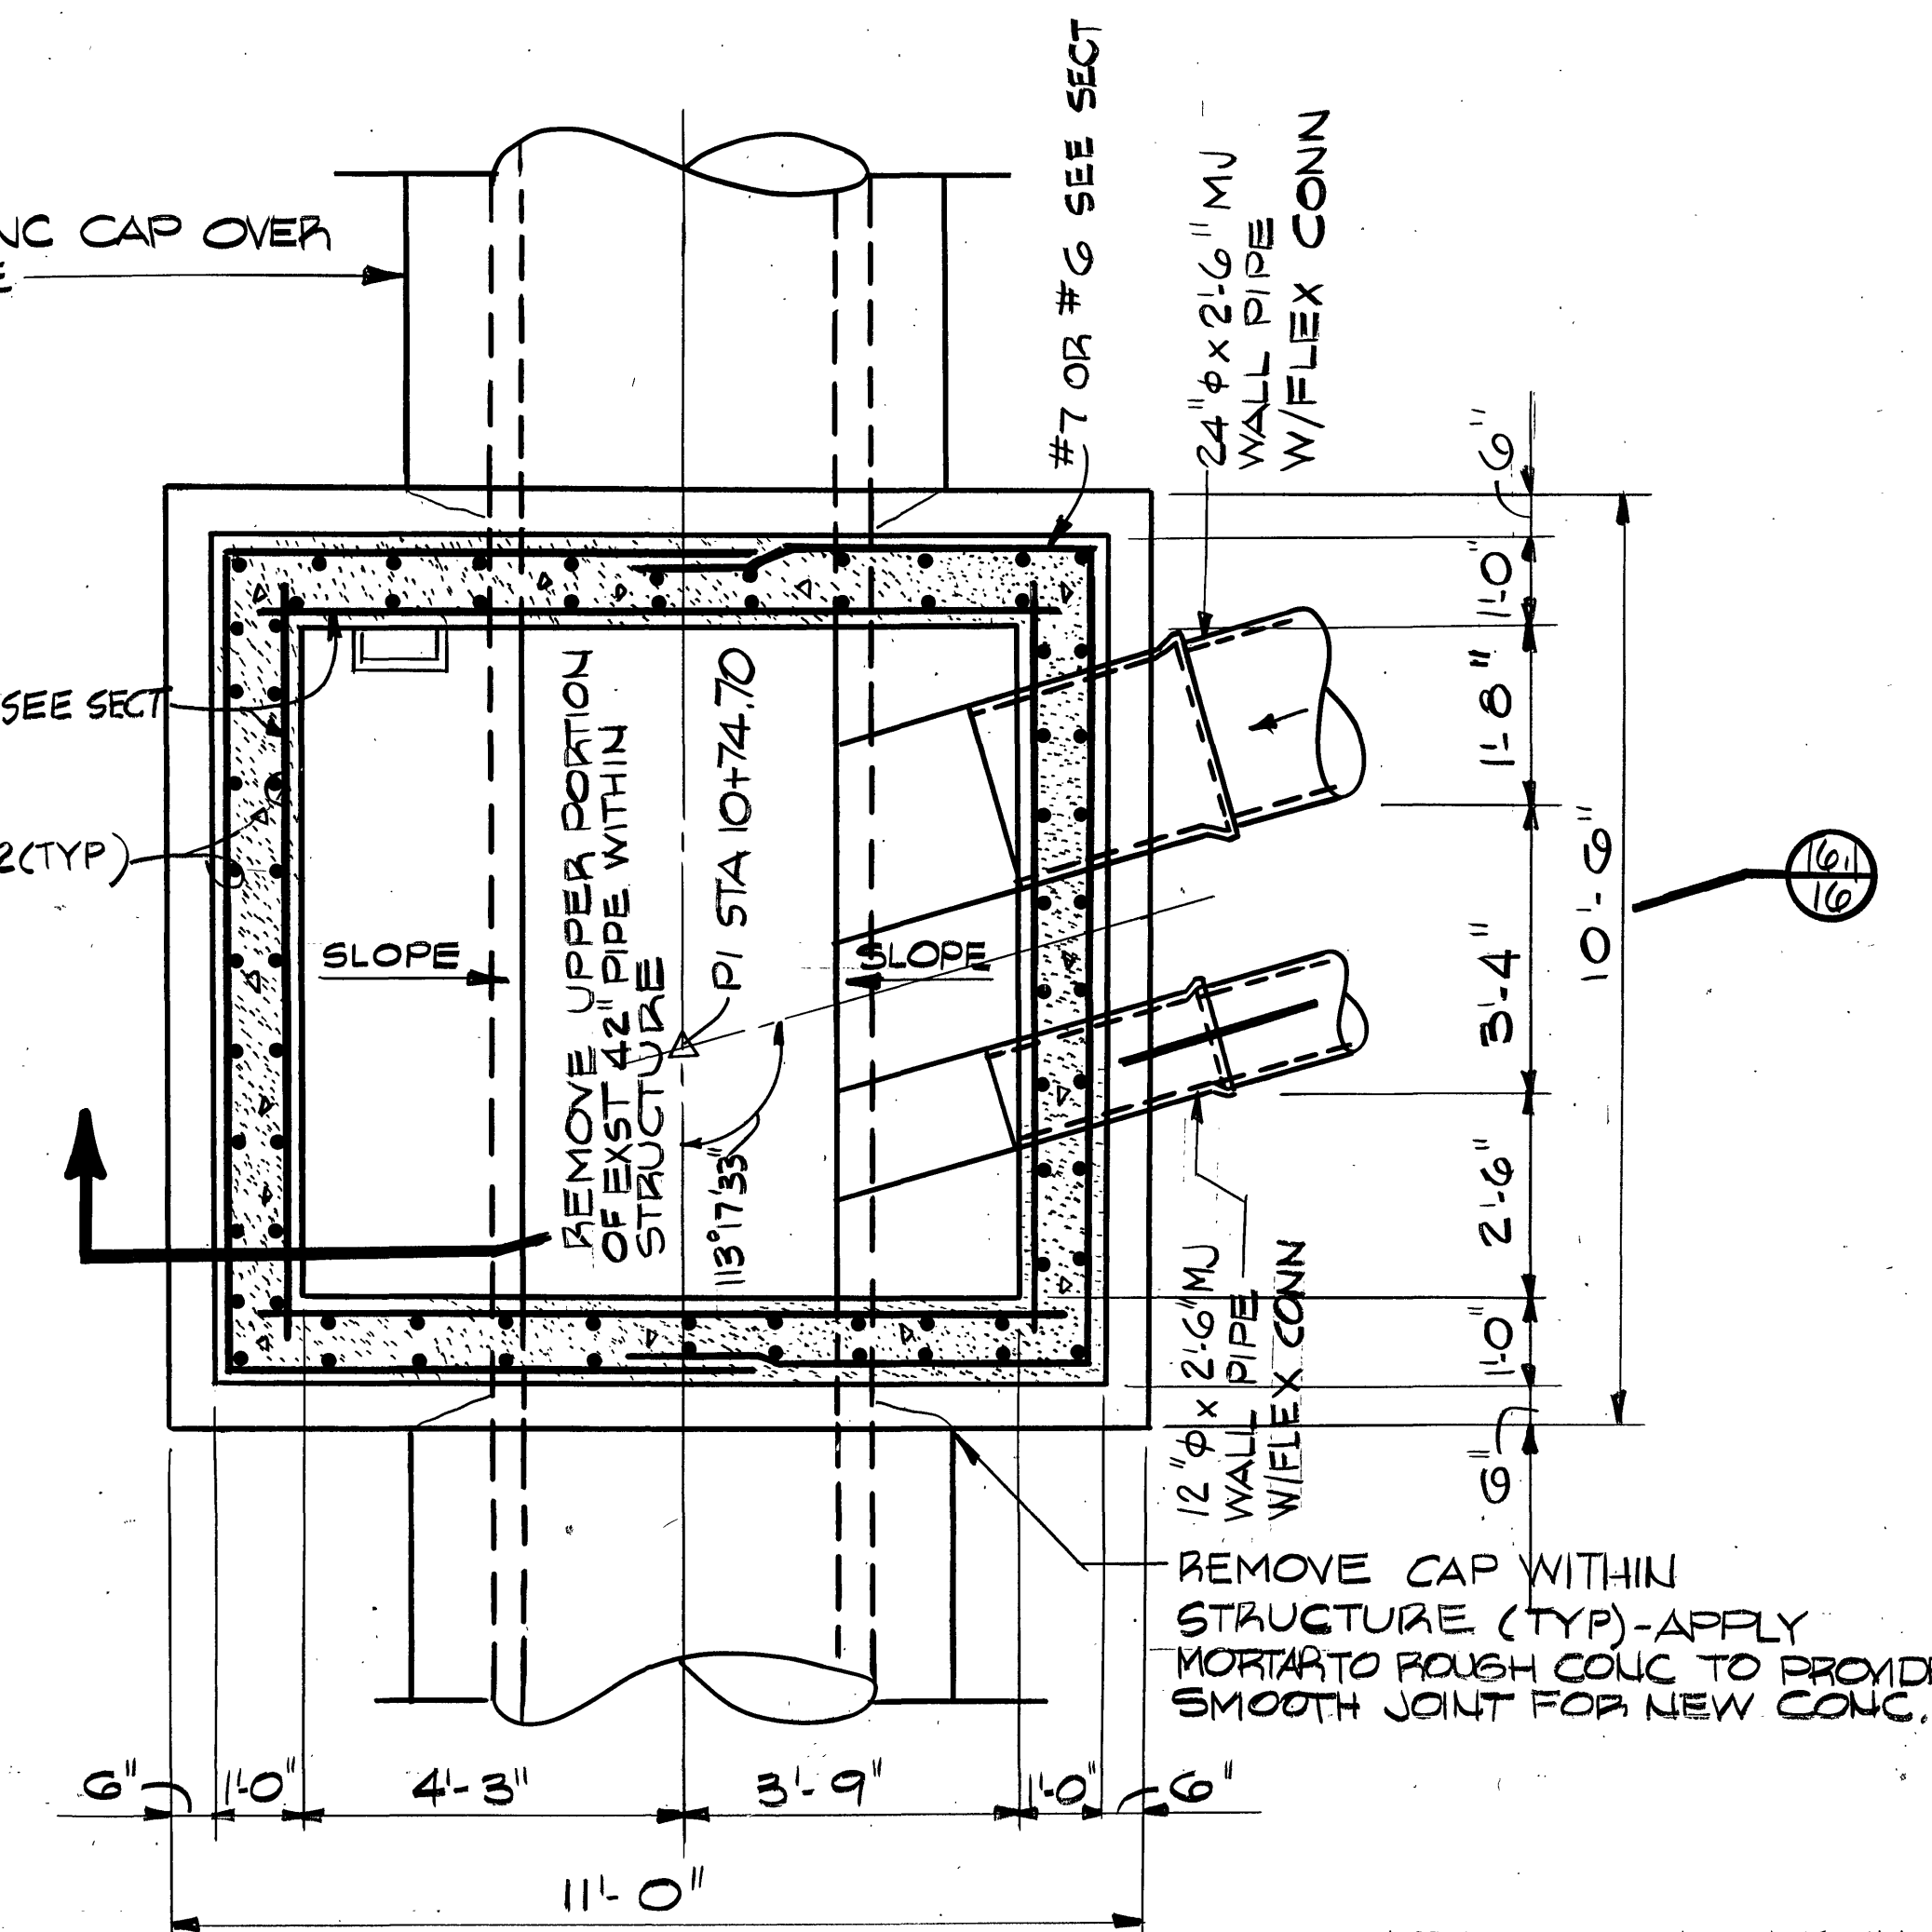

SECTION
SCALE: 1/2" = 1'-0"

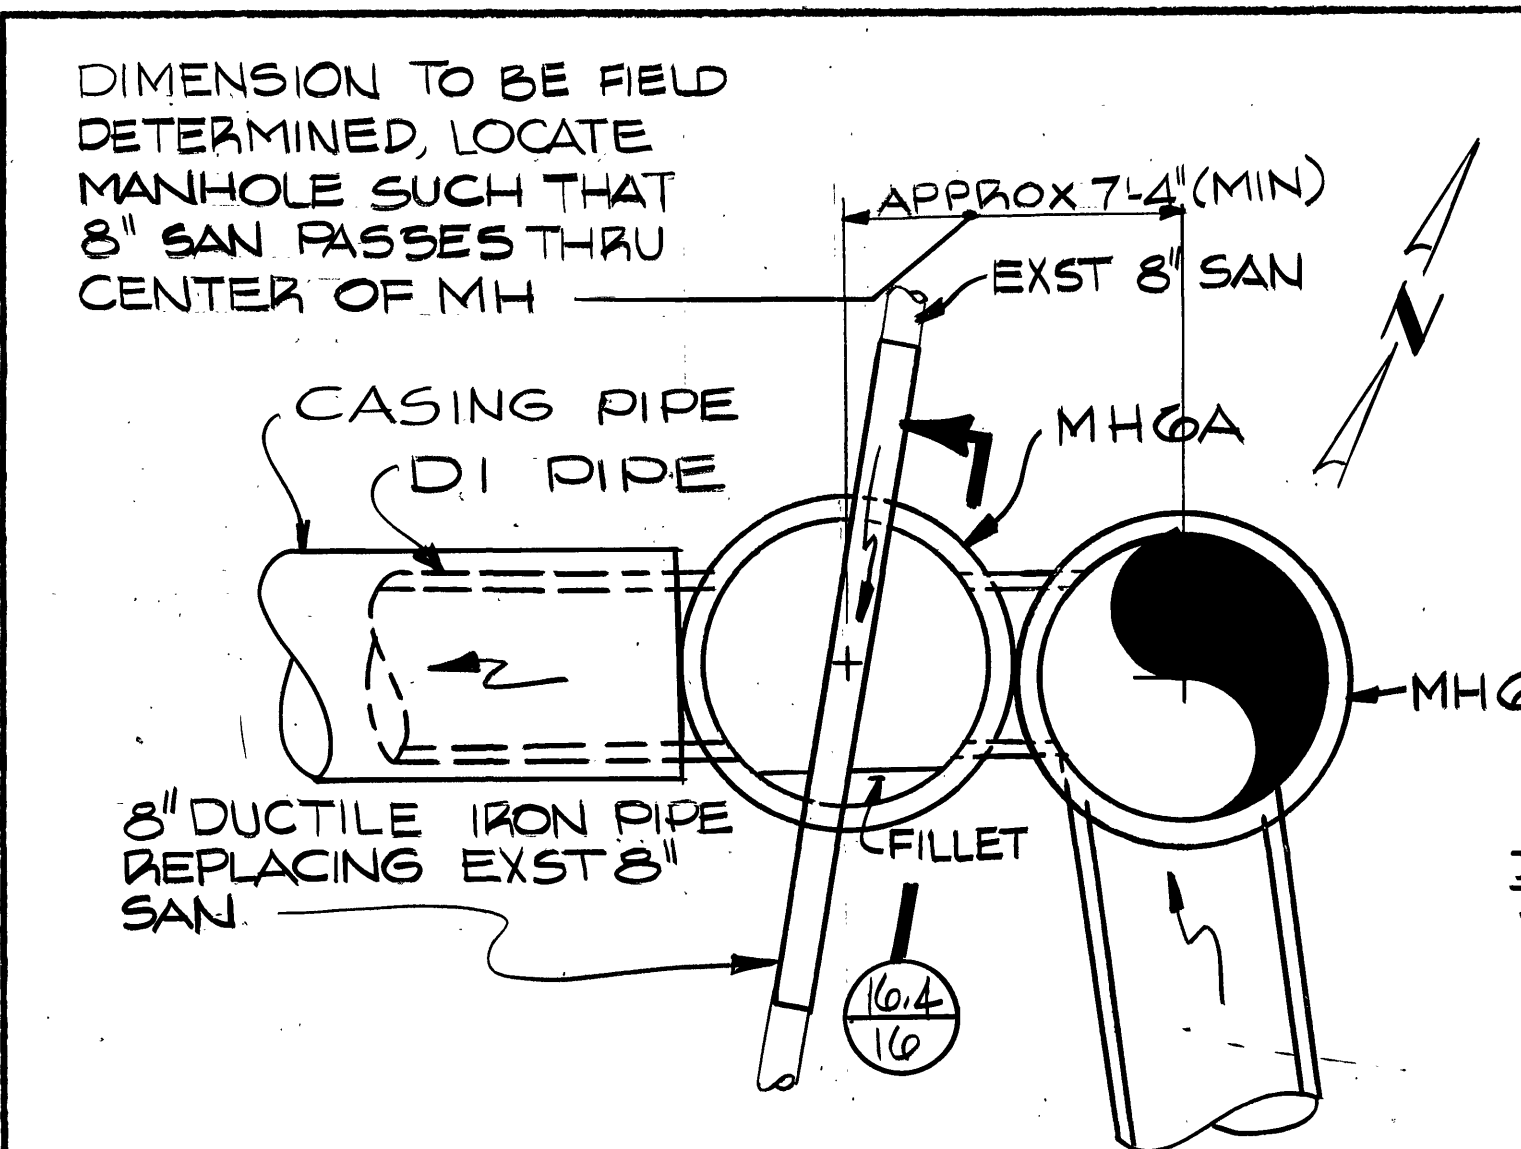


SECTIONAL PLAN-MH6 & MH6A
SCALE: 1/4" = 1'-0"

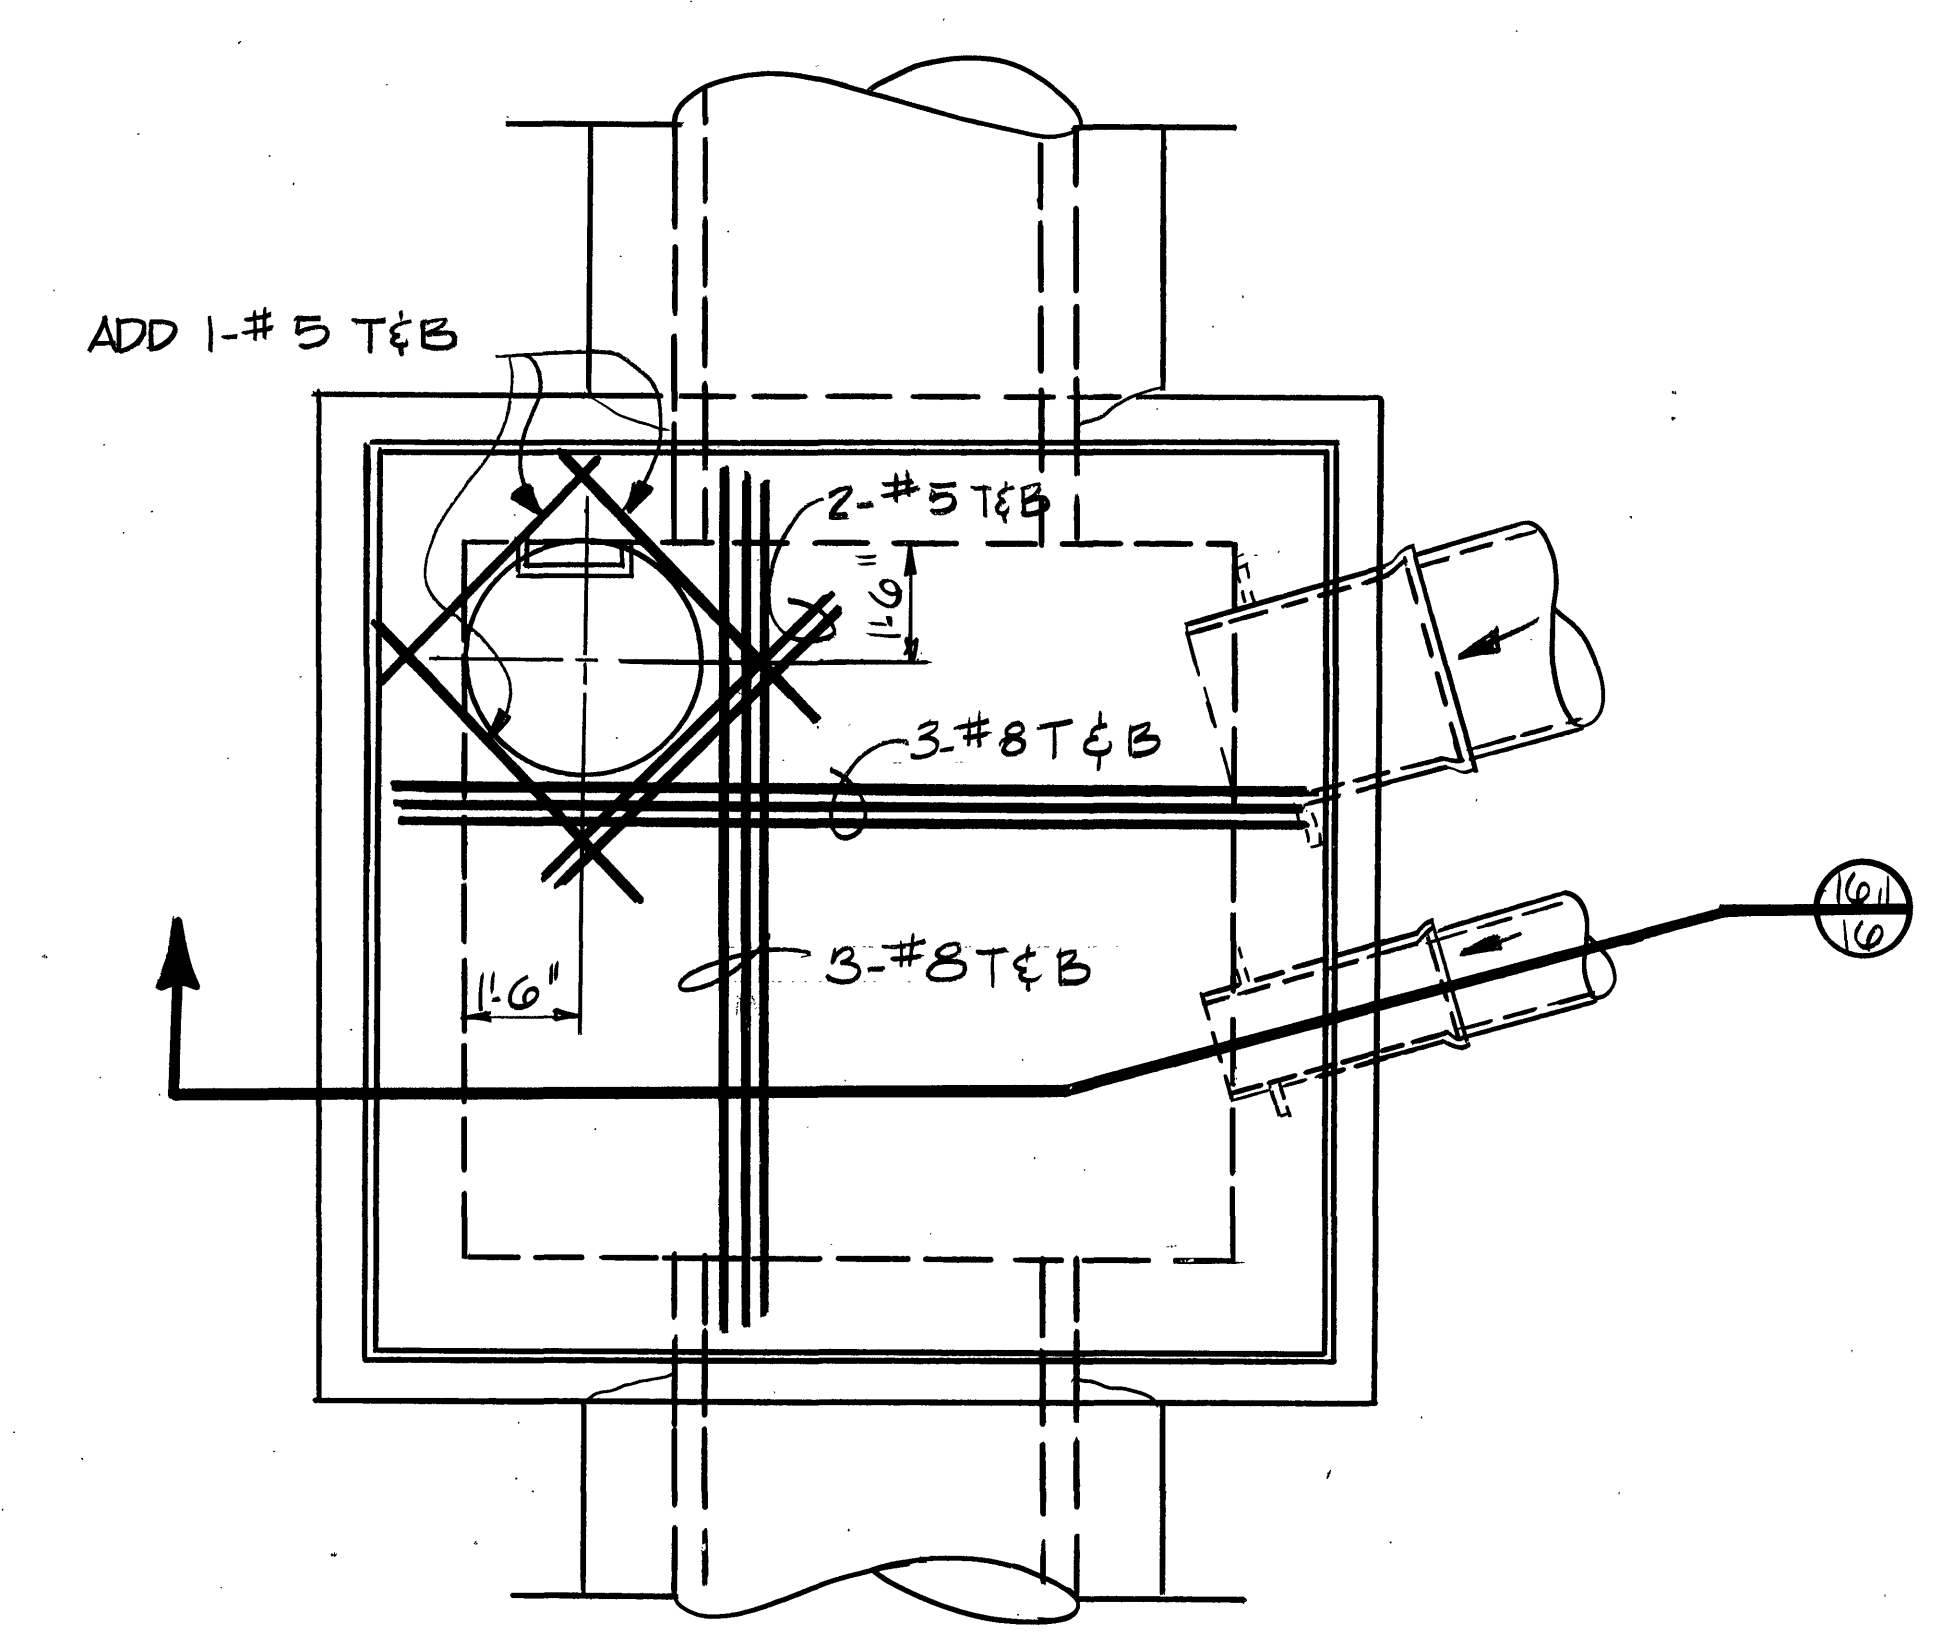

PLAN AT ELEVATION 901.70
SCALE: 1/2" = 1'-0"
SIPHON OUTLET CHAMBER

NOTE: ALL JOINTS IN SIPHON INLET AND OUTLET STRUCTURES SHALL HAVE WATERSTOPS. WATERSTOP SHALL BE CONTINUOUS STRIPS OF EXTRUDED OR MOLDED RUBBER OR POLYVINYL CHLORIDE CONFORMING TO CORPS OF ENGINEERS SPECIFICATIONS CRD-C-513 OR CRD-C-572

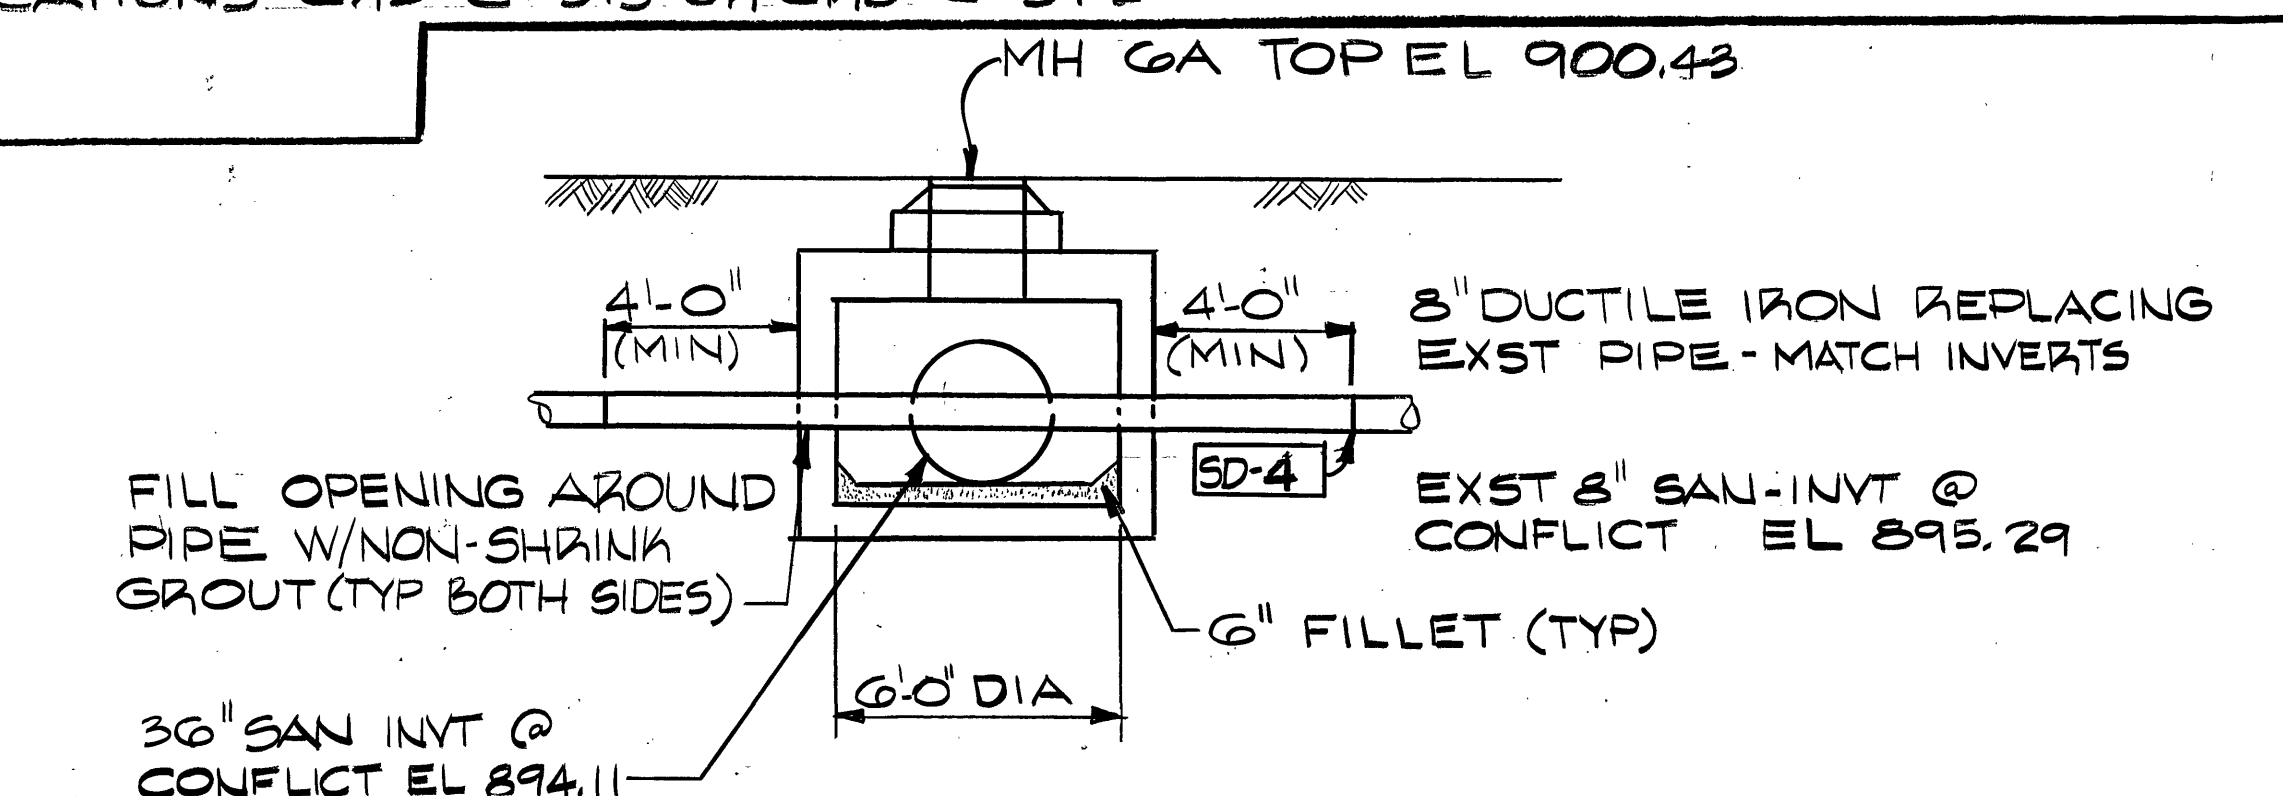

SECTION
SCALE: 1/4" = 1'-0"

NOTE: PIPE THRU MH6B ~~SHALL~~ SIMILAR TO THAT THRU MH6A

DESIGNED	JAN 1982	AS BUILT	CAT	SWH
DRAWN	MTA		BY	APP
CHECKED	SWH			
APPROVED	YMC			
SUBMITTED				
GLADE CREEK SANITARY SEWER INTERCEPTOR - DETAILS				
CITY OF ROANOKE, VIRGINIA				
Mattern and Craig		SCALE: AS NOTED	COMM. NO.	329
CONSULTING ENGINEERS		DATE: FEB. 1980	SHEET	16
ROANOKE, VIRGINIA				

