


VICINITY MAP

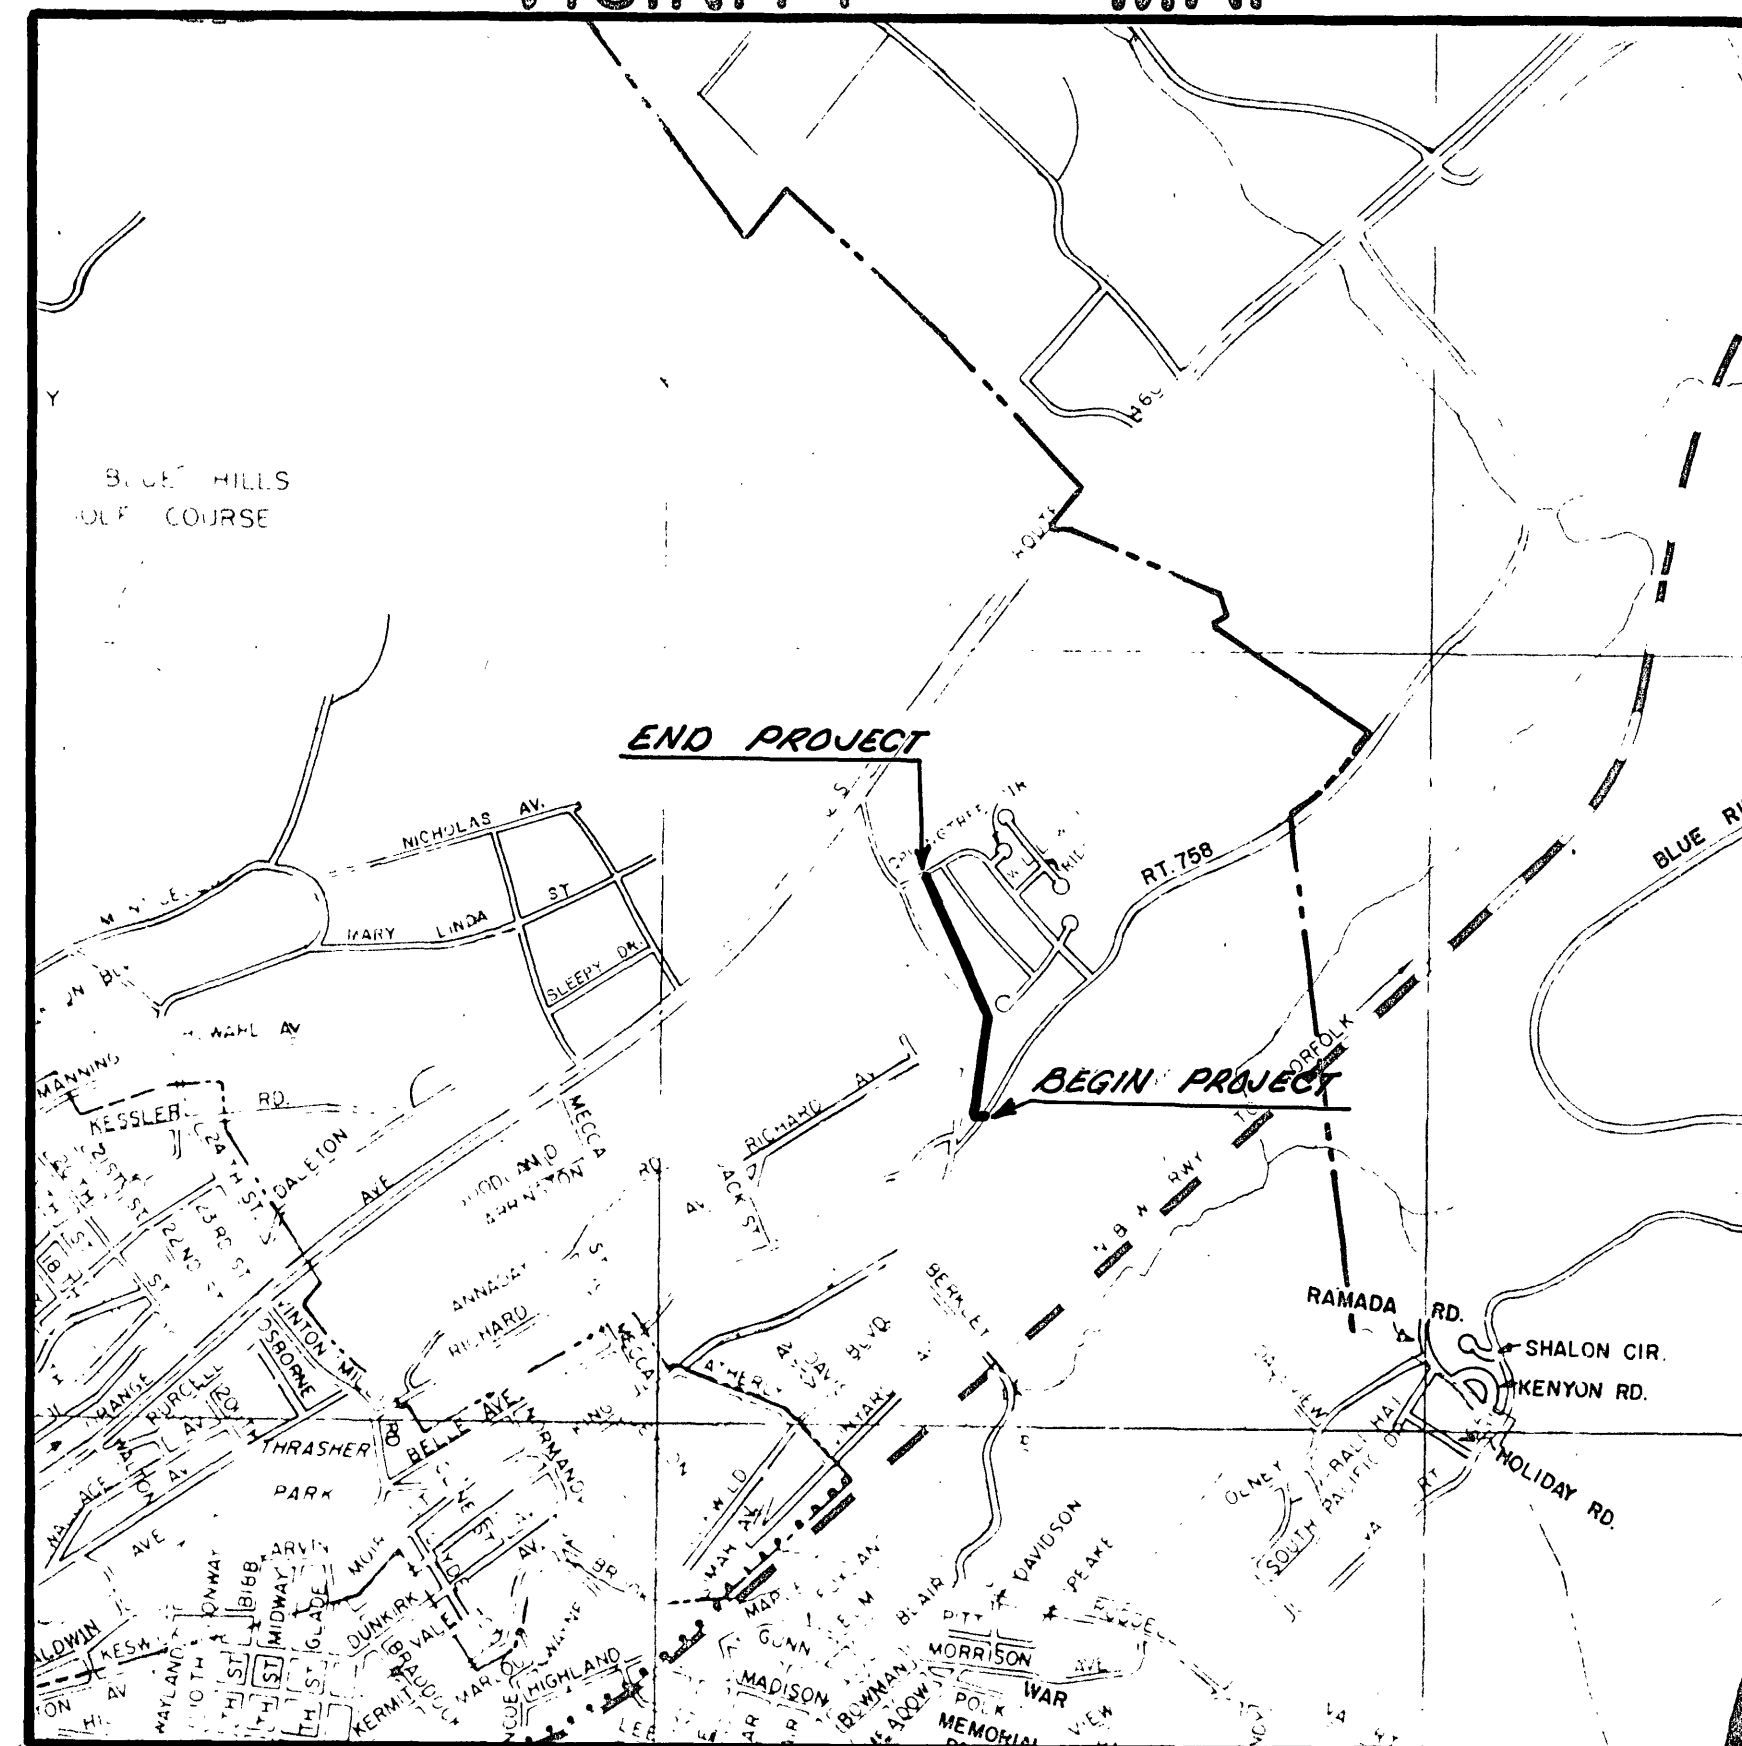

NO SCALE

INDEX OF SHEETS	
SHEET NO.	DESCRIPTION
1	COVER SHEET
2	QUANTITY SHEET
3 thru 6	PLAN AND PROFILE SHEETS



ROANOKE , VIRGINIA

OFFICE OF CITY ENGINEER

CONSTRUCTION PLAN

FOR

GLADE CREEK

SANITARY SEWER SUB-MAIN
EXTENSION

AS BUILT

As BUILT REVISION
DATE: 12-15-83
E. S.

ADDENDUM NO. 1

1, 2, and 6	24 SEPT-80		
SHEET NO.	DATE	SHEET NO.	DATE

APPROVED FOR CONSTRUCTION	
10 Sept 80 DATE	Richard B. Bunker CITY ENGINEER
DATE	
DATE	
APPROVED
DATE
APPROVED
DATE

SHEET - 1 OF 6

PLAN NO. 5755