



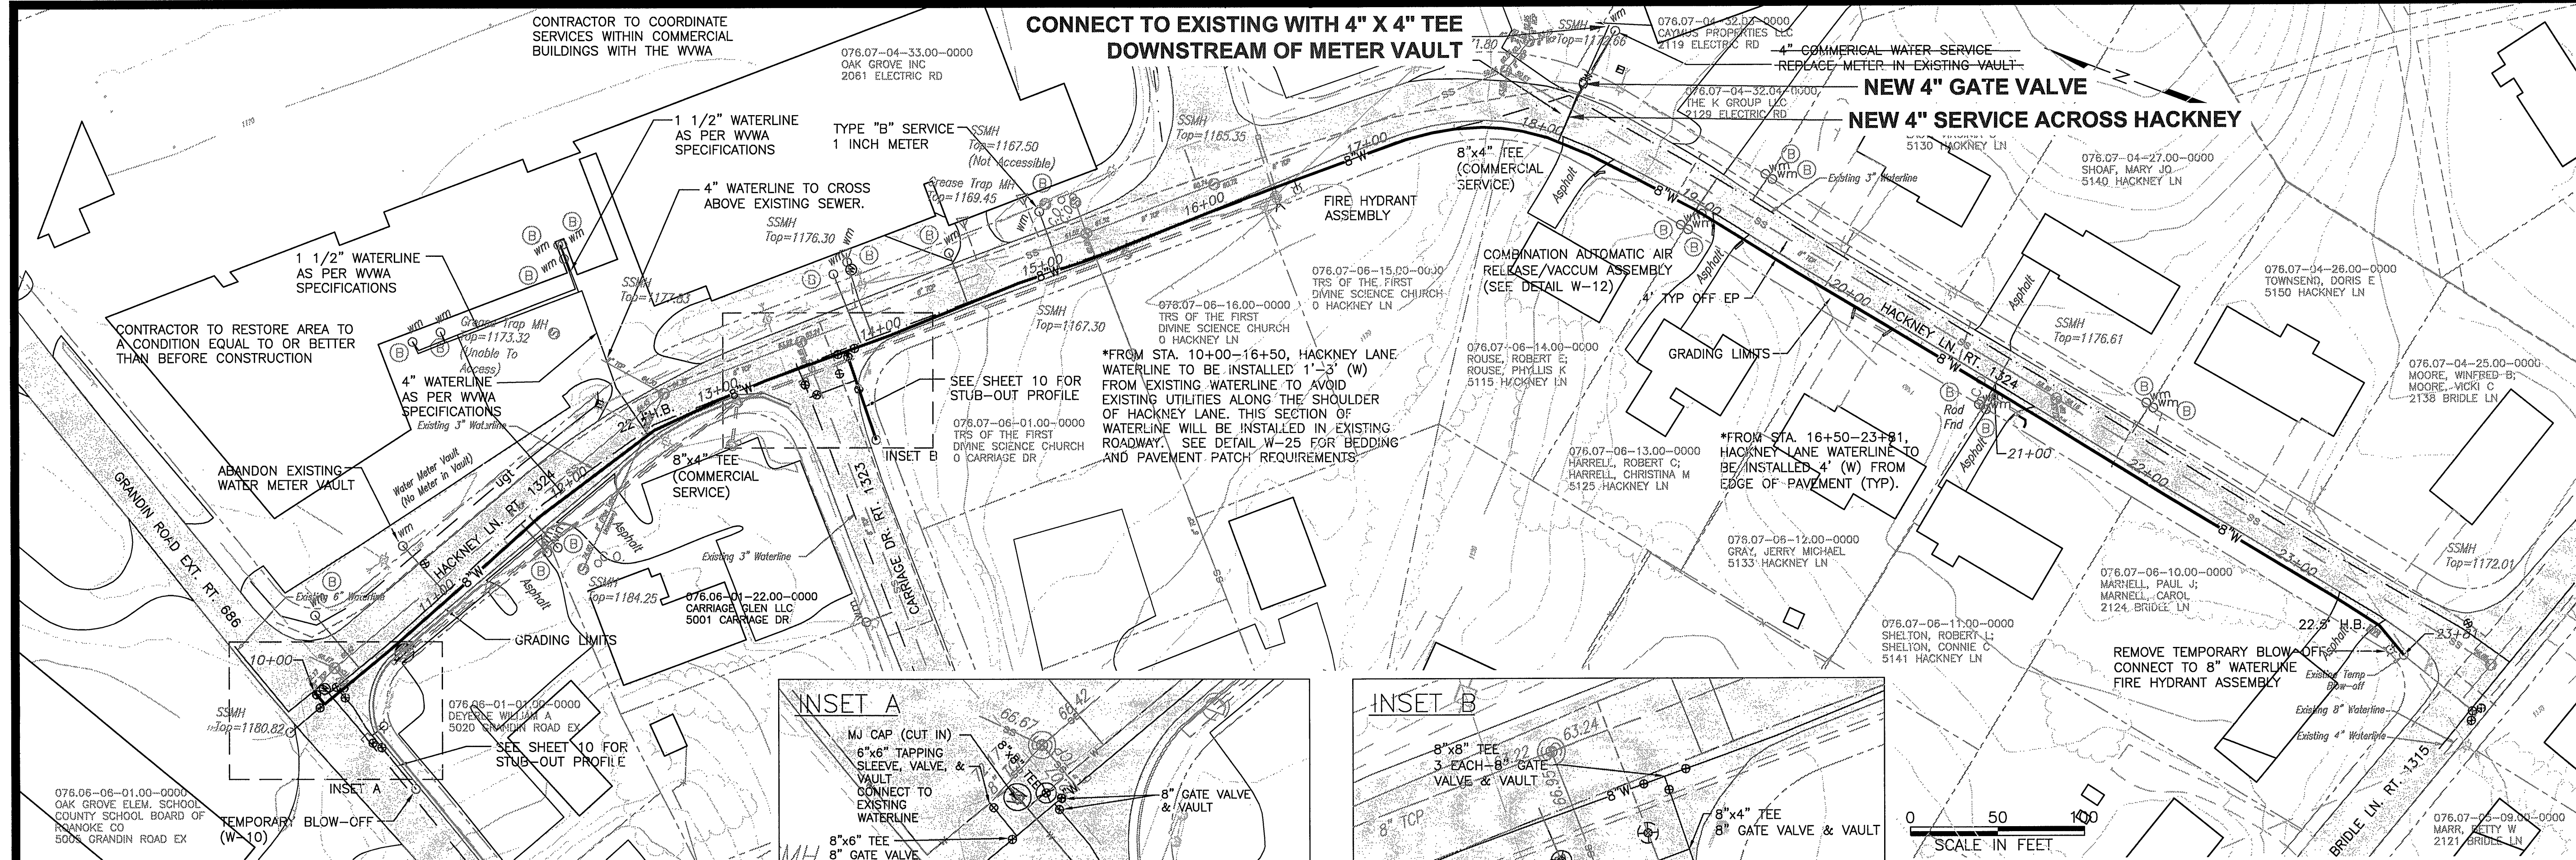

- PROJECT NOTES:
1. ALL DISTURBED AREAS SHALL BE SEEDED, MULCHED, AND RETURNED TO CONDITIONS GREATER THAN OR EQUAL TO CONDITIONS PRIOR TO CONSTRUCTION.
 2. ALL WATER SERVICES CROSSING THE ROAD SHALL BE BORED UNDER THE PAVEMENT.
 3. CONNECTIONS TO EXISTING SYSTEM SHALL BE MADE "DRY" WHEN POSSIBLE. CONTRACTOR TO COORDINATE WITH WESTERN VIRGINIA WATER AUTHORITY INSPECTOR TO SHUT OFF WATER.

FOR ADDITIONAL REQUIRED ESC MEASURES FOR THE INSTALLATION OF THE WATER LINE SEE TYPICAL ESC DETAILS ON SHEET 1G.

HACKNEY LN WATERLINE

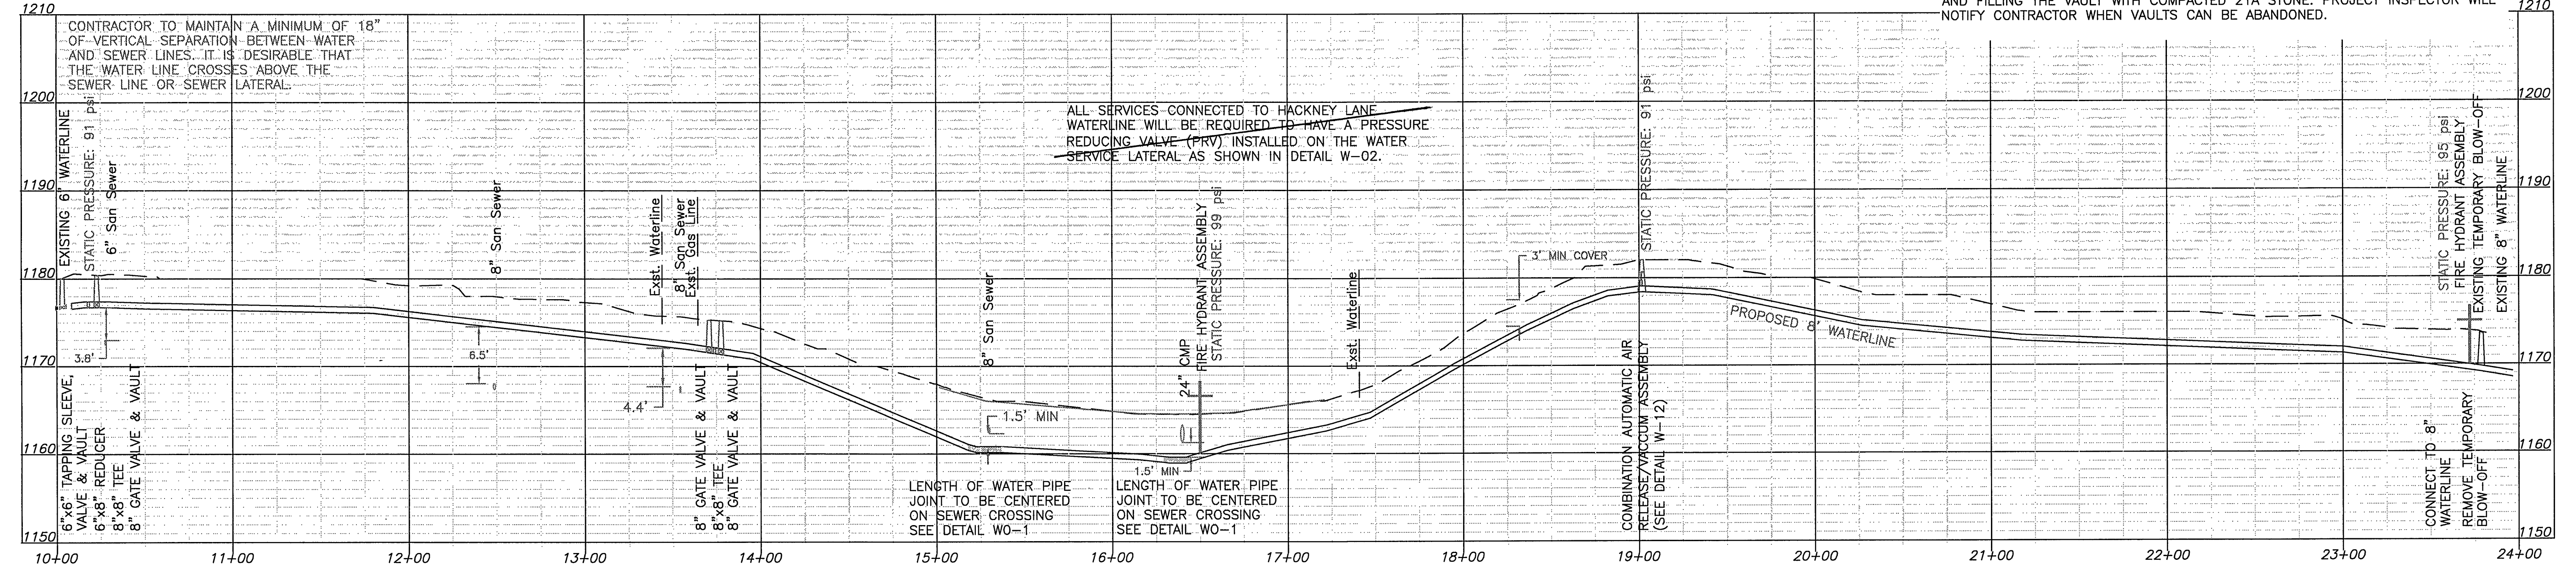

ANDERSON & ASSOCIATES, INC.
Professional Design Services
www.andassoc.com
VA - NC - TN - WV

100 Ardmore St.
Blacksburg, Va. 24060
540-552-5592

WATERLINE PLAN & PROFILE IV
GLEN HEATHER FARMS AREA
WATER LINE REPLACEMENTS
PHASE I
AS-BUILT BY WWA

Designed By:	TFB
Drawn By:	CBG/LTB
Checked By:	JKD
Date:	13 JAN 2010
Revised:	09 JUL 2010 01 FEB 2010 09 APR 2010 22 JUN 2010
Scale:	HORZ: 1" = 50' VERT: 1" = 10'
Plan #:	27379-002
Sheet:	5 OF 10