


DEVELOPMENT PLAN

FOR

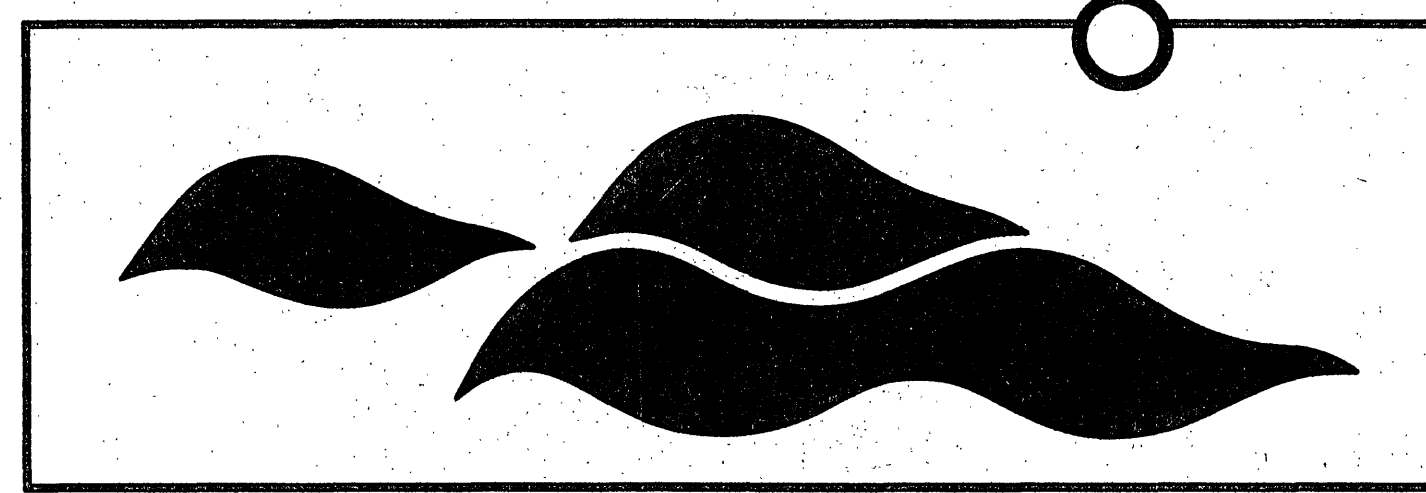

GLEN IVY


SITUATED IN

ROANOKE, VIRGINIA

DATE: 1 MARCH 1995
"AS-BUILT" 23 JUNE 1995

PROPERTY OF

RADFORD & COMPANY

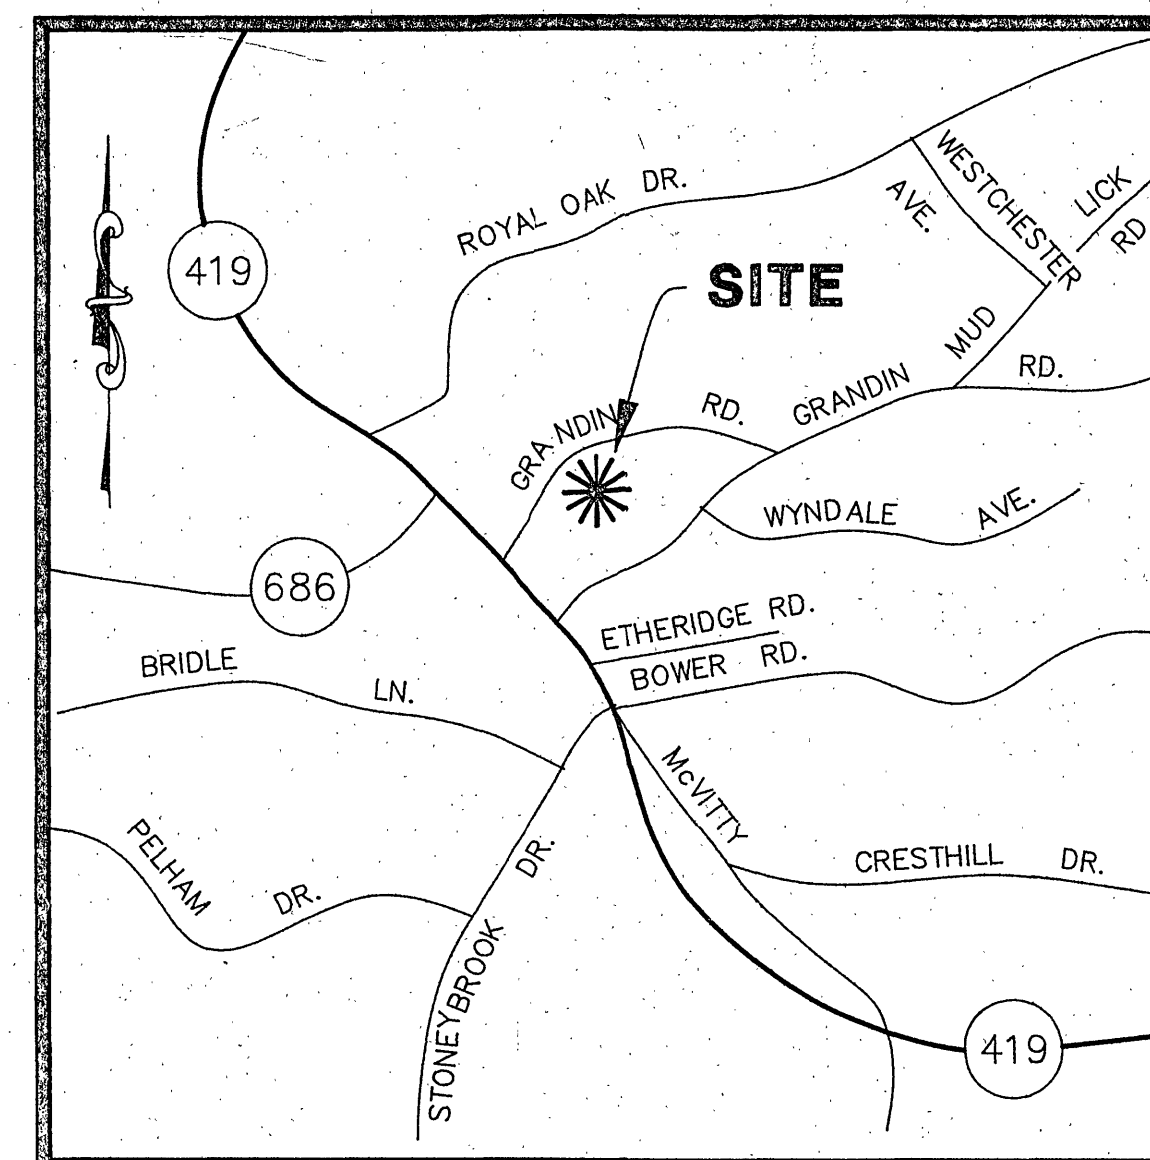

INDEX OF DRAWINGS

SHEET No.	DESCRIPTION
-----------	-------------

- | | |
|-----|-----------------------------------|
| 1. | LUMSDEN ASSOCIATES COVER SHEET |
| 2. | NOTES & DETAILS |
| 3. | DIMENSIONAL LAYOUT & UTILITY PLAN |
| 4. | DIMENSIONAL LAYOUT & UTILITY PLAN |
| 5. | GRADING & STORM DRAINAGE PLAN |
| 6. | GRADING & STORM DRAINAGE PLAN |
| 7. | SANITARY SEWER PROFILES |
| 8. | STORM DRAINAGE PROFILES |
| 9. | ROAD PROFILES |
| 10. | EROSION CONTROL PLAN |
| 11. | EROSION CONTROL PLAN |
| 12. | EROSION CONTROL DETAIL SHEET |
| 13. | LANDSCAPE PLAN |
| 14. | LANDSCAPE PLAN |
| 15. | SEDIMENT BASIN DETAILS |

RECEIVED

AUG 17 1995

CITY OF ROANOKE
DEPARTMENT OF PLANNING AND
COMMUNITY DEVELOPMENT

Glen Ivy
"AS-BUILT"

NOTE:

- "AS-BUILT" INFORMATION TAKEN FROM PLANS FURNISHED BY J.P. TURNER & BROTHERS, INC., CONTRACTOR.
- "AS-BUILT" DIMENSIONS SHOWN IN BRACKETS.

LUMSDEN ASSOCIATES, P.C.
ENGINEERS-SURVEYORS-PLANNERS
ROANOKE, VIRGINIA