
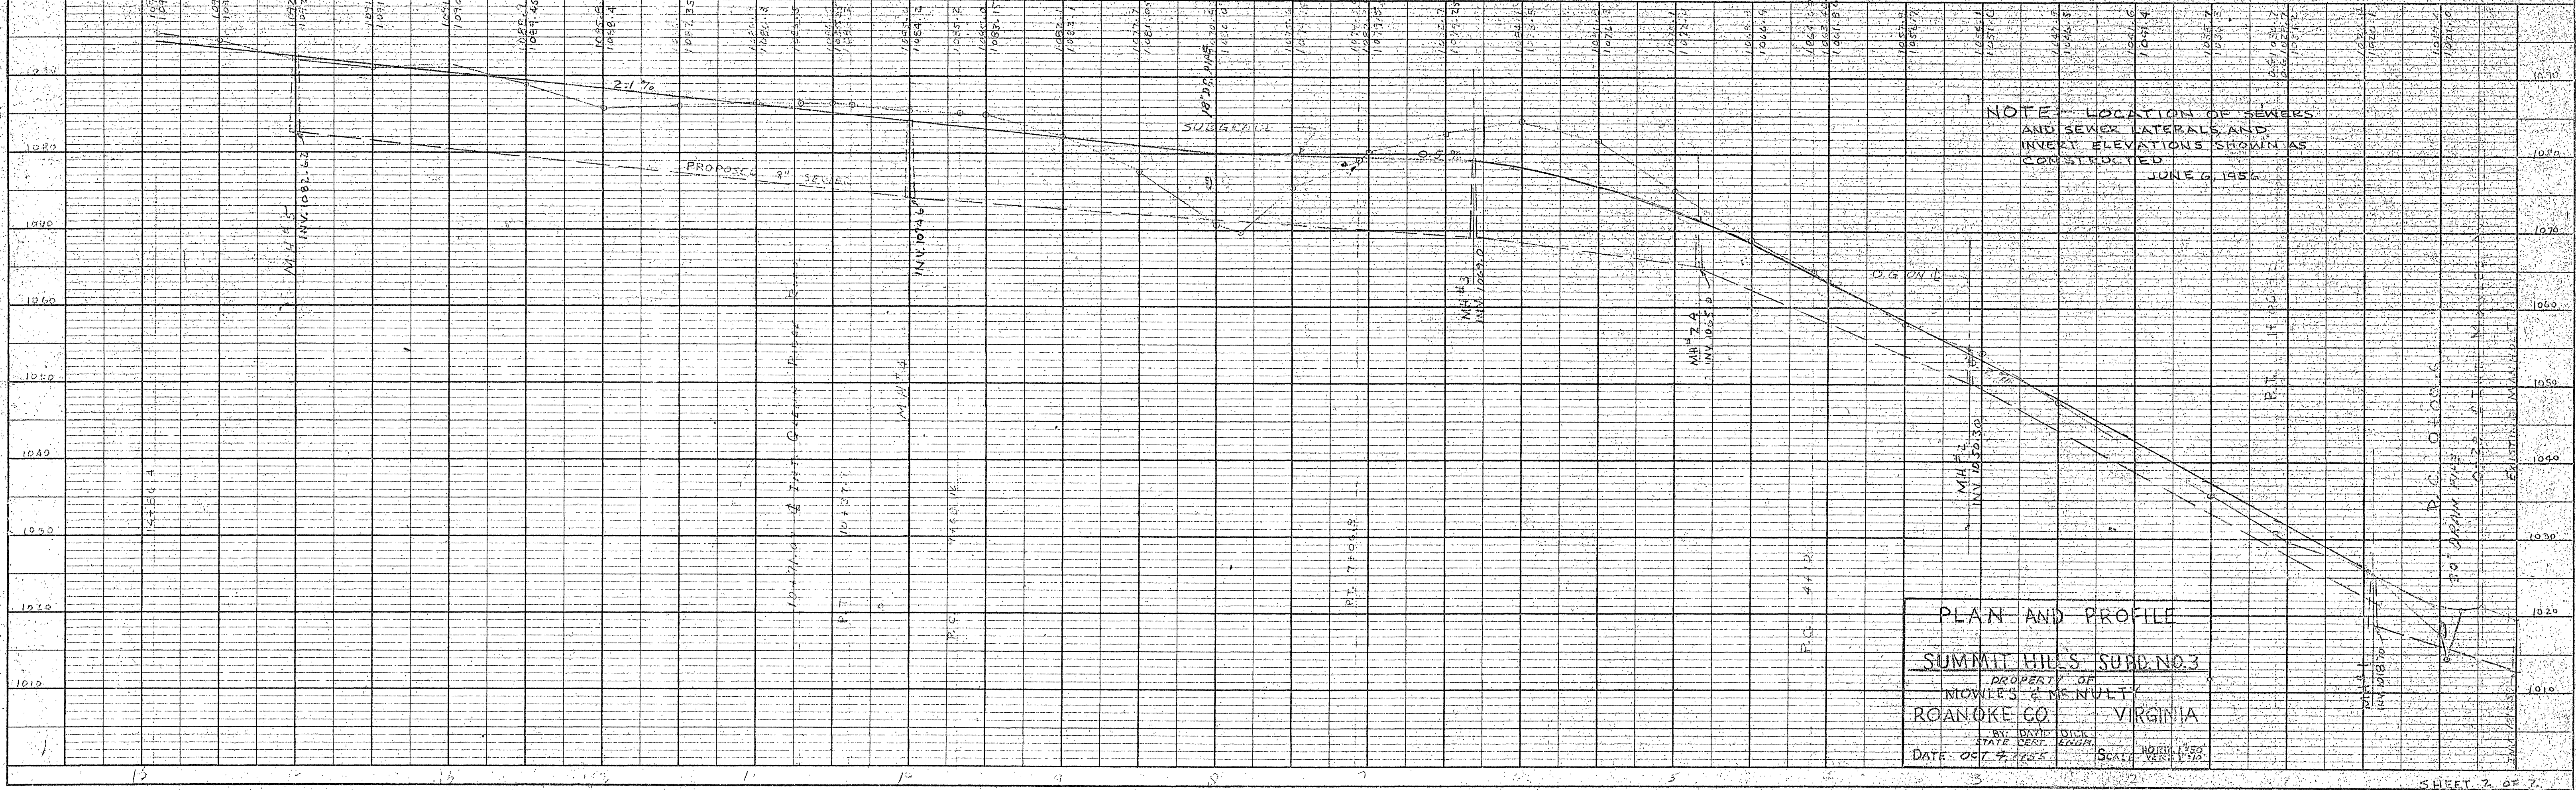


PLAN	DATE
BY	
SURVEYED	
PLOTTED	
ALIGNED CHECKED	
NOTE BOOK	
NO.	

PROFILE	DATE
BY	
SURVEYED	
PLOTTED	
BRACE CHECKED	
STRUCTURE NOTING CHECKED	
NOTE BOOK	
NO.	

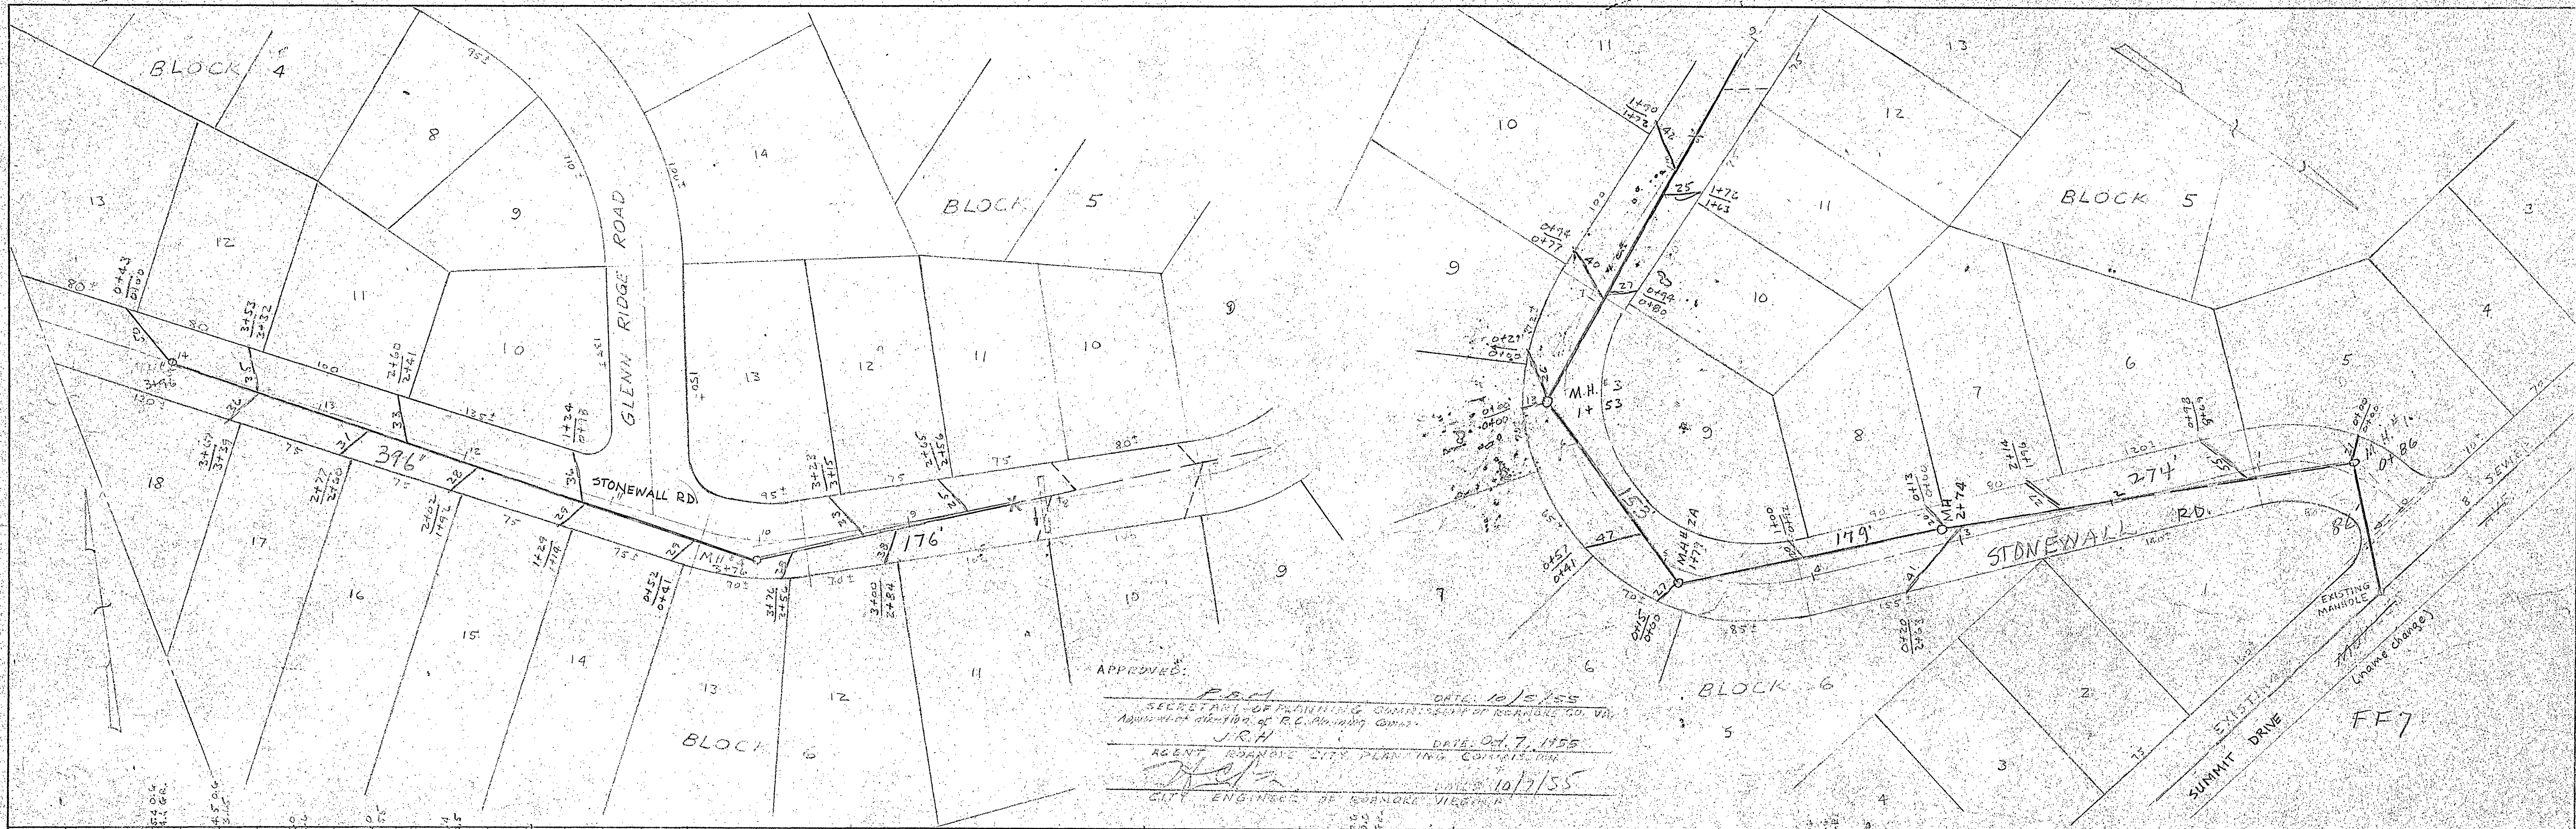

NOTE - LOCATION OF SEWERS AND SEWER LATERALS AND INVERT ELEVATIONS SHOWN AS CONSTRUCTED JUNE 6, 1956

PLAN AND PROFILE
SUMMIT HILLS SUBD. NO. 3
PROPERTY OF
MOWLES & MENULT
ROANOKE CO. VIRGINIA
DATE: OCT. 2, 1955
SCALE: 1" = 40'