

GENERAL NOTES

PRE-CONSTRUCTION MEETING AND CONSTRUCTION COMMENCEMENT:

- All construction methods and materials shall conform to the Construction Standards and Specifications of Roanoke County, the Western Virginia Water Authority, and the Virginia Department of Transportation.
- Stormwater Management Agreements with an attached 8 1/2" x 11" or 8 1/2" x 14" plat must be approved and recorded prior to the pre-construction meeting.
- Once all required items are submitted to the County of Roanoke, the developer must contact the Development Review Coordinator to indicate that a pre-construction meeting needs to be scheduled. The pre-construction meeting will be scheduled with the owner/developer two (2) working days later.
- Please note the 2001 General Assembly revisions to Va Erosion and Sediment Control Law. Effective July 1, 2001, all land disturbing projects that require approval of an erosion and sediment control plan, grading or clearing permit shall require that the applicant provide the name of an individual who will be responsible for land disturbing activities and that this individual hold a Responsible Land Disturber (RLD) Certificate from the Department of Conservation and Recreation. The Responsible Land Disturber can be anyone from the Project team that is certified by the State of Virginia to be in charge of carrying out the land disturbing activity for the project.
- It is the responsibility of the owner/developer to notify the certified Responsible Land Disturber and the Utility Contractor to attend the pre-construction meeting.
- The Development Review Coordinator will schedule the pre-construction meeting with the County Review Engineer, the County Inspector, and the Western Virginia Water Authority and the Town of Vinton Public Works Department if applicable.
- An approved set of plans and all permits must be available at the construction site at all times.
- The developer and/or contractor shall supply all utility companies with copies of approved plans, advising them that all grading and installation shall conform to approved plans.
- The project engineer will inform the owner/developer verbally and in writing of the County's obligation to perform inspections on site. Everyone in the meeting will be required to sign a pre-construction checklist indicating their knowledge of Roanoke County's obligation to perform inspections on site.
- The Erosion Control Permit is given to the developer at this pre-construction meeting.
- The developer **MUST** contact the project inspector 24 hours before beginning any grading or construction on the property.
- The project inspector will visit the site within 48 hours of the developer's call to ensure that all necessary erosion and sediment control measures are properly installed according to the approved plan.
- All work shall be subject to inspection by Roanoke County, the Western Virginia Water Authority and the Virginia Department of Transportation inspectors.
- Contractors shall notify utilities of proposed construction at least two (2), but not more than ten (10) working days in advance. Area public utilities may be notified thru "Miss Utility": 1-800-552-7001.
- 100 year Floodway and Floodplain information shall be shown where applicable. FIRM Index Date shall be shown on the plans. The 100 year Floodway shall be staked prior to any construction.
- Grade stakes shall be set for all curb and gutter, culvert, sanitary sewer and storm sewer at all times of construction.
- The Department of Community Development shall be notified when a spring is encountered during construction.
- Construction debris shall be containerized in accordance with the Virginia Litter Control Act. No less than one litter receptacle shall be provided on site.
- The contractor shall provide adequate means of cleaning mud from trucks and/or other equipment prior to entering public streets or rights of ways. It is the contractors responsibility to insure that the streets are in a clean, mud and dust free condition at all times.
- Plan approval in no way relieves the developer or contractors of the responsibilities contained within the erosion and sediment control policies.
- Field construction shall honor proposed drainage divides as shown on plans.
- Field corrections shall be approved by the Roanoke County Engineering Division and/or the Western Virginia Water Authority and the Professional of Record, prior to such construction.
- The developer or contractor shall supply the County and the Western Virginia Water Authority with correct As-Built plans before final acceptance.


VIRGINIA DEPARTMENT OF TRANSPORTATION:

- Plan approval by Roanoke County does not guarantee issuance of any permits by the Virginia Department of Transportation.
- A permit must be obtained from the Virginia Department of Transportation, Salem Residency Office prior to construction in the highway right-of-way.
- The preliminary pavement designs should be based on a predicted sub-grade CDR value of 7.0 and with a Resiliency Factor (RF) of 2.0 as shown in Appendix 1 of the 2000 Virginia Department of Transportation Pavement Design Guide for Subdivision and Secondary Roads. The sub-grade soil is to be tested by an independent laboratory and the results submitted to the Virginia Department of Transportation prior to base construction. Should the sub-grade CBR value and/or the RF value be less than the predicted values, additional base material will be required in accordance with Departmental specifications. Refer to the same manual as the number and locations of the required soil samples to be tested. All pavement designs shall be submitted to the Department for review and approval. The sub-grade shall be approved by the Virginia Department of Transportation prior to placement of the base. Base shall be approved by the Virginia Department of Transportation for depth, template, and compaction before the surface is applied.
- Standard guardrail with safety end sections may be required on fills or in areas where hazards exist as deemed necessary. After completion of rough grading operations, the County Engineer and Virginia Department of Transportation shall be contacted to schedule a field review. When guard rail is warranted, the standard shoulder width shall be provided and the guard rail shall be installed in accordance with the 2001 VDOT Road and Bridge Standards as part of this development.
- Standard street and traffic control signs shall be erected at each intersection by the developer prior to final street acceptance.
- All traffic devices shall be in accordance with current edition of the manual: "Uniform Traffic Control Devices (MUTCD)"
- All unsuitable material shall be removed from the construction limits of the roadway before placing embankment.

The Project Engineer shall provide electronic copies of the approved plans to the Development Review Coordinator within 5 working days of the pre-construction meeting. This sheet may not be modified.



County of Roanoke, Va

NAME OF DEVELOPMENT	GLENVAR HIGH SCHOOL - RENOVATIONS AND ADDITIONS	 OWNER/DEVELOPER, AM AWARE OF THE SITE DESIGN REQUIREMENTS IMPOSED BY THIS SITE DEVELOPMENT PLAN AND OTHER APPLICABLE ROANOKE COUNTY CODES. I HEREBY CERTIFY THAT I AGREE TO COMPLY WITH THESE REQUIREMENTS AND THE THIRTY (30) POINTS SHOWN ON THIS COVER SHEET UNLESS MODIFIED IN ACCORDANCE WITH LOCAL LAW.
MAGISTERIAL DISTRICT(S)	CATAWBA	
OWNER (name, address, telephone)	ROANOKE COUNTY PUBLIC SCHOOLS 5937 COVE ROAD ROANOKE, VA 24019 Phone: 540-562-3800	
DEVELOPER (name, address, telephone)	ROANOKE COUNTY PUBLIC SCHOOLS 5937 COVE ROAD ROANOKE, VA 24019 Phone: 540-562-3800	
ENGINEER, ARCHITECT OR SURVEYOR (name, address, telephone)	SPECTRUM DESIGN, P.C. PLAZA SUITE 1, 10 CHURCH AVE, SE ROANOKE, VA 24011 Phone: 540-342-6001	
TAX MAP NO(S)	054.02-04-02	

WATER NOTES

All water facilities shall be installed according to the Western Virginia Water Authority Regional Design and Construction Standards/ (Latest Edition).

A minimum cover of three (3) feet is required over proposed lines.

Contractor shall be responsible for locating and uncovering valve vaults after paving and adjustment to final grade if necessary.

All existing utilities may not be shown in their exact location. The contractor shall comply with the (State Water Works Regulations, Section 12VAC5-590-1150, where lines cross.


All trenches in existing or future highway right-of-ways shall be compacted according to Virginia Department of Transportation standards.

Lines shall be staked prior to construction.

Water main shall be minimum Class 350 Ductile Iron in accordance to AWWA C151 or DR-14 PVC in accordance with AWWA C-900.

Ductile Iron Pipe in accordance with the Western Virginia Water Authority Regional Design and Construction Standards shall be required for all pipe with a working pressure equal to or greater than 100 p.s.i.

Western Virginia Water Authority
Availability letter number: 12-340

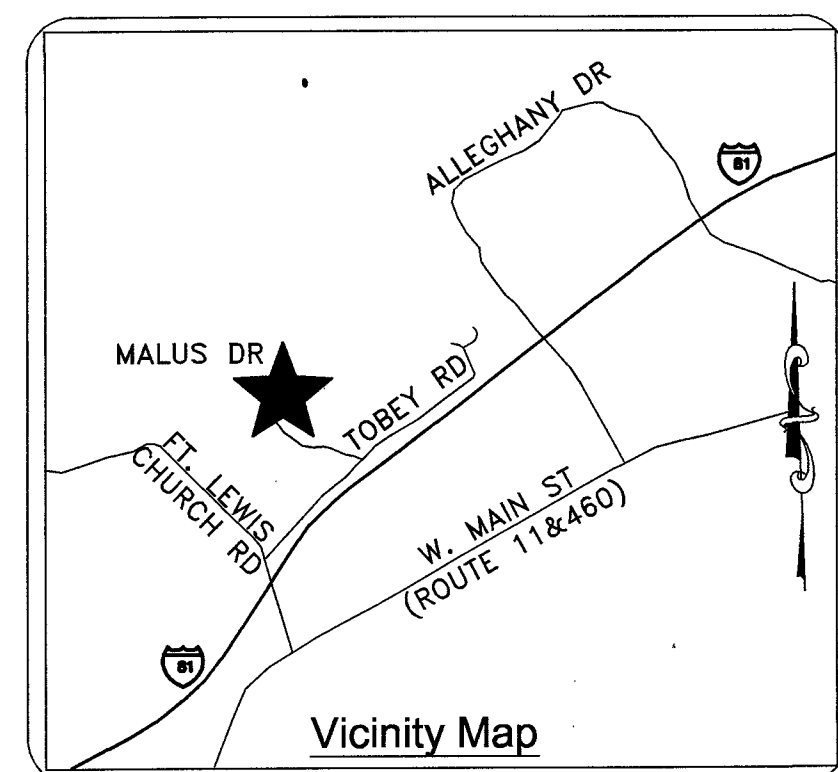

LEGEND

Property Line	---	R
Right-of-way	---	R/W
Centerline	---	CL
Minimum Building Line	---	MBL
Existing Storm Sewer	---	18" SD
Existing Sanitary Sewer	---	8" SS
Existing Water Main	---	4" W
Existing Contour	---	1045
Proposed Contour	---	1045
Proposed Drainage Divide	---	24" S.D.
Proposed Storm Sewer	---	8" M.H.
Proposed Sanitary Sewer	---	8" M.H.
Proposed Water Main	---	HYDRANT VALVE BLOWOFF

SEWER NOTES

All sanitary sewer facilities shall be installed according to the Western Virginia Water Authority Regional Design and Construction Standards. (Latest Edition).

A minimum cover of three (3) feet is required over proposed lines.

Contractor shall be responsible for locating and uncovering all manholes after paving. Manhole tops shall be adjusted to grade if necessary.

All existing utilities may not be shown in their exact location. The contractor shall comply with (State Water Works Regulations, Section 12VAC5-590-1150, where lines cross.)

All trenches in existing or future rights-of-way shall be compacted according to Virginia Department of Transportation standards.

Lines shall be staked prior to construction.

RETAINING WALLS

A separate review and building permit application are required for all retaining wall(s). A copy of the approved site plan must be submitted with the building permit application for the retaining wall(s) plan.

PRIVATE UTILITIES

Underground utilities installed on private property or in private utility easements and building related storm drains shall be designed and installed per the current edition of the Virginia Uniform Statewide Building Code. Design and installation requirements issued by the Western Virginia Water Authority that meet or exceed the USBC requirements are acceptable for private utilities. All private utilities are to be permitted through and inspected by the Roanoke County Inspections Office. Vaults, valves and other devices installed by or under the control of the Western Virginia Water Authority may not be substituted for the code required devices.

Index

C000	COVER SHEET
C101	OVERALL DEVELOPMENT PLAN
C102	EXISTING CONDITIONS & DEMOLITION PLAN
C103	CONSTRUCTION PHASING PLAN
C104	EROSION & SEDIMENT CONTROL PLAN - PHASE I
C105	EROSION & SEDIMENT CONTROL PLAN - PHASE II
C106	UTILITY PLAN - WEST - <i>Garage Tap</i>
C107	UTILITY PLAN - EAST - <i>Water Tie-In</i>
C108	GRADING PLAN - WEST
C109	GRADING PLAN - EAST
C110	DIMENSIONAL PLAN - WEST
C111	DIMENSIONAL PLAN - EAST
C112	CONNECTOR ROUTE - ESC, GRADING & DIMENSIONAL PLAN
C113	FUEL LOT - ESC, GRADING & DIMENSIONAL PLAN
C114	BAND SHED - ESC, GRADING & DIMENSIONAL PLAN
C115	ADD ALTERNATE ITEMS
C116	FUEL ISLAND DETAILS
C117	ROAD PROFILES
C201	STORM DRAIN PROFILES
C202	STORM DRAIN PROFILES (CONTD)
C203	SANITARY SEWER PROFILES
C401	SITE RETAINING WALL PLAN AND DETAILS
C501	EROSION & SEDIMENT CONTROL NARRATIVE
C502	EROSION & SEDIMENT CONTROL DETAILS
C503	EROSION & SEDIMENT CONTROL DETAILS
C504	UTILITY DETAILS - <i>Water Details</i>
C505	GRADING & DRAINAGE DETAILS
C506	CONSTRUCTION DETAILS
C507	CONSTRUCTION DETAILS
C508	CONSTRUCTION DETAILS
C901	GEO THERMAL PLAN
C902	GEO THERMAL DETAILS
L101	LANDSCAPE PLAN - WEST
L102	LANDSCAPE PLAN - EAST
L501	LANDSCAPE DETAILS

SURVEY INFORMATION

Horizontal and vertical control surveys were performed in year: 2013
By: BALZER AND ASSOCIATES

All vertical elevations must be referenced to the National Geodetic Vertical Datum of 1929 or 1988. All horizontal elevations must be referenced to the North American Datum of 1927 or 1983.

Source of topographic mapping is dated 12/05/13

Boundary was performed by BALZER & ASSOC. dated: 12/05/13

Benchmark Information: SW CORNER, CONC HEADWALL-NEAR EX. FIELD HOUSE
NAVD88 VERTICAL DATUM = 1242.50

The professional seal and signature certifies the boundary survey and topographic mapping to be accurate and correct.

QUANTITY & COST ESTIMATE

ITEM	QUANTITY	UNIT	UNIT PRICE	COST	BONDABLE
CLEARING AND GRUBBING	0.75	ACRES			
EXCAVATION		C.Y.			
SITE DEMOLITION	28,175	S.Y.			
VDOT CURB INLET DI-3	12	EACH			
CURB INLET DI-1		EACH			
VDOT DROP INLET	11	EACH			
MANHOLE MH-1	2	EACH			
WATER QUALITY STRUCTURE	7	EACH			
STORM DRAIN PIPING	2398	LIN. FT.			
RAIN LEADER PIPING	2499	LIN. FT.			
12"-IN. CONCRETE PIPE, CLASS III		LIN. FT.			
-IN. C.M. CULVERT		LIN. FT.			
-IN. C.M. CULVERT		LIN. FT.			
BIO-RETENTION BASIN		LUMP SUM			
BOX CULVERT		LUMP SUM			
PAVED DITCH		LIN. FT.			
RIPRAP - CLASS		S.F.			
SODDED SWALE		S.Y.			
VDOT CONCRETE ENDWALL	2	EACH			
-IN. END SECTION ES-		EACH			
CURB & GUTTER CG-6	830	LIN. FT.			
CURB CG-2	5982	LIN. FT.			
VALLEY GUTTER		EACH			
GRAVEL BASE		S.Y.			
CONCRETE WALKS	4029	S.Y.			
GRAVEL SHOULDER		S.Y.			
SURFACE TREATMENT		S.Y.			
BIT ASPHALT	17,519	S.Y.			
PERVIOUS PAVEMENT	2872	S.Y.			
6" CONCRETE		S.Y.			
6" PERVIOUS CONCRETE		S.Y.			
3&5-IN. BASE MATERIAL		C.Y.			
8-IN. SUBBASE MATERIAL		C.Y.			
STRIPING	9081 LF	LUMP SUM			
WATER LINE	2867	LIN. FT.			
6" WATER LINE		LIN. FT.			
4" WATER LINE		LIN. FT.			
FIRE HYDRANT ASSEMBLIES	4	EACH			
BLOW OFFS W/VAULT, FRAME & COVER		EACH			
6-IN. GATE VALVES, W/VAULT, FRAME & COVER		EACH			
8-IN. GATE VALVES, W/VAULT, FRAME & COVER		EACH			
WATER VAULT	1	EACH			
2-8" SANITARY SEWER	1451	LIN. FT.			
CLEANOUTS	7	EA			
STANDARD MANHOLE W/FRAME & COVER	8	EACH			
SAMPLING MANHOLE/PORT		EACH			
LANDSCAPING		LUMP SUM			
STORMWATER MANAGEMENT		LUMP SUM			
AS-BUILT PLANS (STORM SEWER SYSTEMS)		LUMP SUM			
AS-BUILT PLANS (STORMWATER MANAGEMENT)		LUMP SUM			
SUB TOTAL					
25% CONTINGENCY					
ESTIMATED TOTAL					

I HEREBY CERTIFY THAT THE FOREGOING ESTIMATE REFLECTS THE CURRENT IMPROVEMENT COSTS OF THIS PROJECT.

SIGNED:  DATE: 6/25/14

BONDING WAIVED FOR COUNTY PROJECTS

10 CHURCH AVE SE, PLAZA SUITE 1 ROANOKE, VIRGINIA 24011 540.342.6001
PROJECT #13054




Renovations & Additions
Glenvar High

4549 Malus Dr
Salem, Virginia 24153
VA DOE PROJECT #80-61-00-101


SHEET 1 OF 35

C000

As-Built
Substantial Completion:
04/01/2015

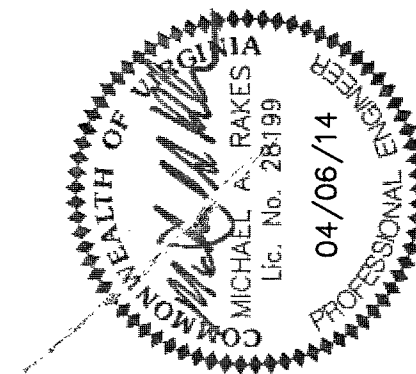

APPROVAL

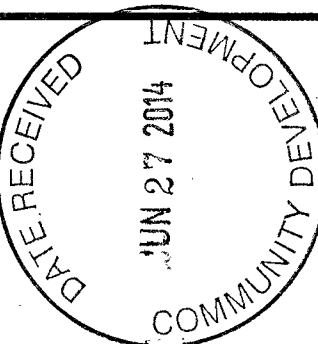

DEVELOPMENT PLAN APPROVED FOR CONSTRUCTION BY ROANOKE COUNTY	Date
Department	6/27/14
Development Review	6/27/14
Engineering	6/27/14
Water & Sewer	6/27/14
Planning & Zoning	6/28/14