



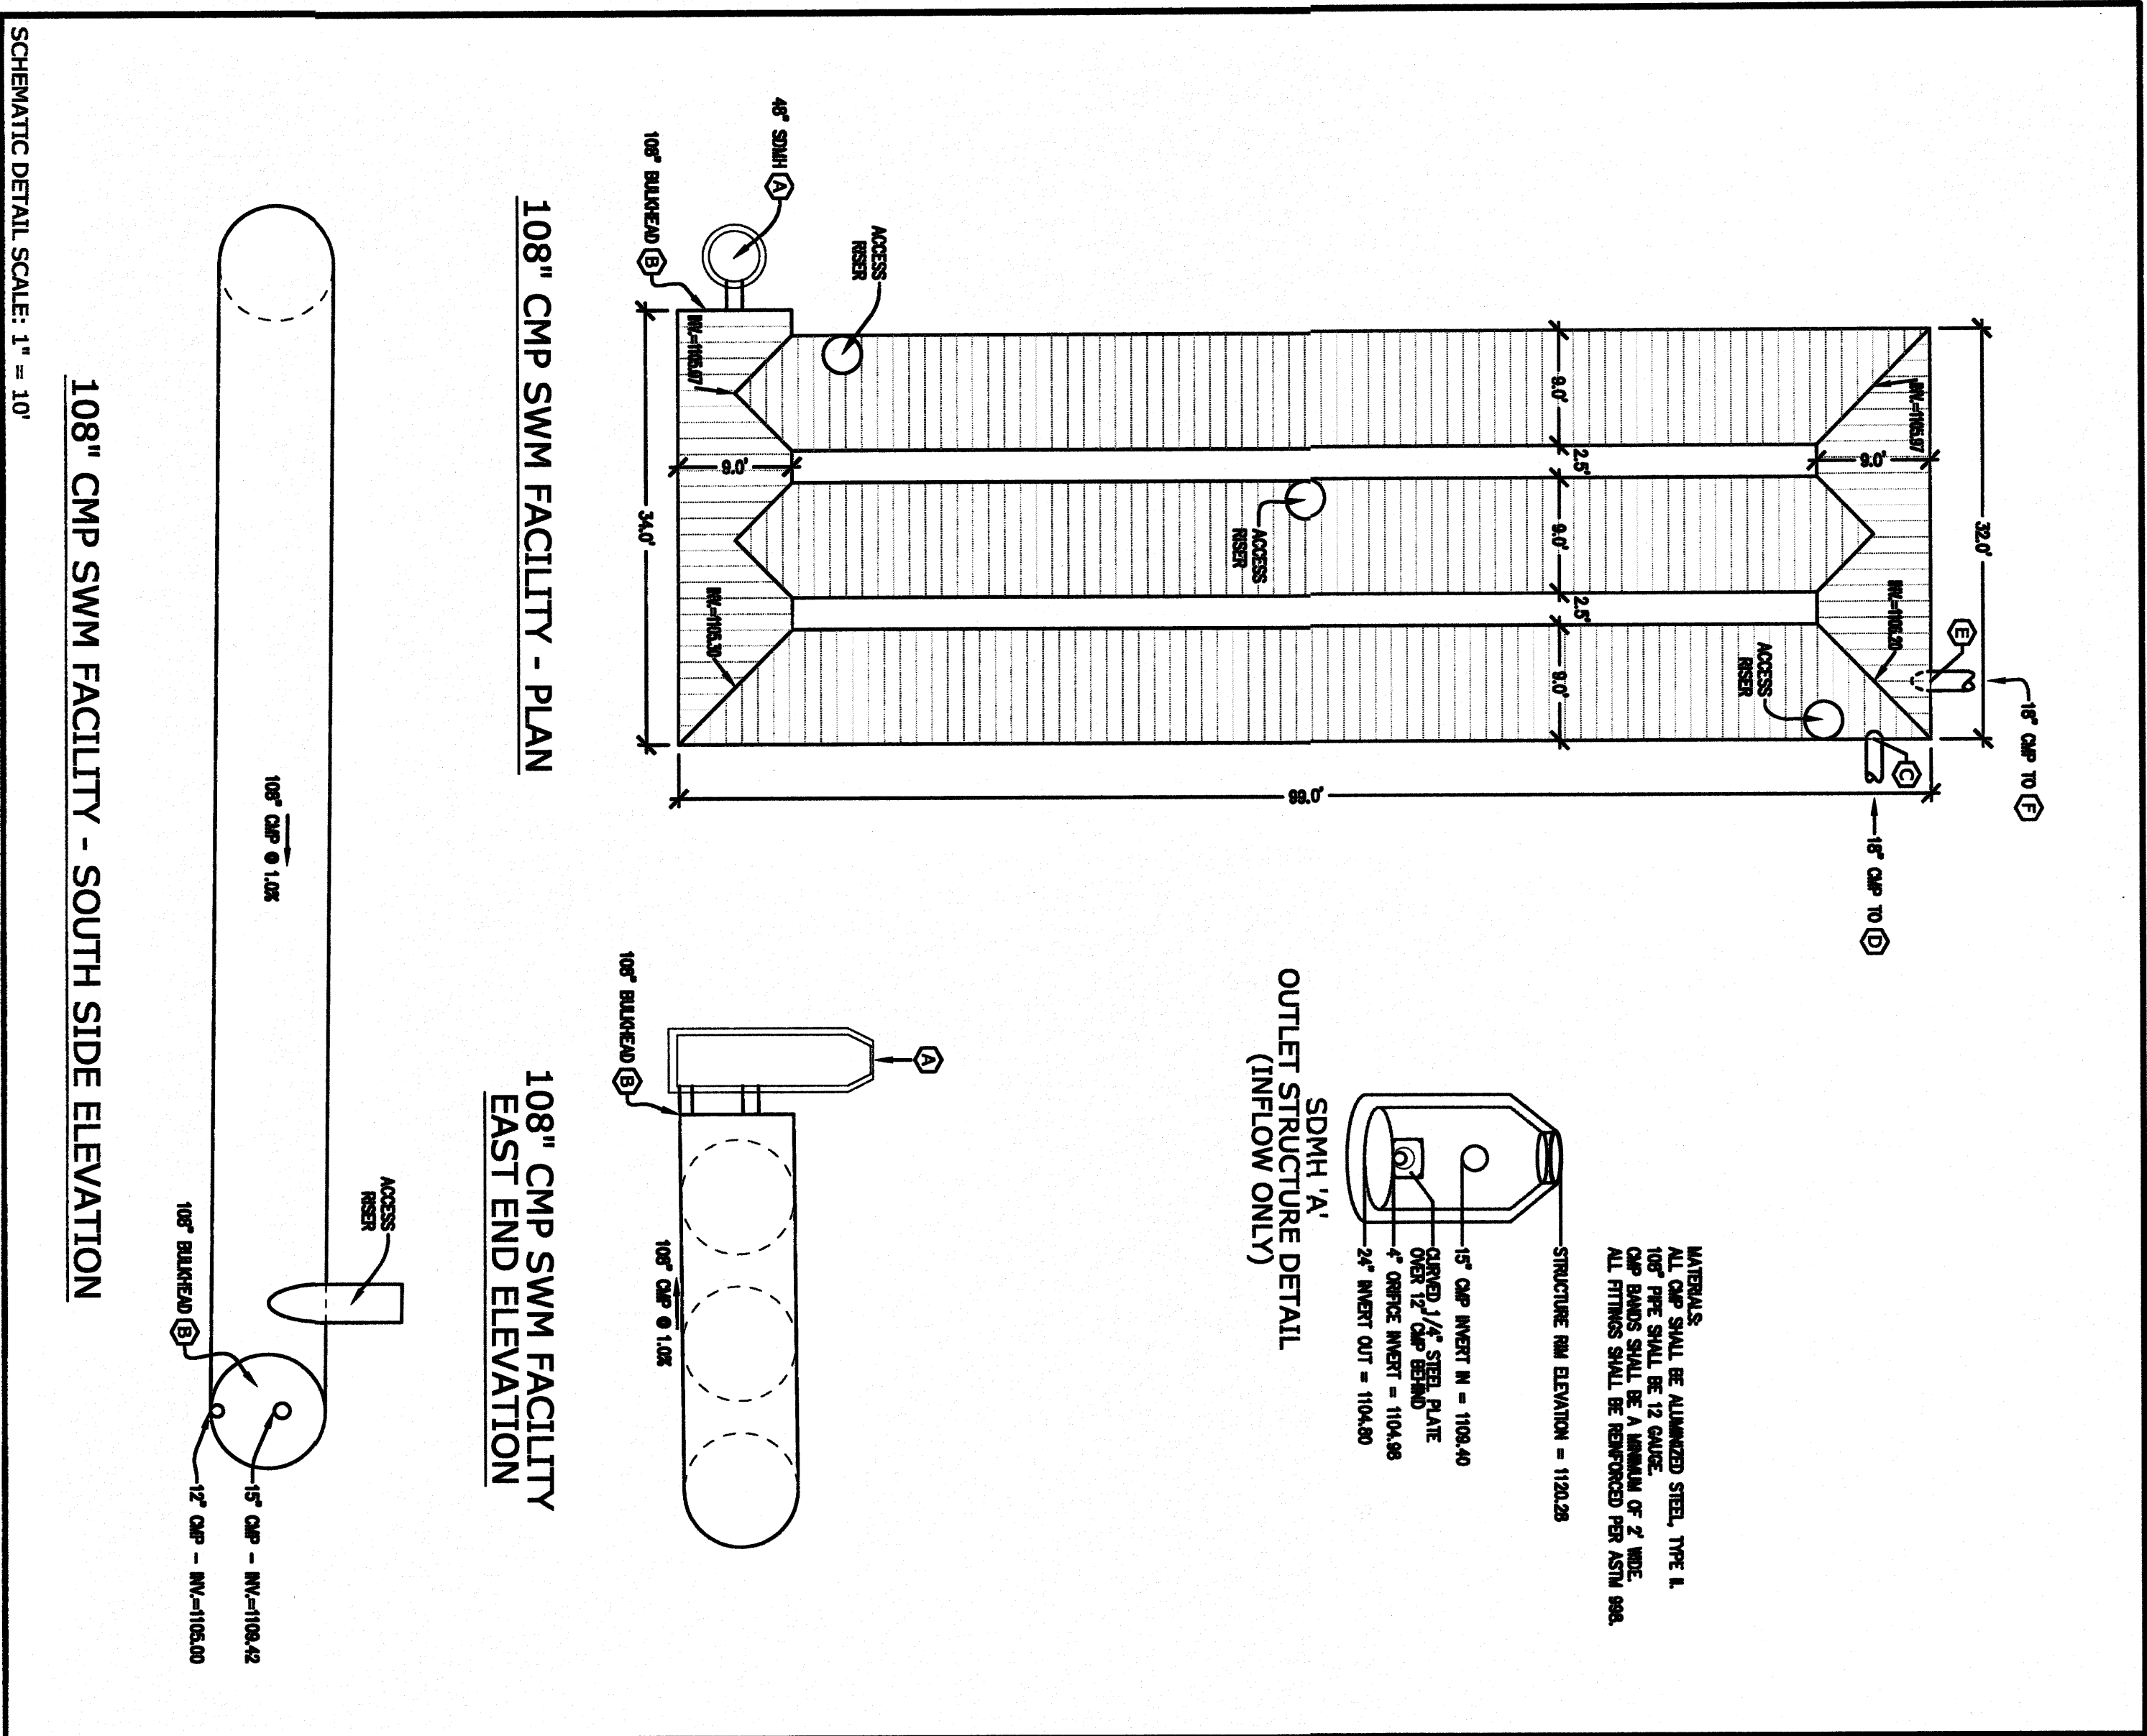

STORMWATER MANAGEMENT FACILITY
SCHEMATIC DETAILS

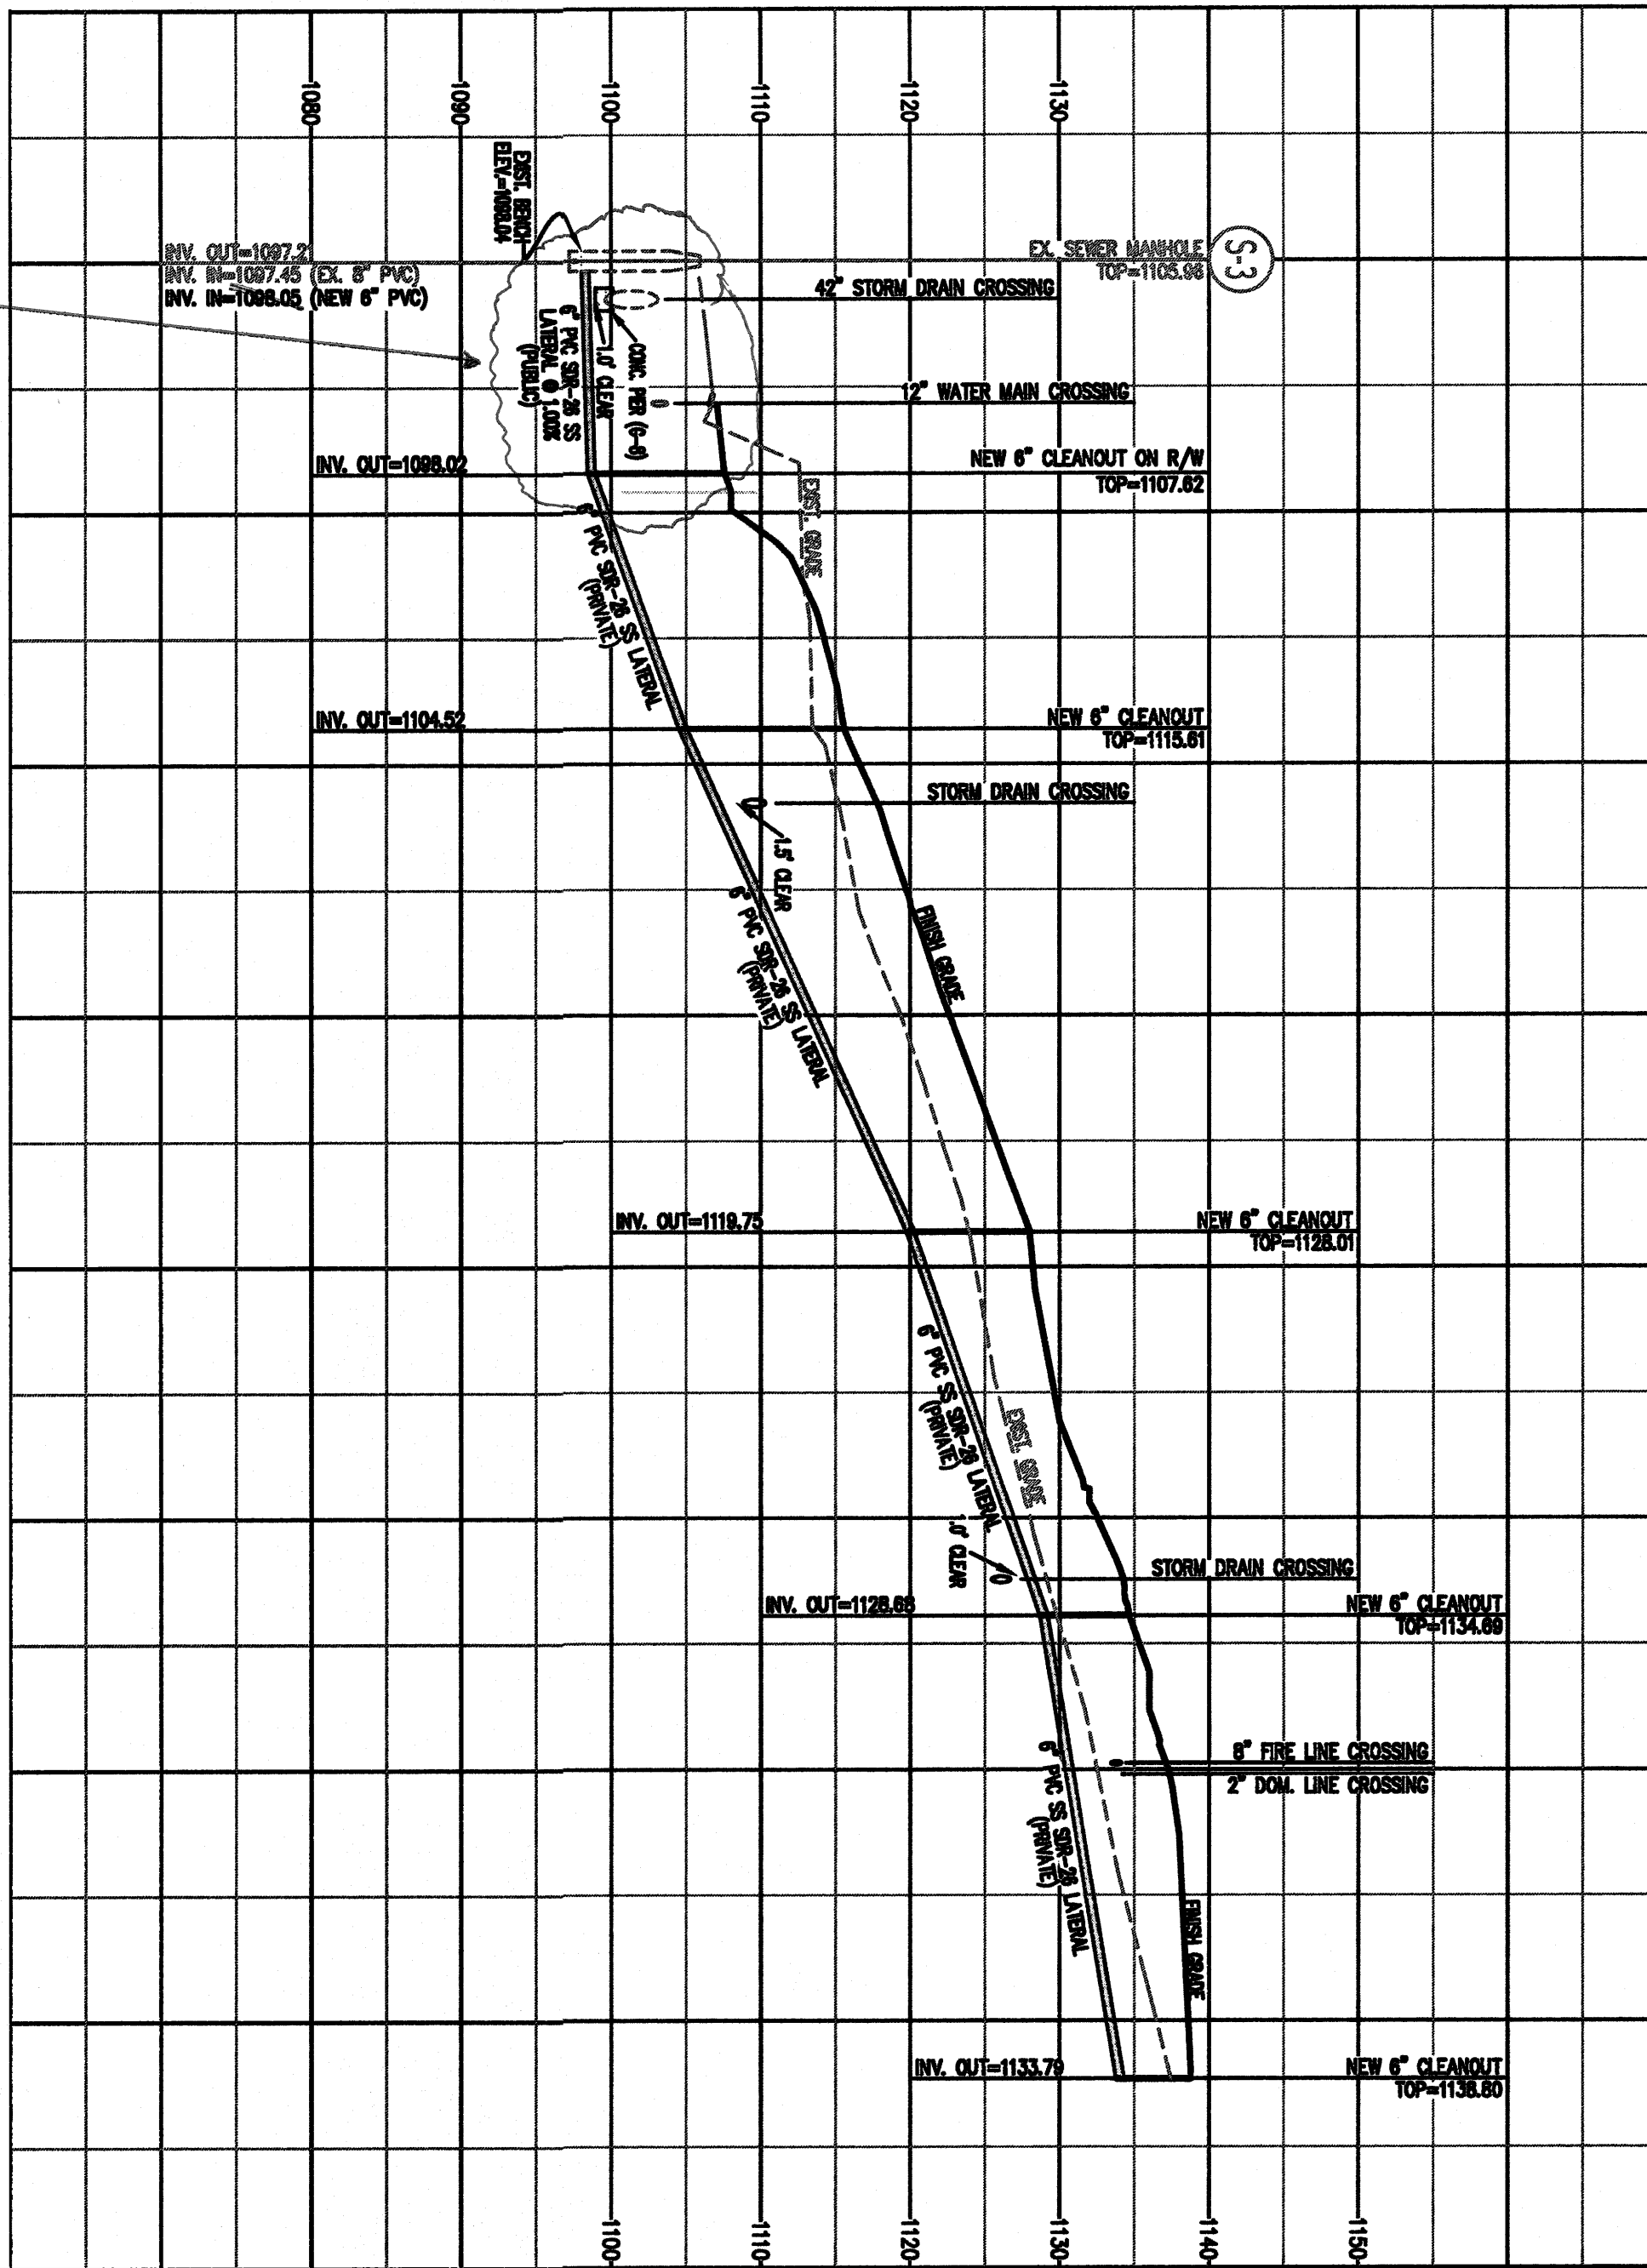


City of Roanoke Planning, Building, & Development COMPREHENSIVE DEVELOPMENT PLAN
APPROVED
by Aaron Opler 11/23/2022

NO.	DATE	DESCRIPTION
1		
2		
3		
4		
5		

DATE: October 26, 2022
SCALE: 1" = 30'(H); 1" = 10'(V)
COMMISSION NO.: 22-119
SHEET 7 OF 15

COMPREHENSIVE DEVELOPMENT PLAN
GOOD SAMARITAN
HOSPICE BUILDING
PREPARED FOR
GOOD SAMARITAN HOSPICE, INC.
SITUATED AT 4751 COVE ROAD, N.W.
CITY OF ROANOKE, VIRGINIA

SEWER LATERAL PROFILE
& STORMWATER
MANAGEMENT DETAILS

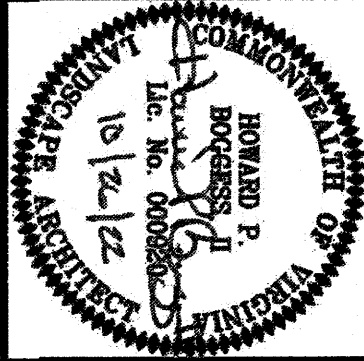

Lumsden Associates, P.C.
ENGINEERS | SURVEYORS | PLANNERS
4664 BRAMBLETON AVENUE
P.O. BOX 20669
ROANOKE, VIRGINIA 24018
PHONE: (540) 774-4411
FAX: (540) 772-9445
WWW.LUMSDENPC.COM