


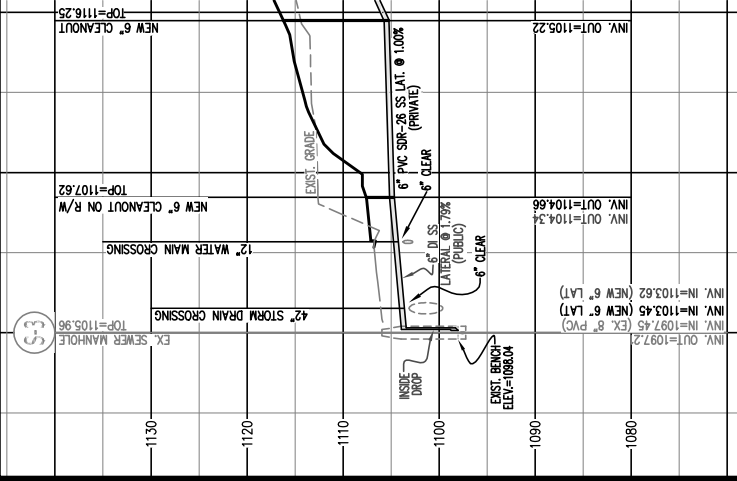

SANITARY SEWER LATERAL PROFILE


AS-BUILT

AS-BUILT INFORMATION SHOWN ON
THIS PLAN IS THE RESULT OF A
FIELD SURVEY PERFORMED
BY LUMSDEN ASSOCIATES, P.C. OR
AS SUPPLIED BY WELLS
CONSTRUCTION COMPANY INC.
(CONTRACTOR) FIELD MARKUPS.

WVWA

AS-BUILT PLAN

"GOOD SAMARITAN HOSPICE BUILDING"
4751 COVE ROAD, N.W.
ROANOKE COUNTY, VIRGINIA

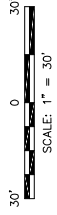

ENGINEERS | SURVEYORS | PLANNERS

4664 BRAMBLETON AVENUE
P.O. BOX 20669
ROANOKE, VIRGINIA 24018

PHONE: (540) 774-4411
FAX: (540) 772-9445
WWW.LUMSDENPC.COM

DATE:	September 29, 2023
COMM. NO.:	22-119
SCALE:	1" = 30' (H); 1" = 10' (V)