



DATUM ELEV
980

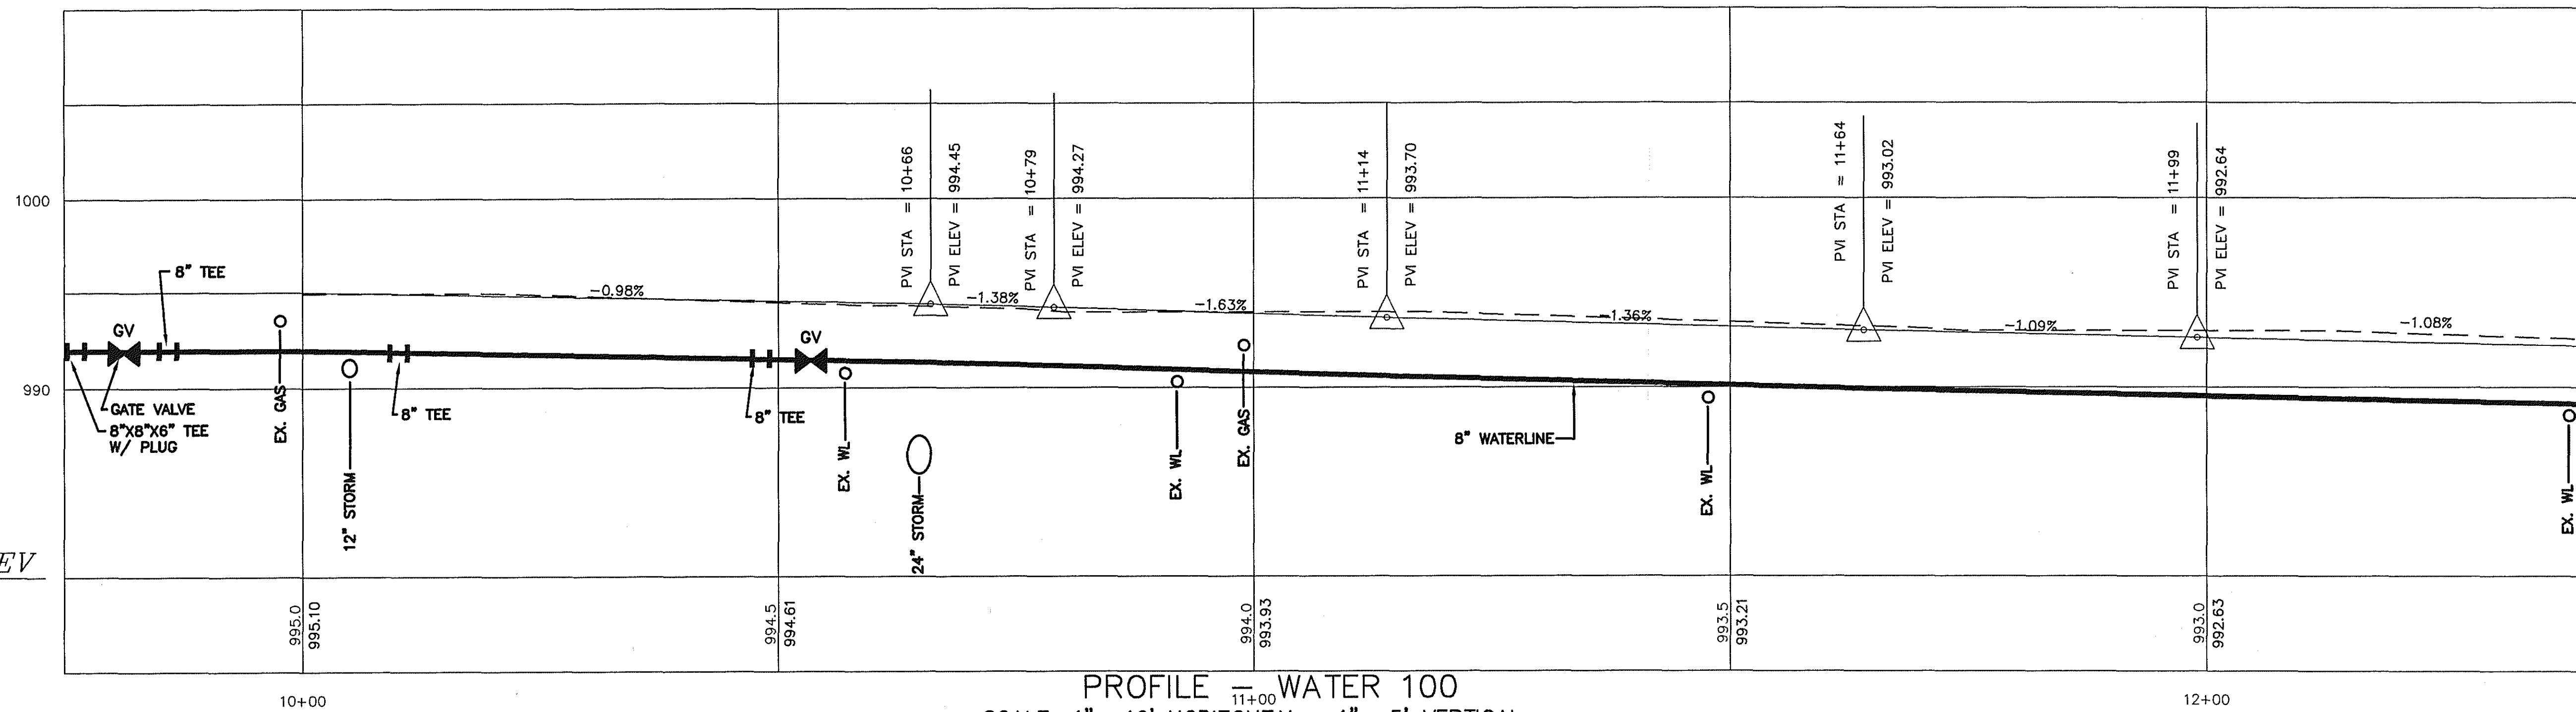


PROFILE - WATER 100
SCALE: 1" = 10' HORIZONTAL 1" = 5' VERTICAL

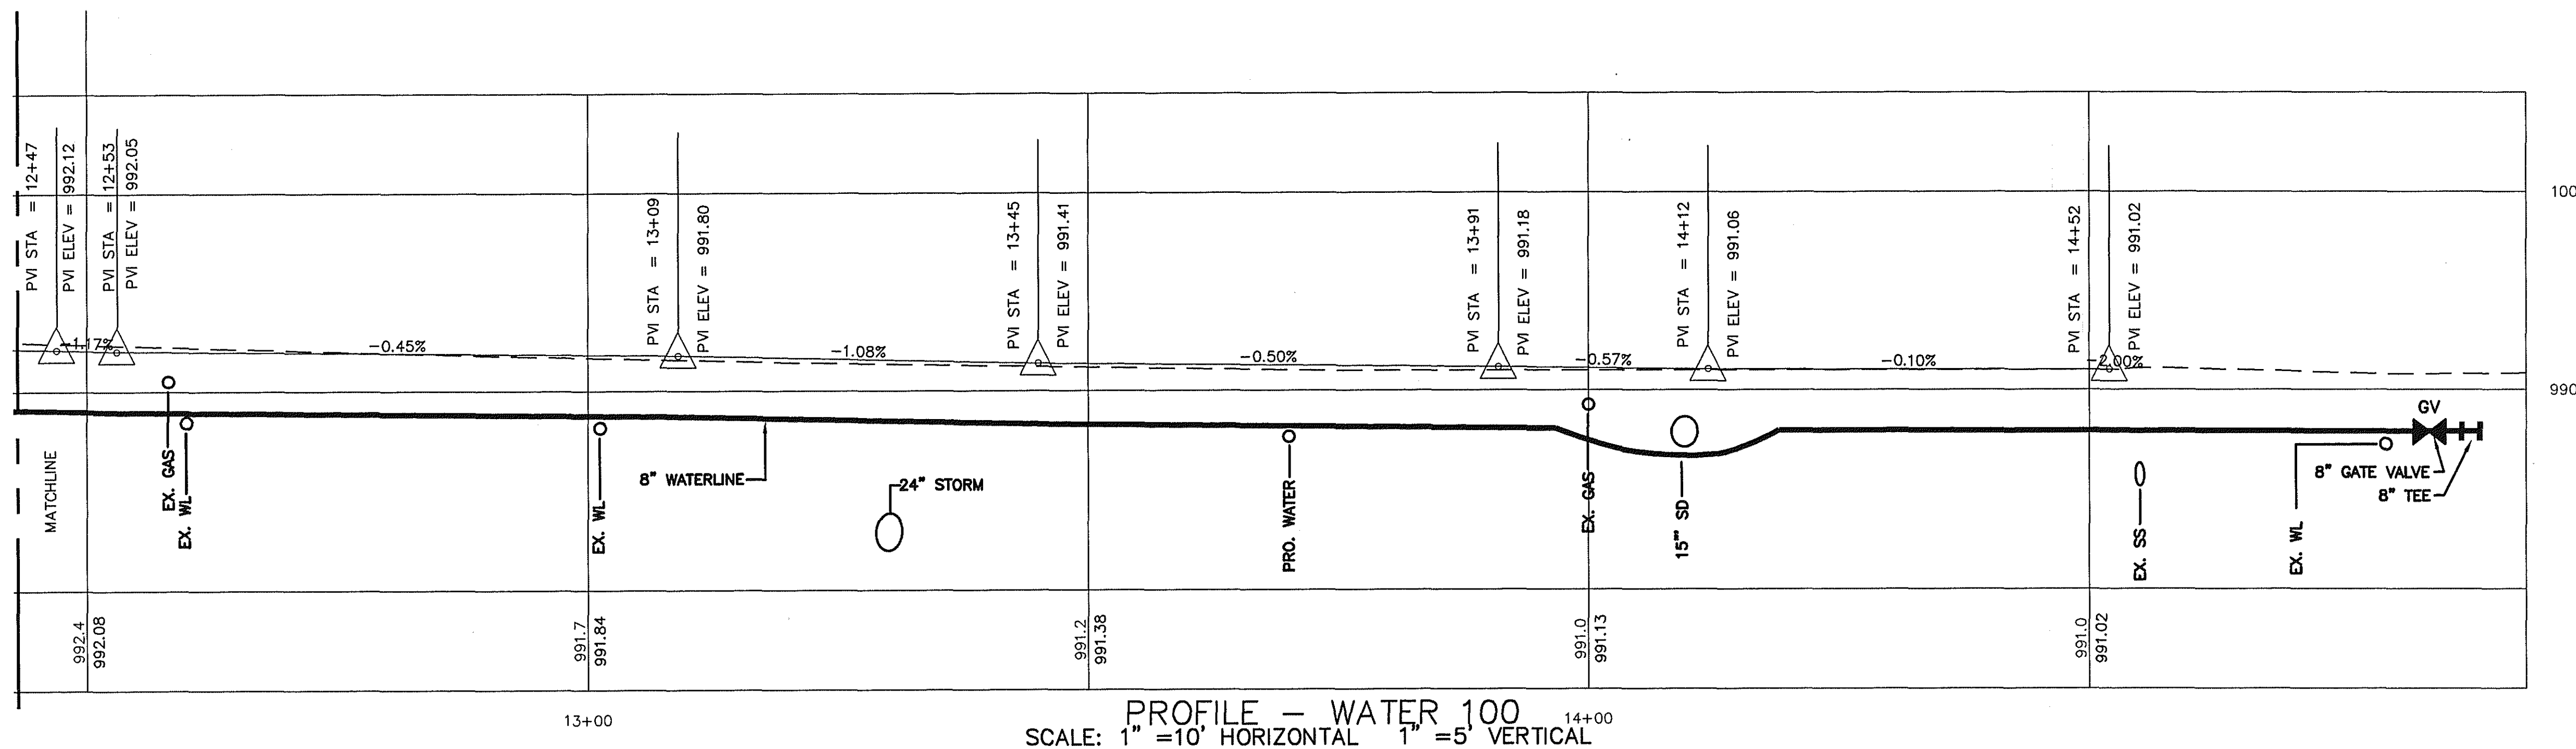

PROFILE - WATER 100
SCALE: 1" = 10' HORIZONTAL 1" = 5' VERTICAL


DATUM ELEV
980

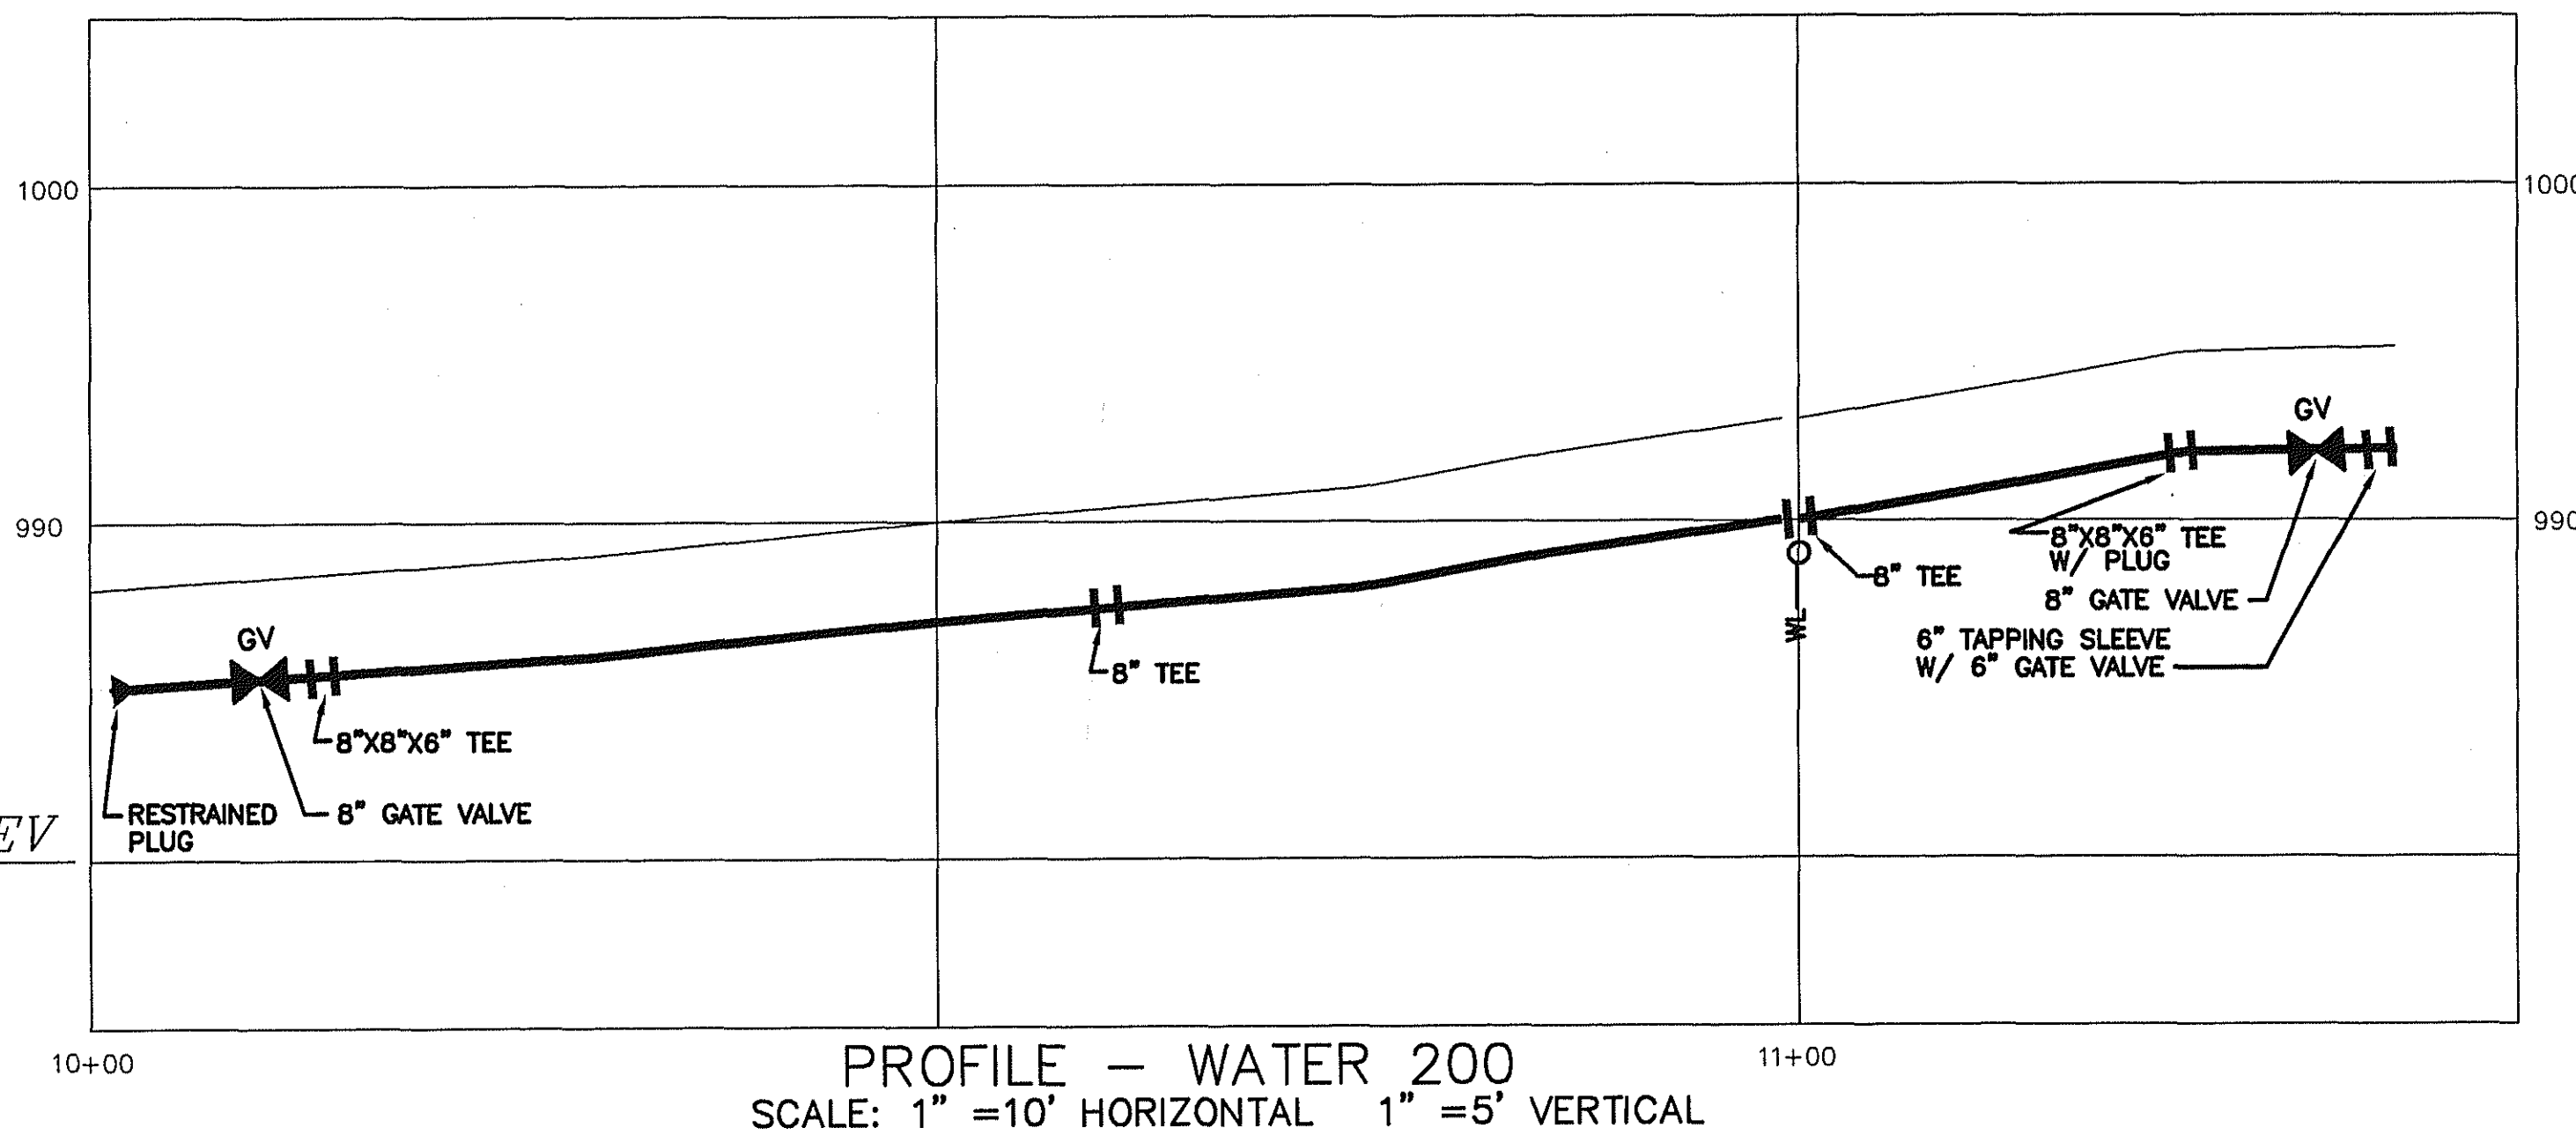

PROFILE - WATER 200
SCALE: 1" = 10' HORIZONTAL 1" = 5' VERTICAL

RECORD DRAWINGS
JUNE 29, 2005

NO.	DATE	DESCRIPTION	BY

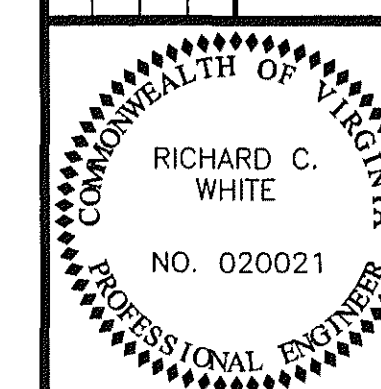

Designed By	MAB
Drawn By	MAB
Checked By	RCW
Approved By	RCW
Submitted By	RCW
Drawing	C-14
Date	02/01/04
Scale	NONE
Commission No.	2682
Sheet	18 of 21

GRANDIN ROAD STREETSCAPE
City of Roanoke, Virginia

LMW P.C.
Engineering
Architecture
Surveying
Landscape Design

102 Albemarle Ave
Roanoke, Virginia
24013
www.lmwpc.com
ph: 540.345.0675
fax: 540.342.4456
lmweng@lmwpc.com