
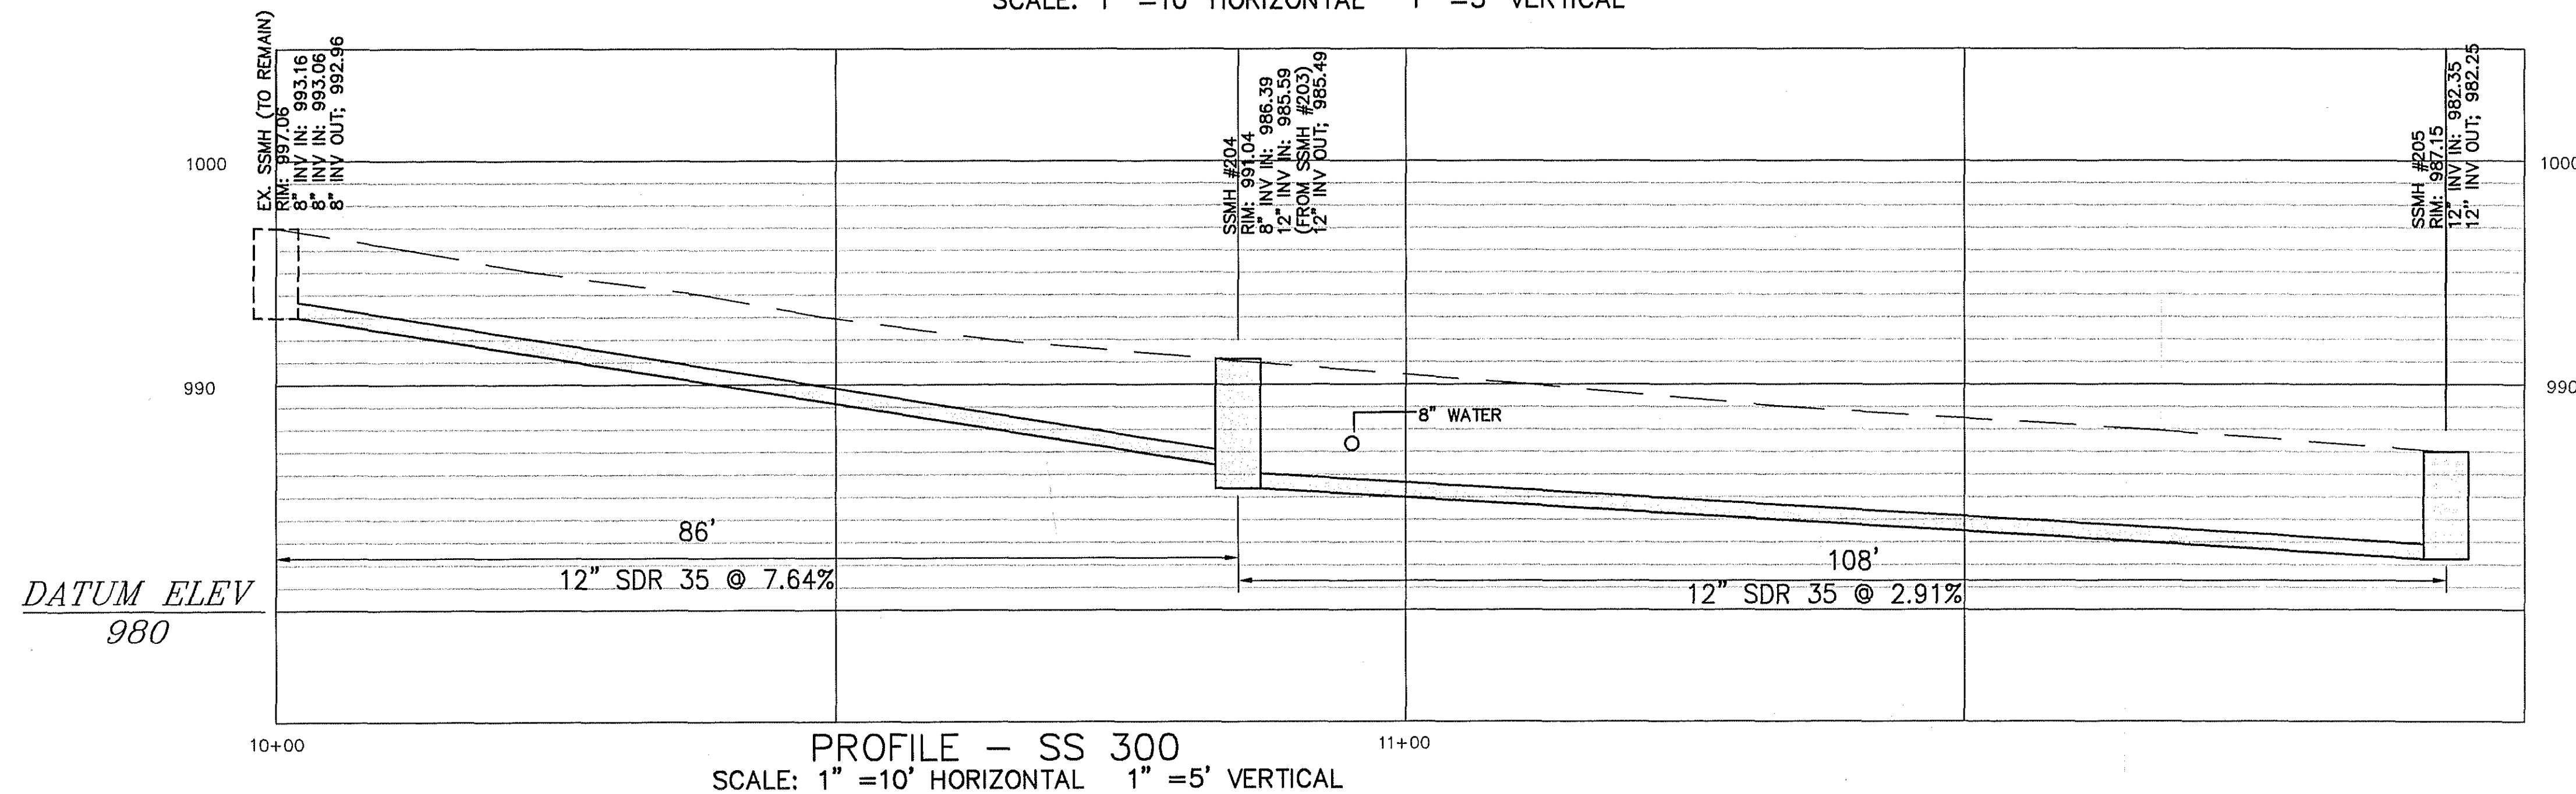
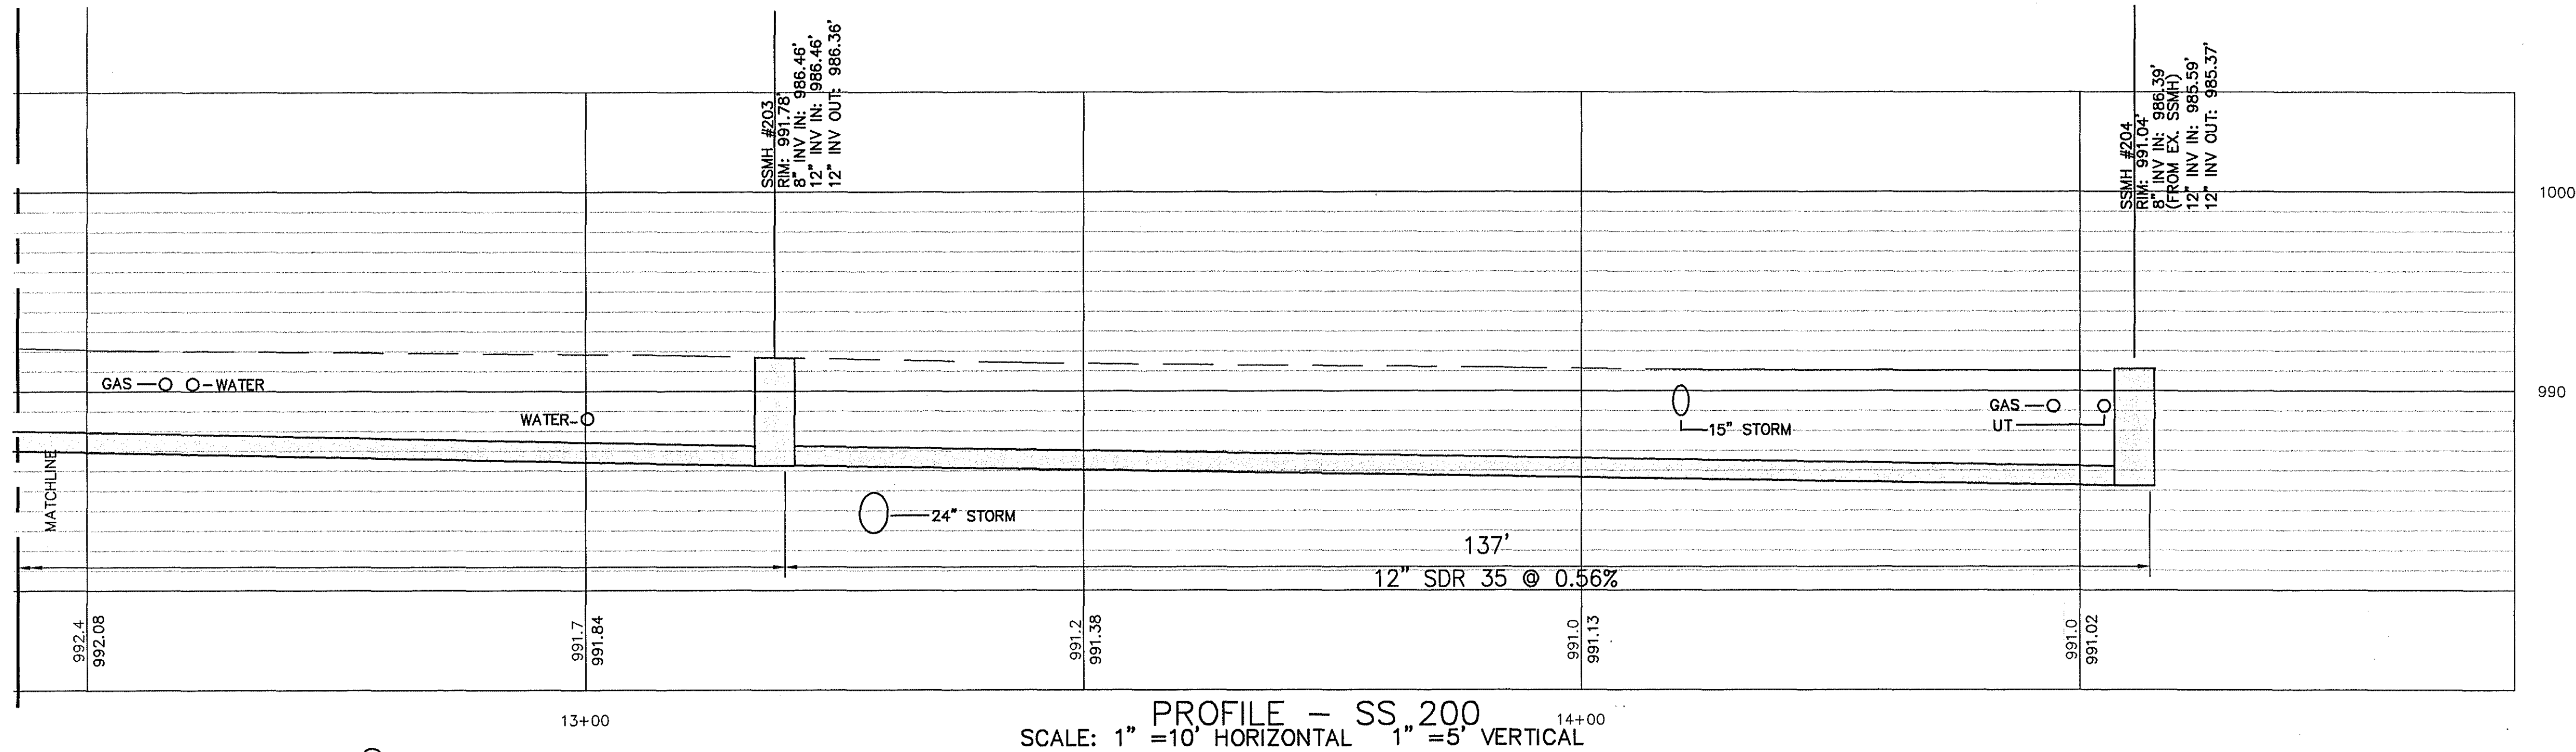


DATUM ELEV
980

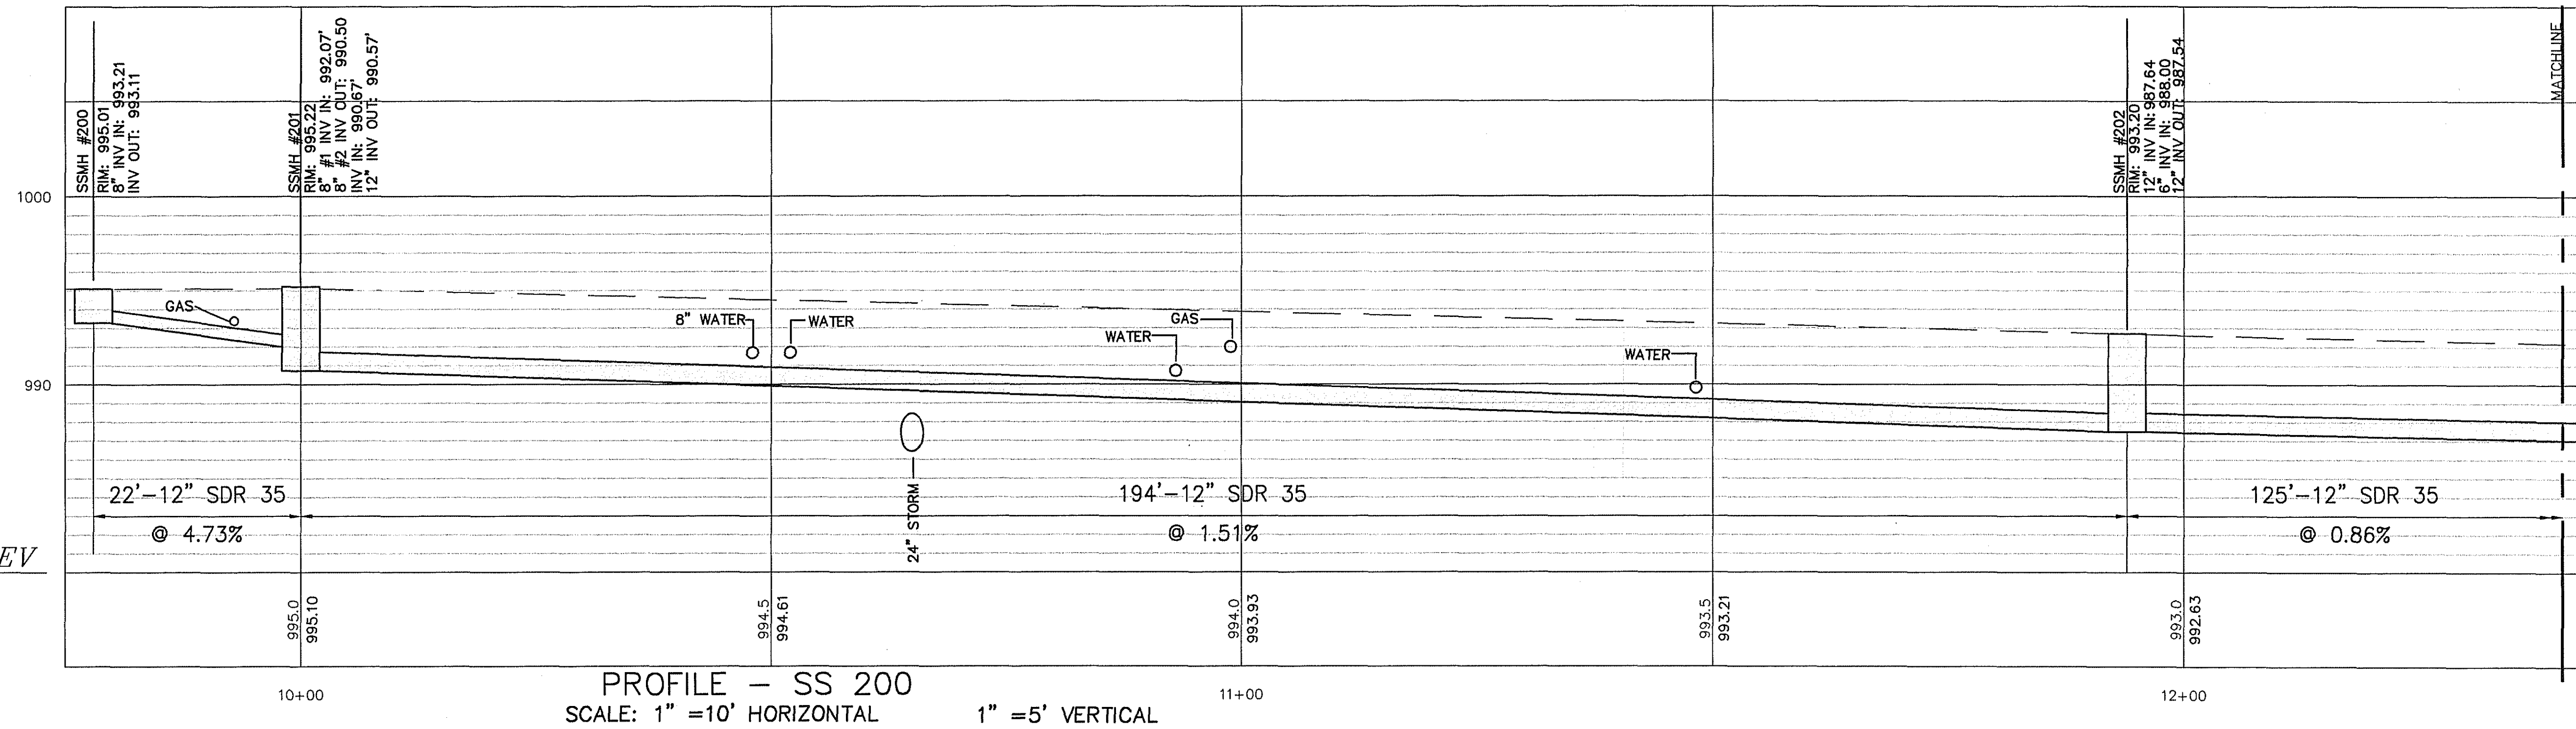

DATUM ELEV
980

RECORD DRAWINGS
JUNE 29, 2005

102 Albemarle Ave
Roanoke, Virginia 24013
www.lmwpc.com
ph: 540.345.0675
fax: 540.342.4456
lmweng@lmw.roscoemail.com

L M W P.C.
Engineering
Surveying
Landscape Design

GRANDIN ROAD STREETSCAPE
City of Roanoke, Virginia

NO.	DATE	DESCRIPTION	BY

SANITARY SEWER PROFILES

Designed By	MAB
Drawn By	MAB
Checked By	RCW
Approved By	RCW
Submitted By	RCW
Drawing	C-16
Date	02/01/04
Scale	NONE
Commission No.	2682
Sheet	20 of 21