





- NOTES:**
- CONTRACTOR SHALL CONFIRM EXISTING SERVICES MARKED FOR DEMOLITION ARE INDICATED PRIOR TO DEMOLITION. OWNER WILL ASSIST CONTRACTOR WITH VERIFICATION.
 - CONTRACTOR SHALL PERFORM EXISTING DEMOLITION AND UTILITY CROSSINGS TO EXISTING WATER MAIN AND GAS LINE.
 - CONTRACTOR SHALL COORDINATE SHUTDOWNS WITH OWNER TO MAINTAIN LOADED AND UNLOADED AREAS DISTURBED FOR THE WORK SHALL BE RESTORED USING TEMPORARY SEEDING, PERMANENT SEEDING, AND MULCHING.
- LEGEND:**
- Replace Existing Water Main
 - Replace Existing Water Main (not found)
 - As Released or Blow Off Valve
 - Gas Valve
 - Water Valve
 - Permanent Restoration - Patch Private
 - Entrance, per Specifications

PLAN & PROFILE
GRANDIN ROAD
WATER SYSTEM IMPROVEMENTS
ROANOKE, VA.

PROJECT NO. 20240089
LAT. 36.91448
LONG. -80.31664
DATE 07 MAY 24
DRAWN BY: CMB
CHECKED BY: DAA

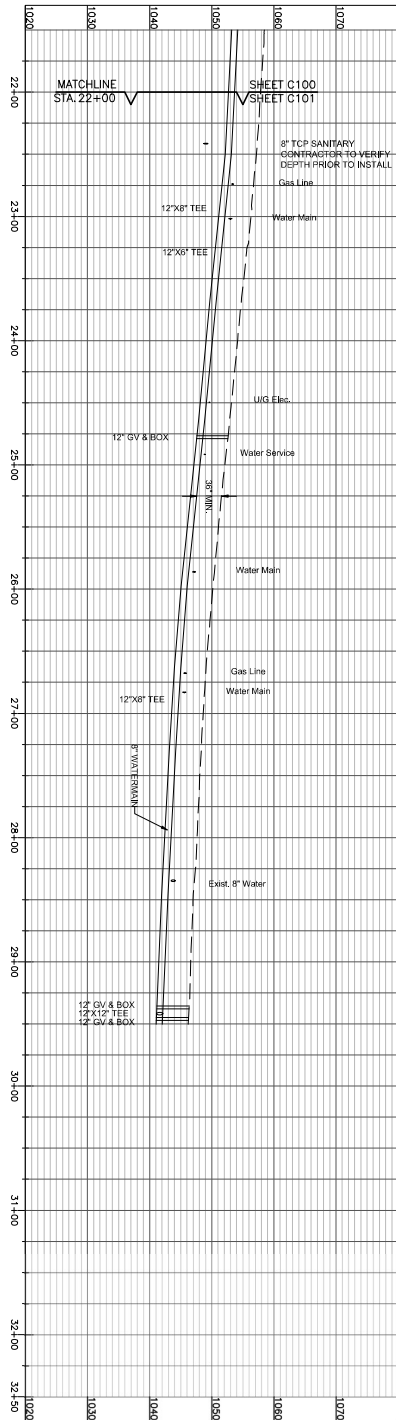

PLAN &
PROFILE
HURT&PROFFITT
SHEET NO. C101
REV.

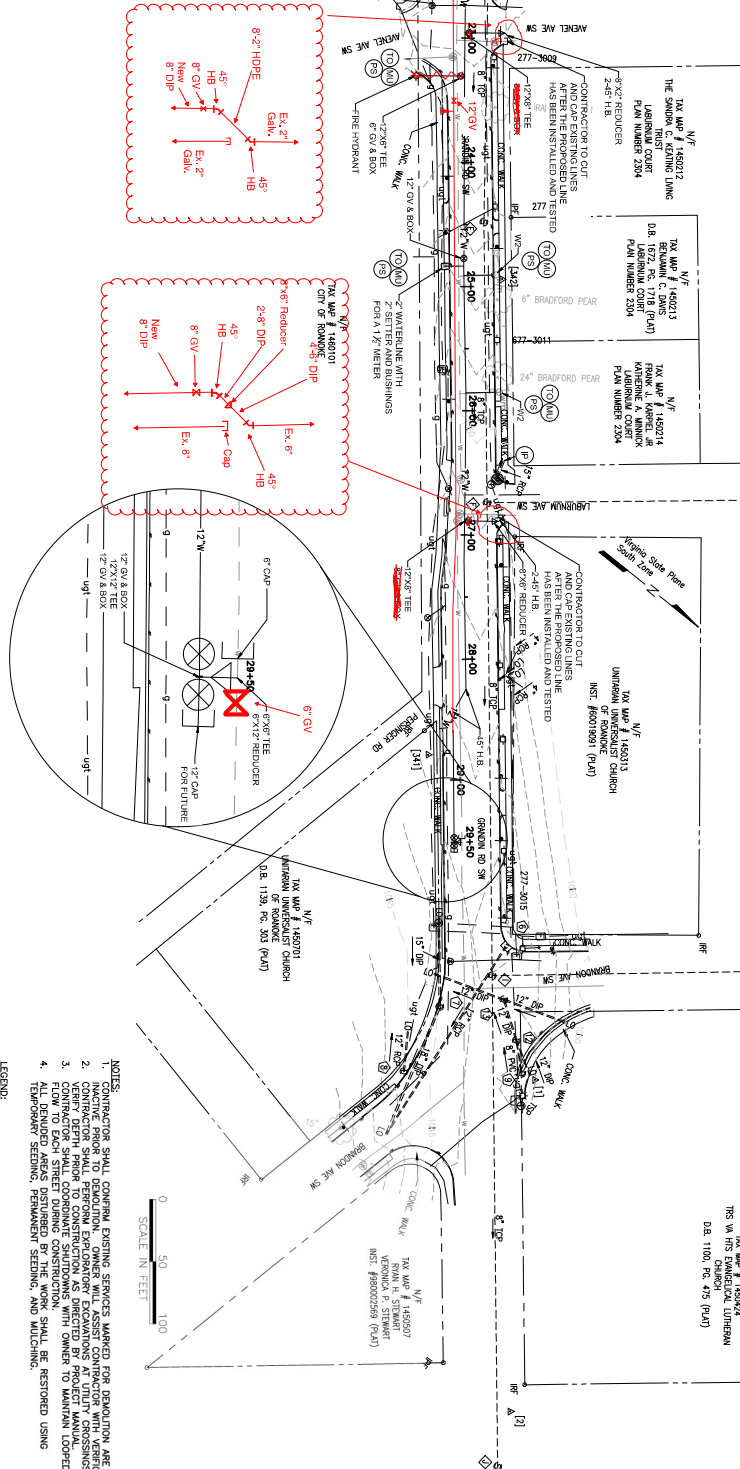

HURT&PROFFITT
INSPIRED / RESPONSIVE / TRUSTED
HANDP.COM
BLACKSBURG, VA. 24060
1861 PRATT DR, STE 1100
540.552.5592
ENGINEERING • SURVEYING • LAND DEVELOPMENT • ENVIRONMENTAL
GEOTECHNICAL • CONSTRUCTION TESTING & INSPECTION • CULTURAL RESOURCES