
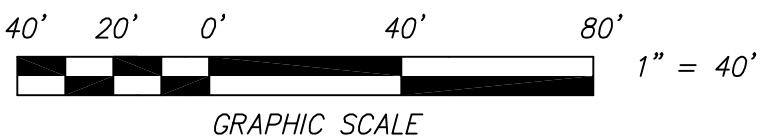
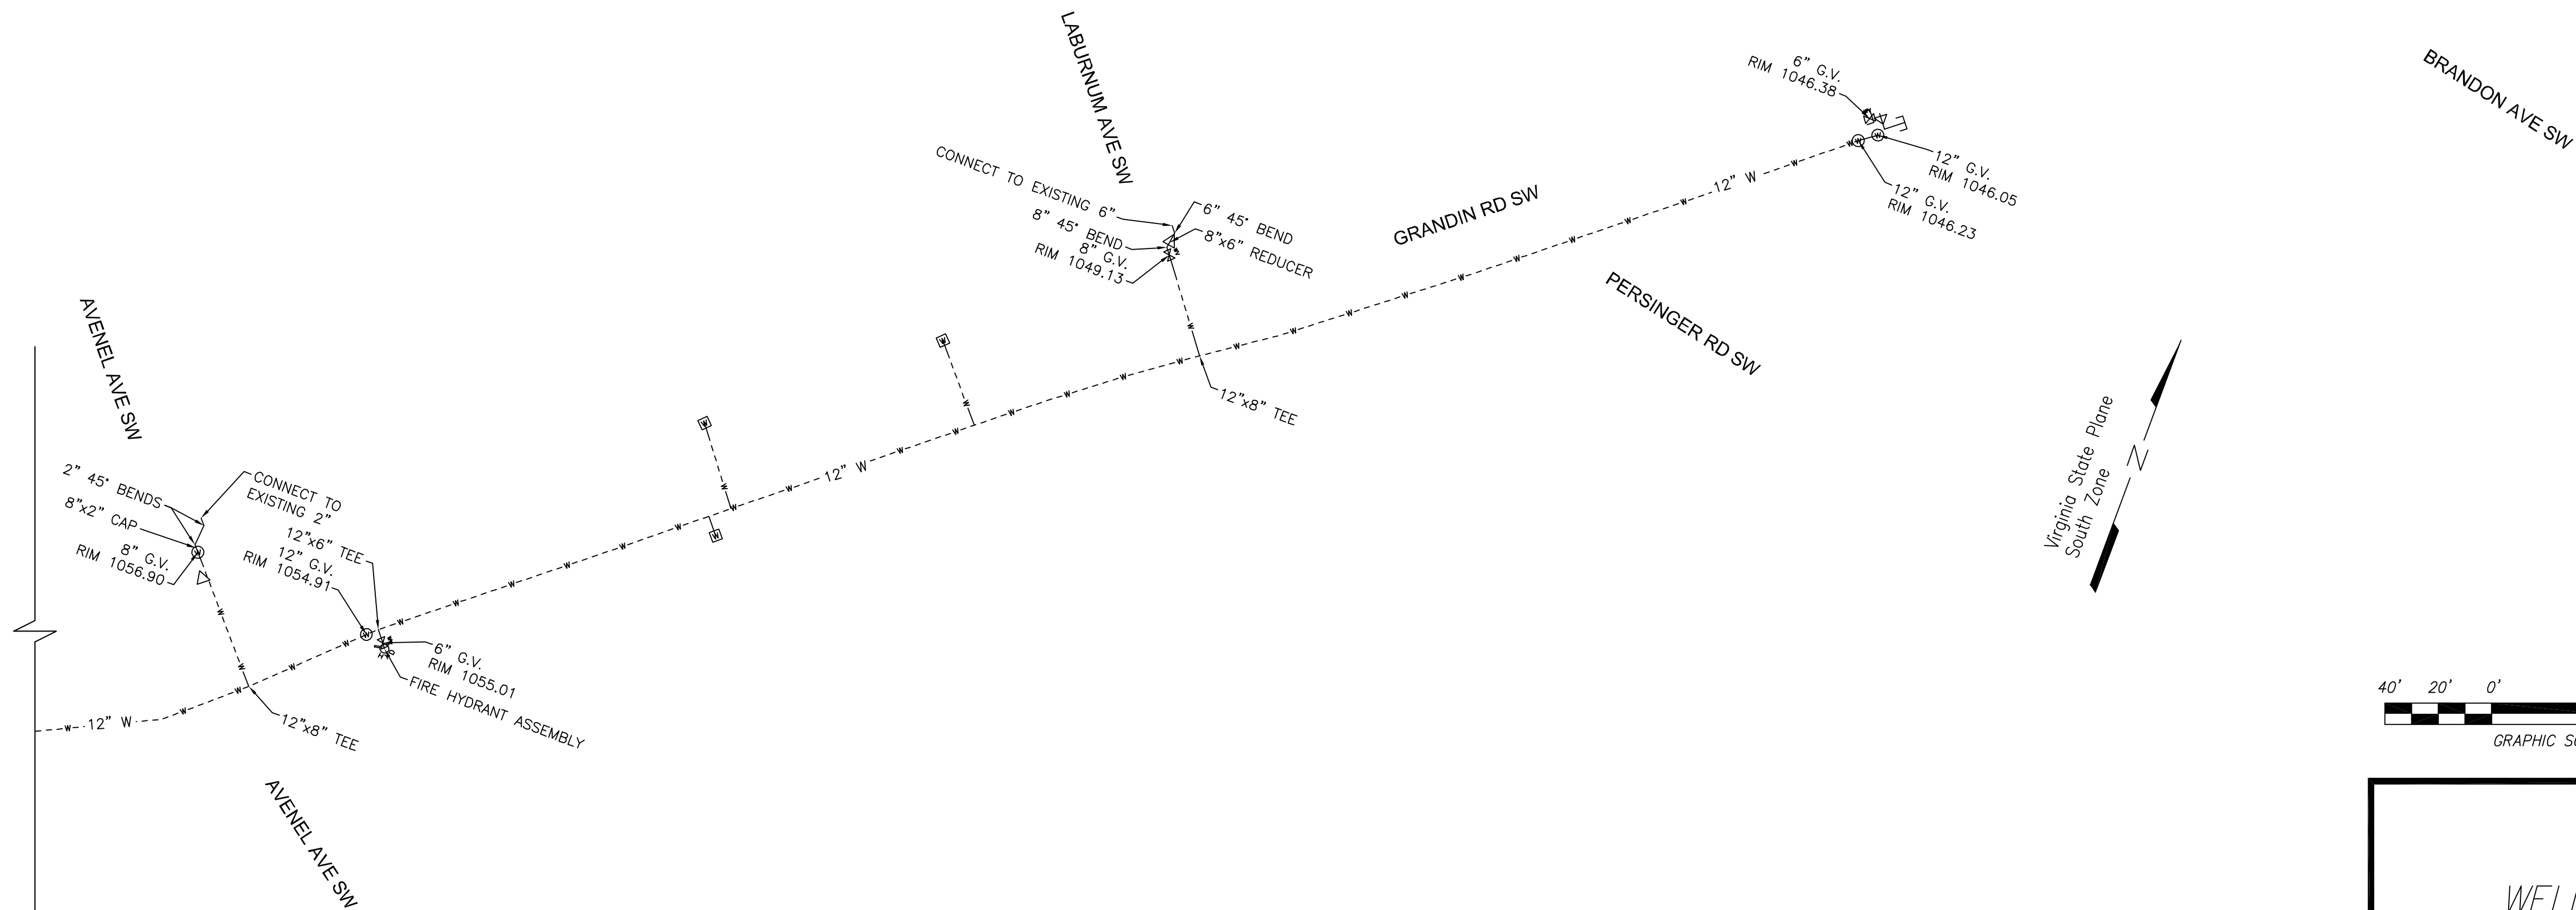


NOTES:
1. SEE PLANS TITLED GRANDIN ROAD WATER SYSTEM IMPROVEMENTS, PROJECT No. 20240089, BY HURT & PROFFITT DATED MAY 1, 2024.
2. THIS AS-BUILT SURVEY IS BASED ON FIELD SURVEY OF VISIBLE WATERLINE IMPROVEMENTS AND REDLINE SKETCHES FROM THE CONTRACTOR. THE FIELD SURVEY WAS COMPLETED BY CALDWELL WHITE ASSOCIATES, ON AUGUST 6, 2024.
3. THIS AS-BUILT SURVEY WAS COMPLETED UNDER THE DIRECT AND RESPONSIBLE CHARGE OF, FRANK B. CALDWELL, III, L.S. FROM AN ACTUAL GROUND SURVEY MADE UNDER MY SUPERVISION. THE ORIGINAL DATA COLLECTION CONCLUDED ON AUGUST 6, 2024; AND THIS MAP MEETS MINIMUM ACCURACY STANDARDS UNLESS OTHERWISE NOTED.

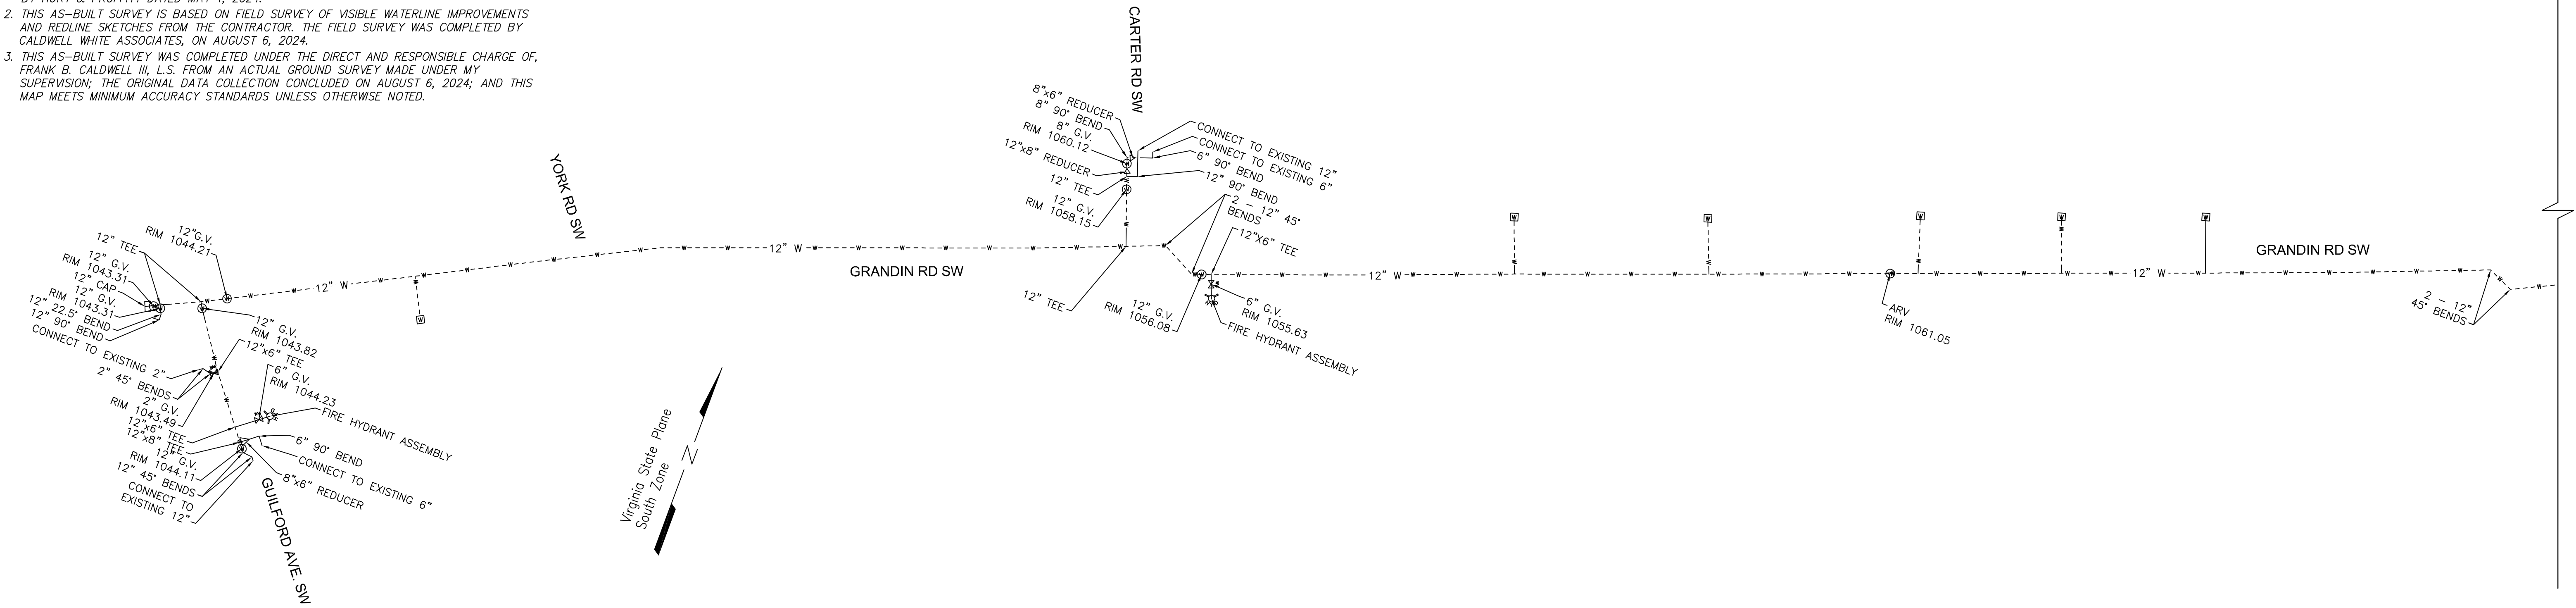

- LEGEND
- WV CAST IRON VALVE BOX
 - FIRE HYDRANT ASSEMBLY
 - W WATER VAULT
 - W WATER METER

WATERLINE AS-BUILT SURVEY
FOR
WELLS CONSTRUCTION, INC.

SHOWING WATERLINE IMPROVEMENTS
SITUATE AT GRANDIN ROAD, S.W.
CITY OF ROANOKE, VIRGINIA

Drawn: _____ C.L. Hurd
Checked: _____ F.B. Caldwell
Date: _____ SEPTEMBER 6, 2024
Scale: _____ 1"=40'
Tax Parcel: _____ VARIES
Field Book: _____ WYMA 5
W.O.: _____ 24-0050

CWA
CALDWELL WHITE ASSOCIATES
ENGINEERS / SURVEYORS / PLANNERS
4203 MELROSE AVENUE, N.W. P.O. BOX 6260
ROANOKE, VIRGINIA 24017-0260
Telephone: (540) 366-5400 Fax: (540) 366-8702
E-Mail: cwaroanoke@aol.com