


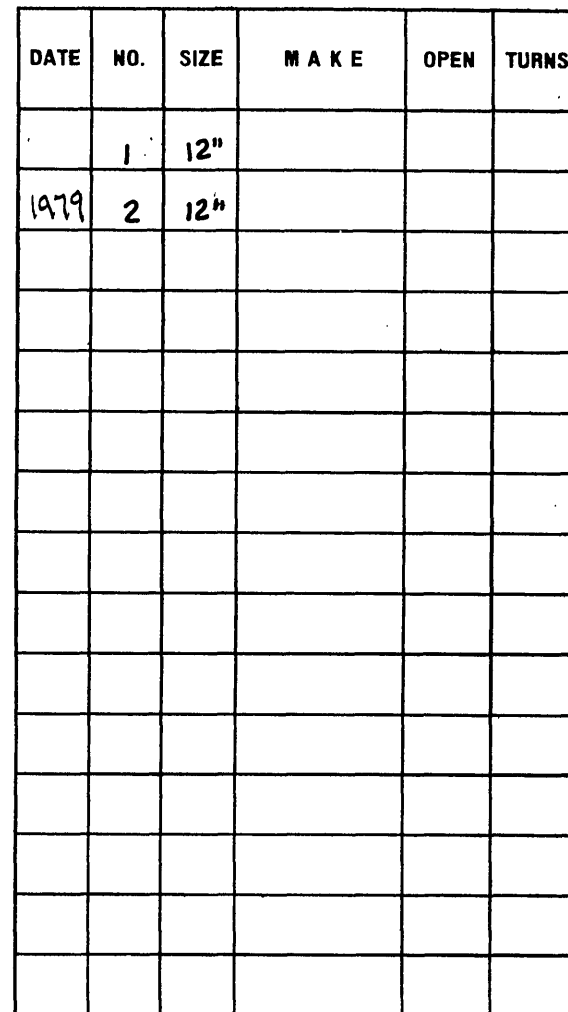

CIRCLE DR. AND
GARST MILL RD. SW.

DATE 7/14/80

PAGE NO.