


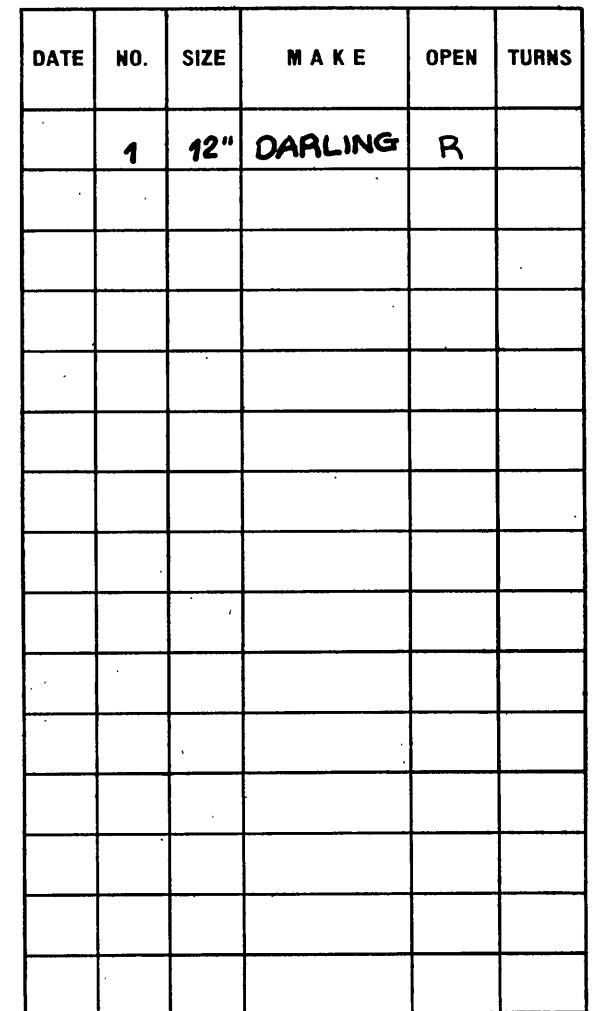

CIRCLE DR AND  
WINDSOR RD. SW.

DATE 7/14/80

**PAGE NO.**