
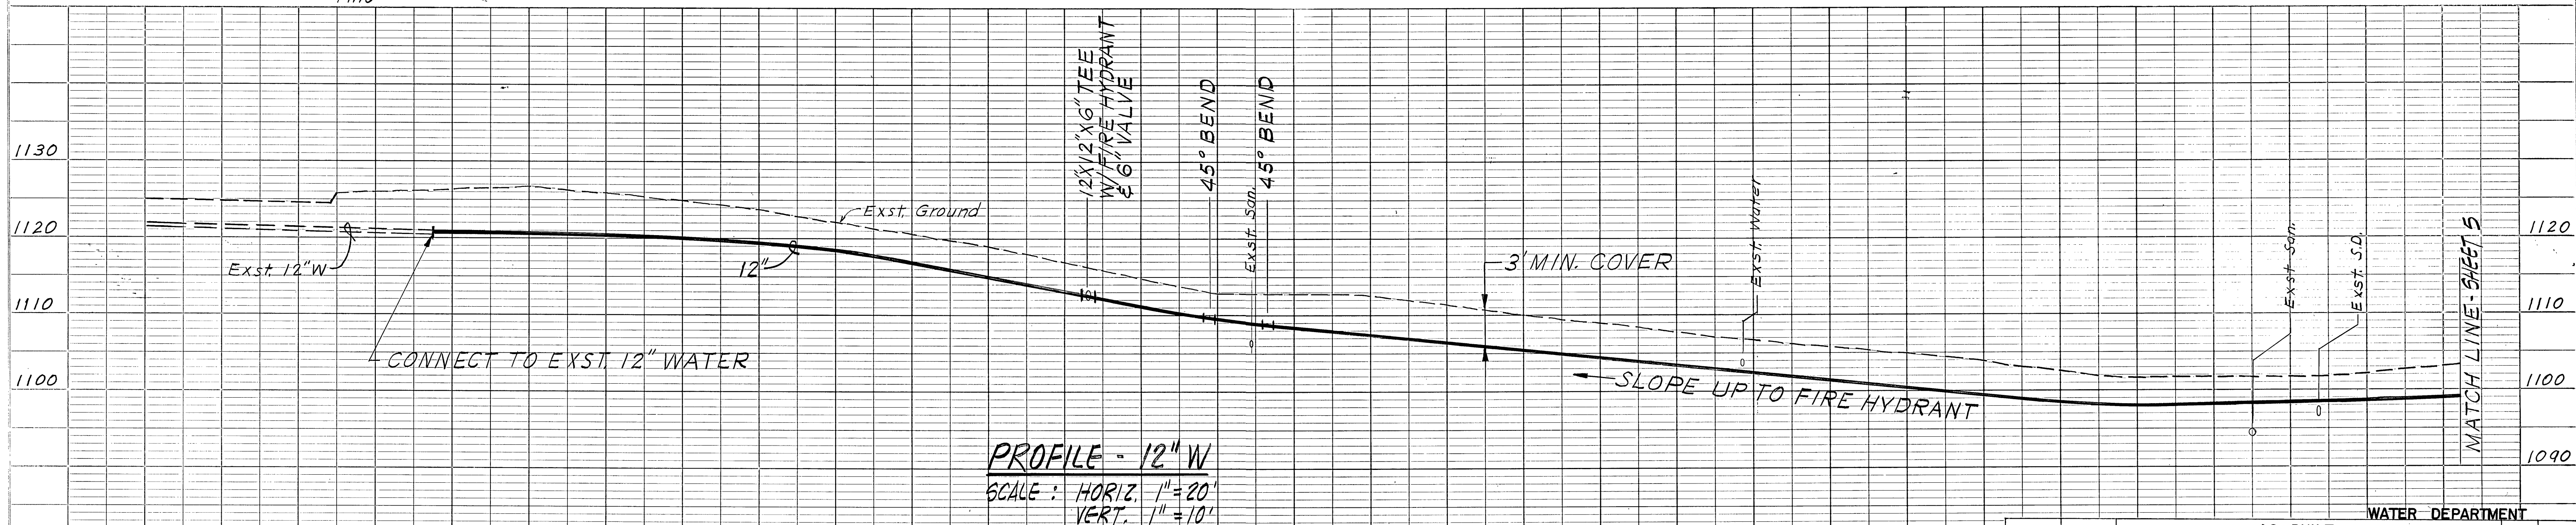


DATE	
BY	
CHECKED	
APPROVED	
NOTED	
NO.	

DATE	
BY	
CHECKED	
APPROVED	
NOTED	
NO.	

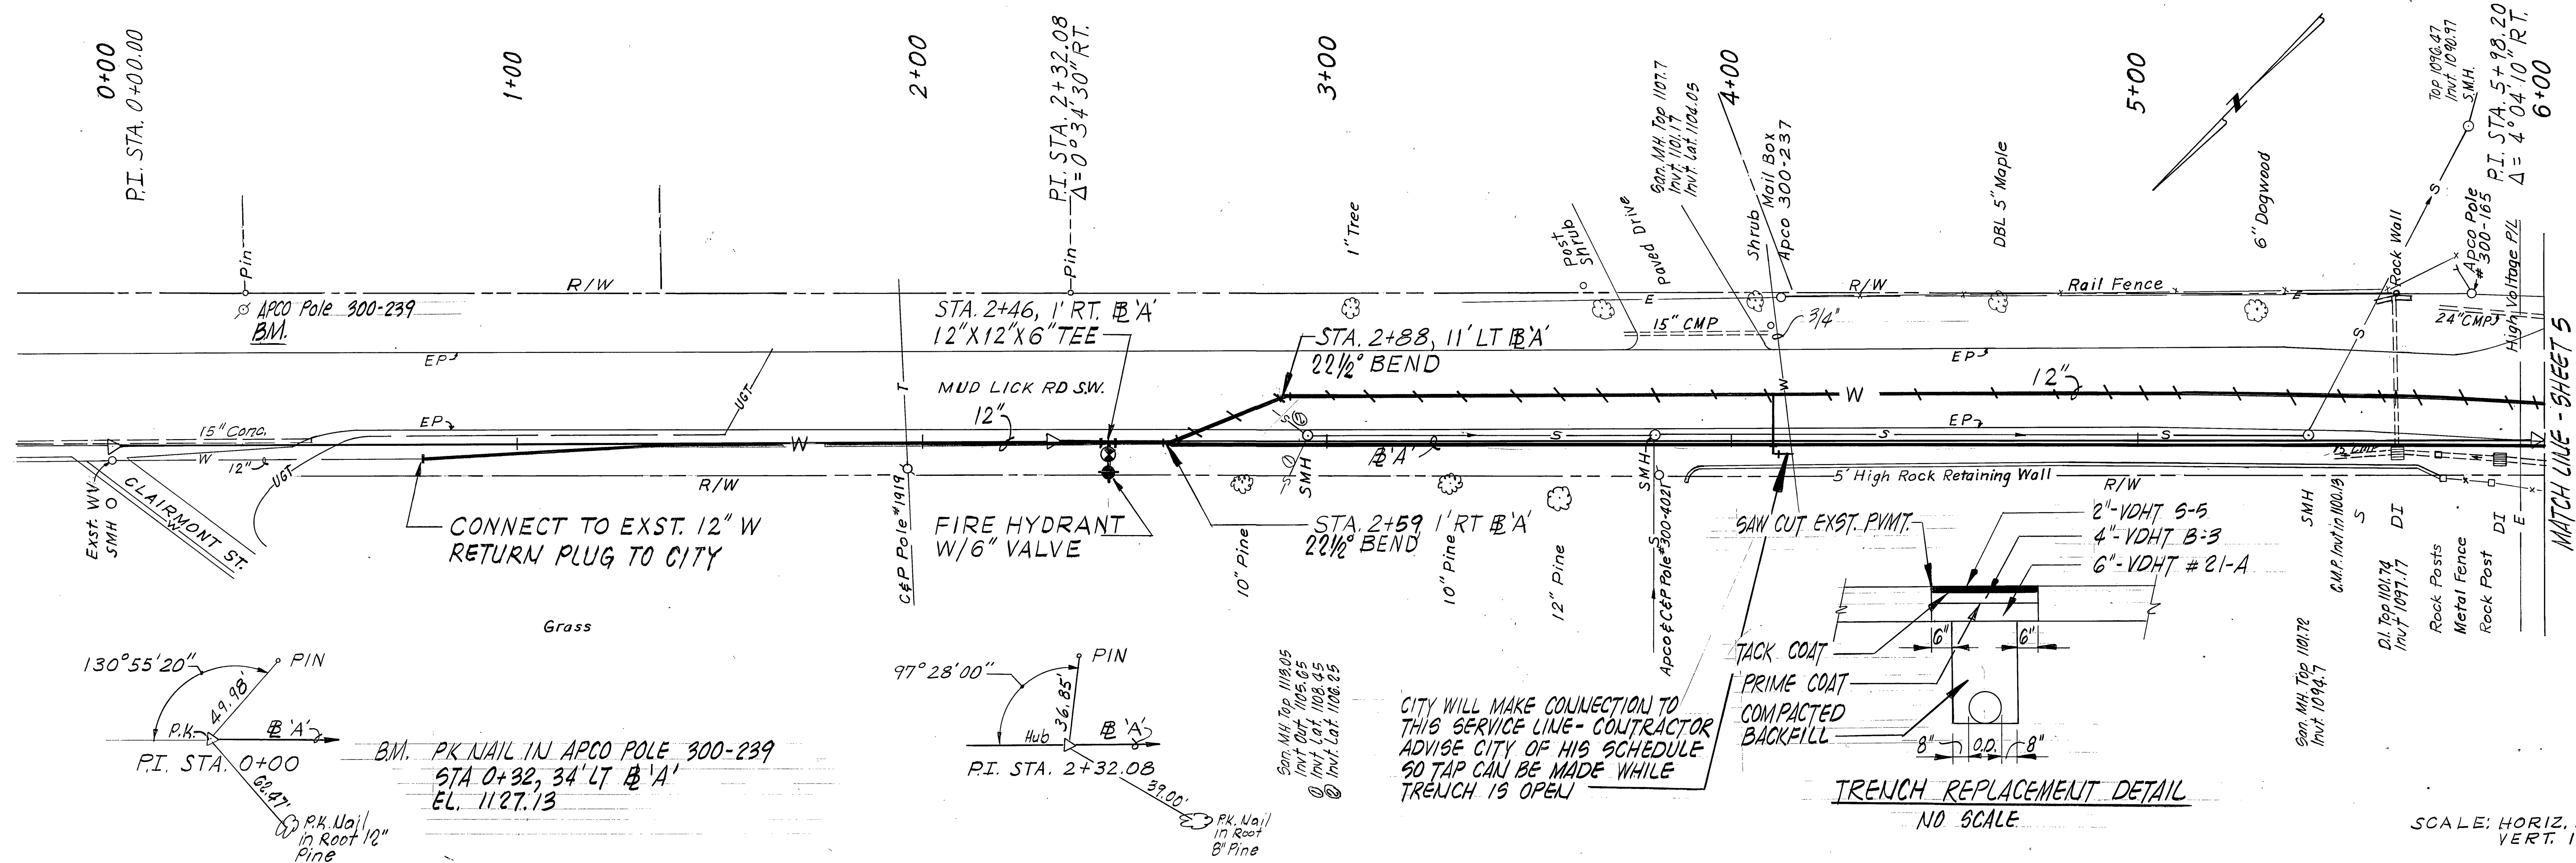

AS-BUILT		WATER DEPARTMENT 84-09	
REVISION	DATE	DESCRIPTION	BY APP
DESIGNED		GRANDIN ROAD WATERLINE	
DRAWN			
CHECKED			
APPROVED			
SUBMITTED		PLAN AND PROFILE	
Mattern and Craig		SCALE: NOTED	COMM. NO. 469
CONSULTING ENGINEERS		DATE: MAY 1984	SHEET 4
ROANOKE, VIRGINIA			