
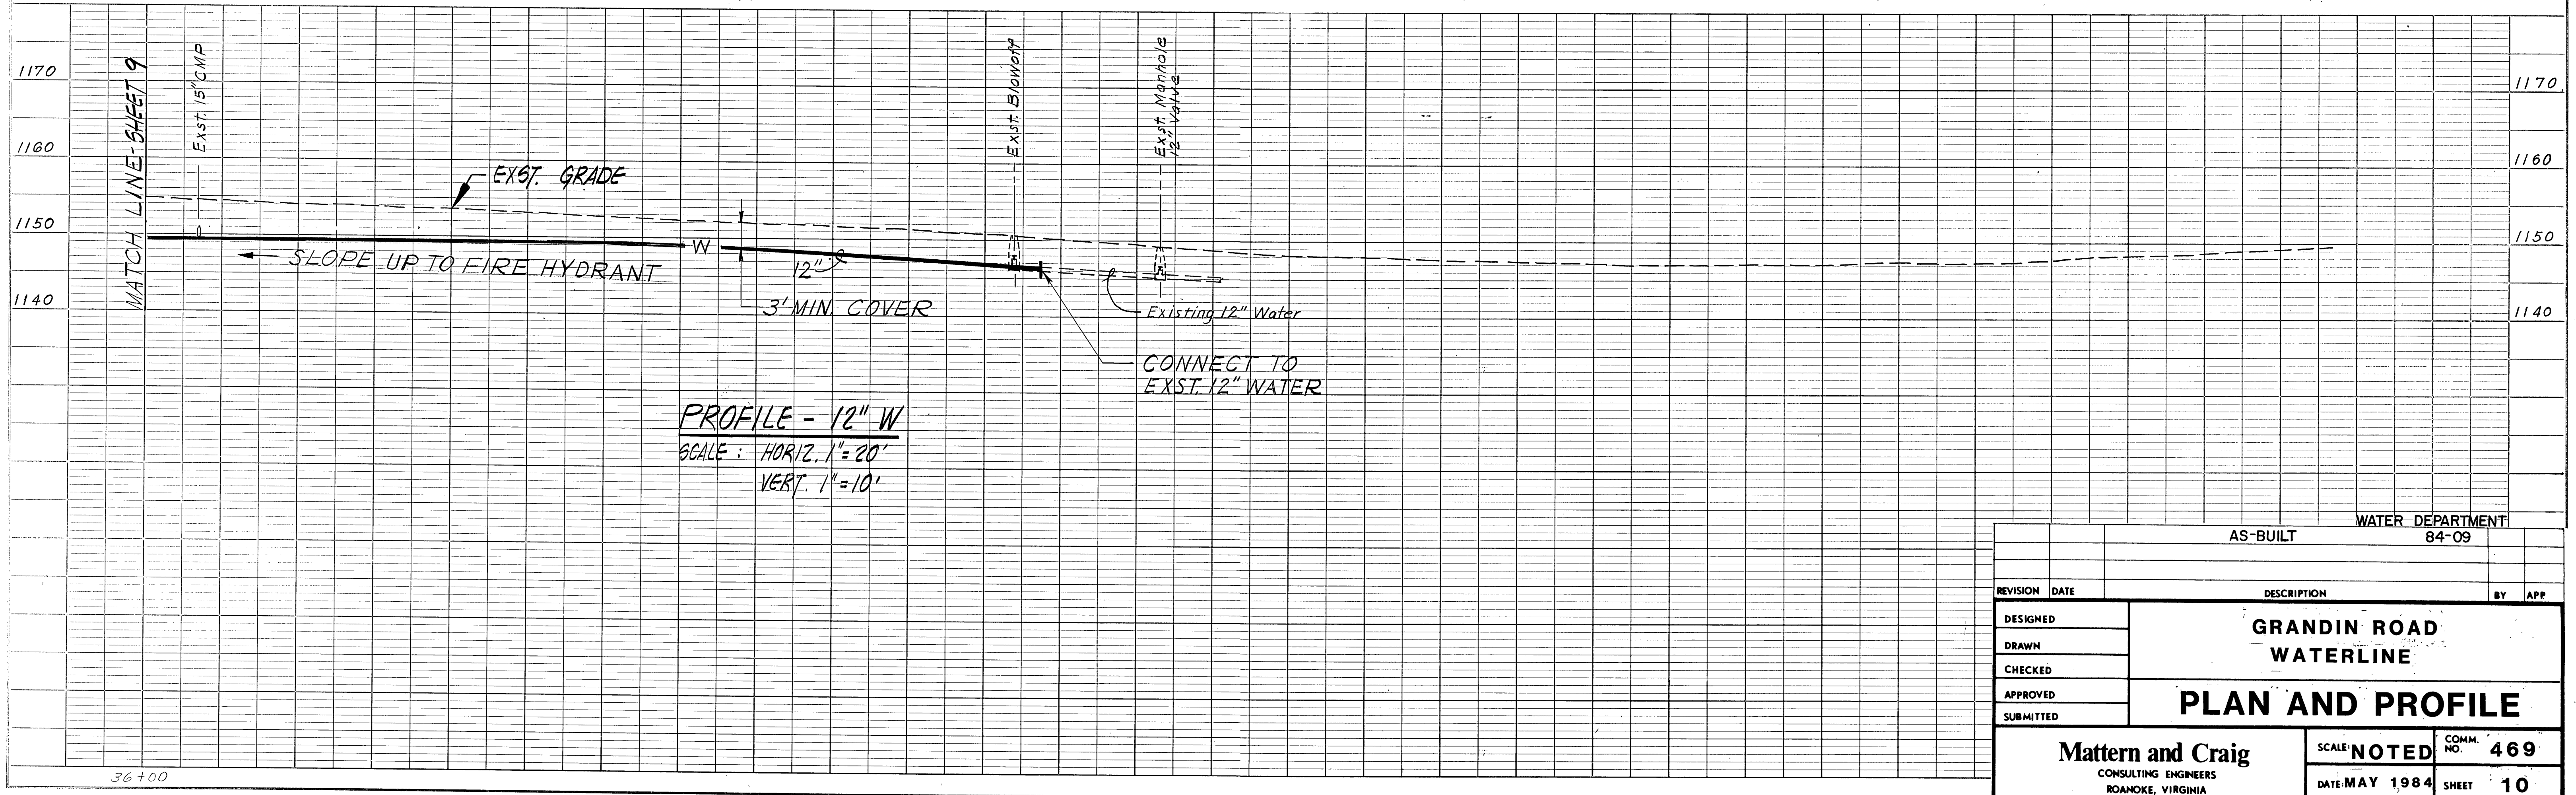
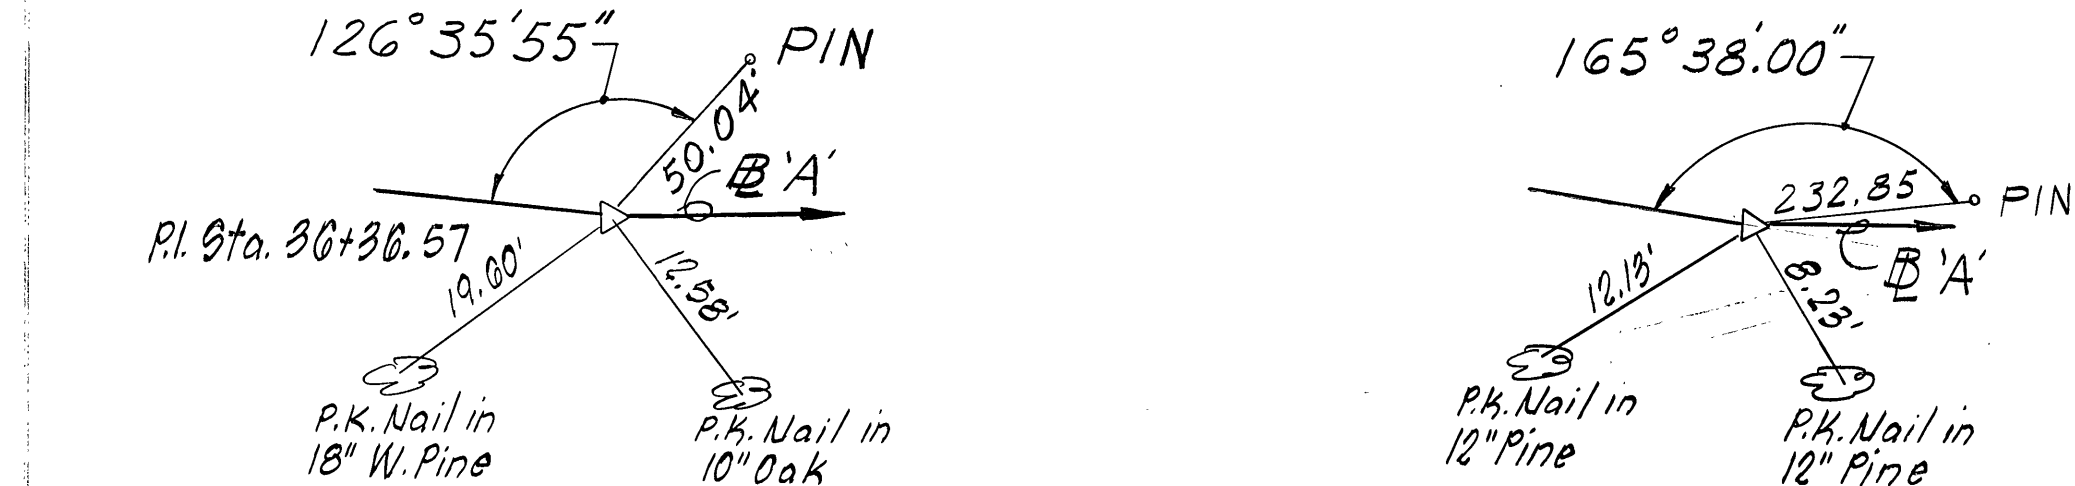


DATE	
BY	
CHECKED	
APPROVED	
SUBMITTED	

DATE	
BY	
CHECKED	
APPROVED	
SUBMITTED	

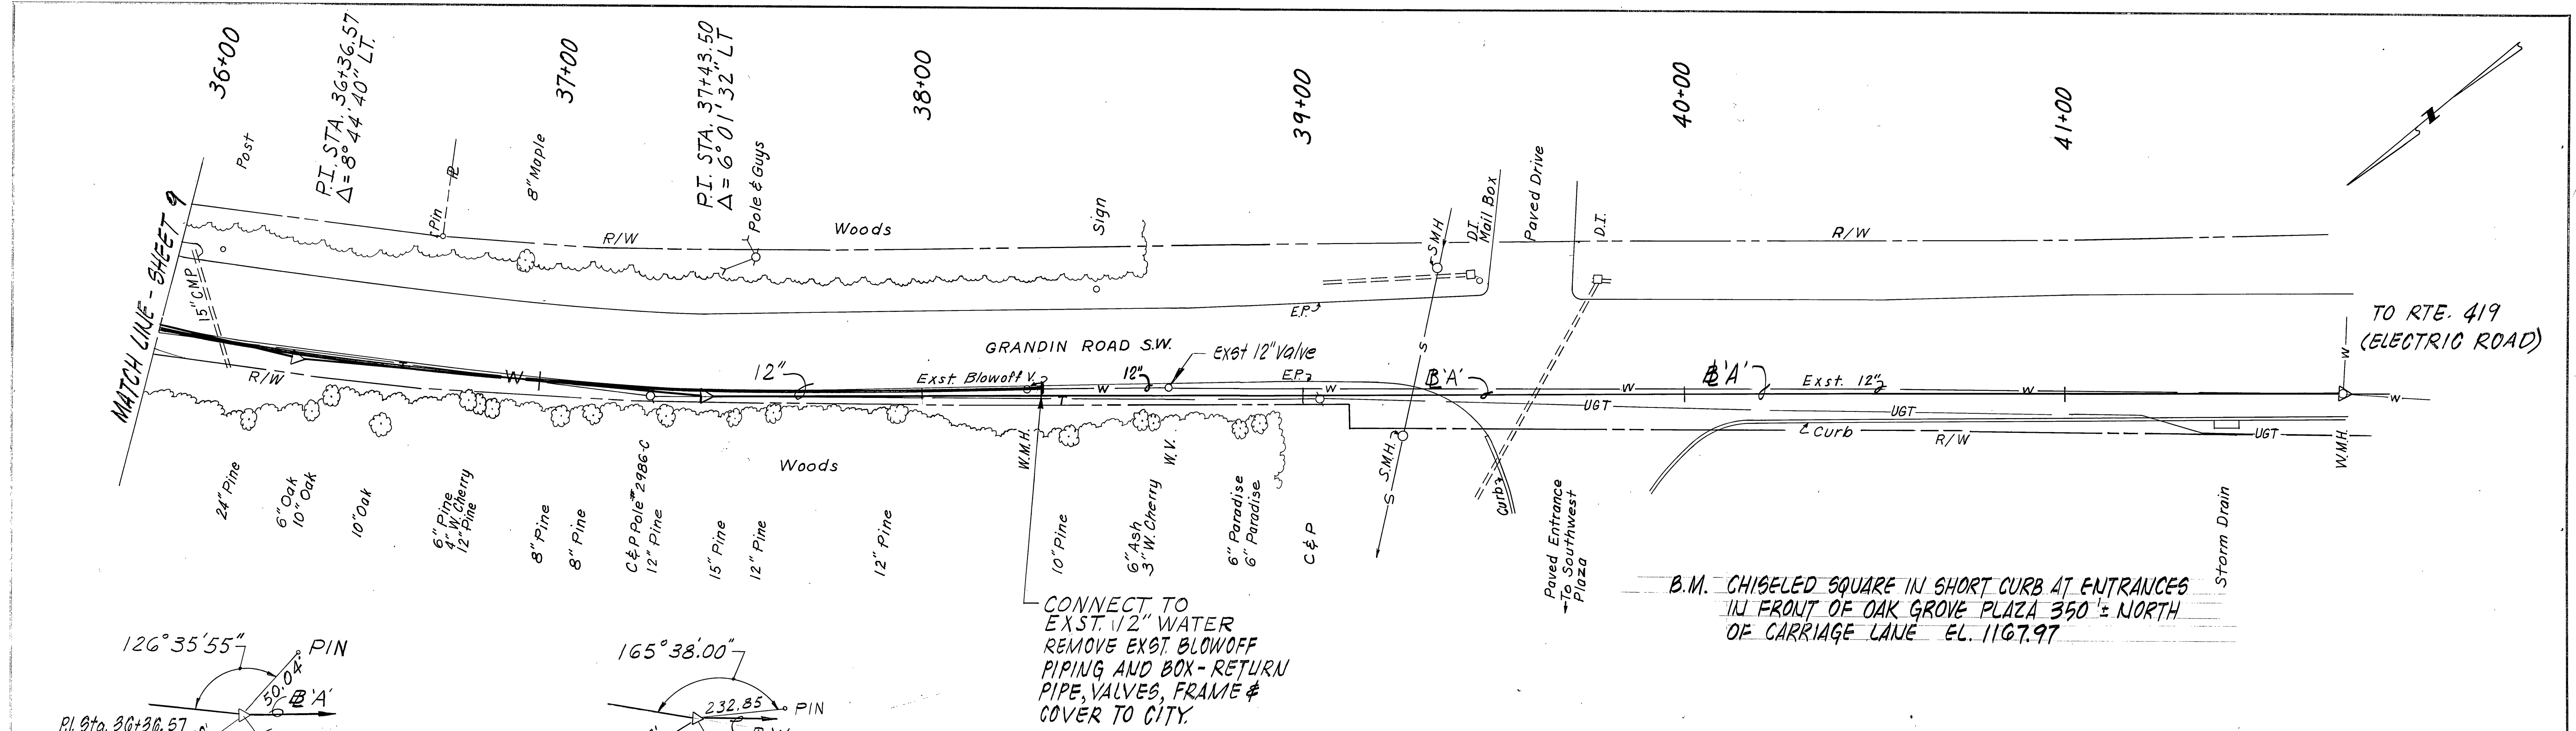

AS-BUILT		WATER DEPARTMENT	
84-09			
REVISION	DATE	DESCRIPTION	BY APP
DESIGNED		GRANDIN ROAD WATERLINE	
DRAWN			
CHECKED			
APPROVED		PLAN AND PROFILE	
SUBMITTED			
Mattern and Craig		SCALE NOTED	COMM. NO. 469
CONSULTING ENGINEERS		DATE: MAY 1984	SHEET 10
ROANOKE, VIRGINIA			