
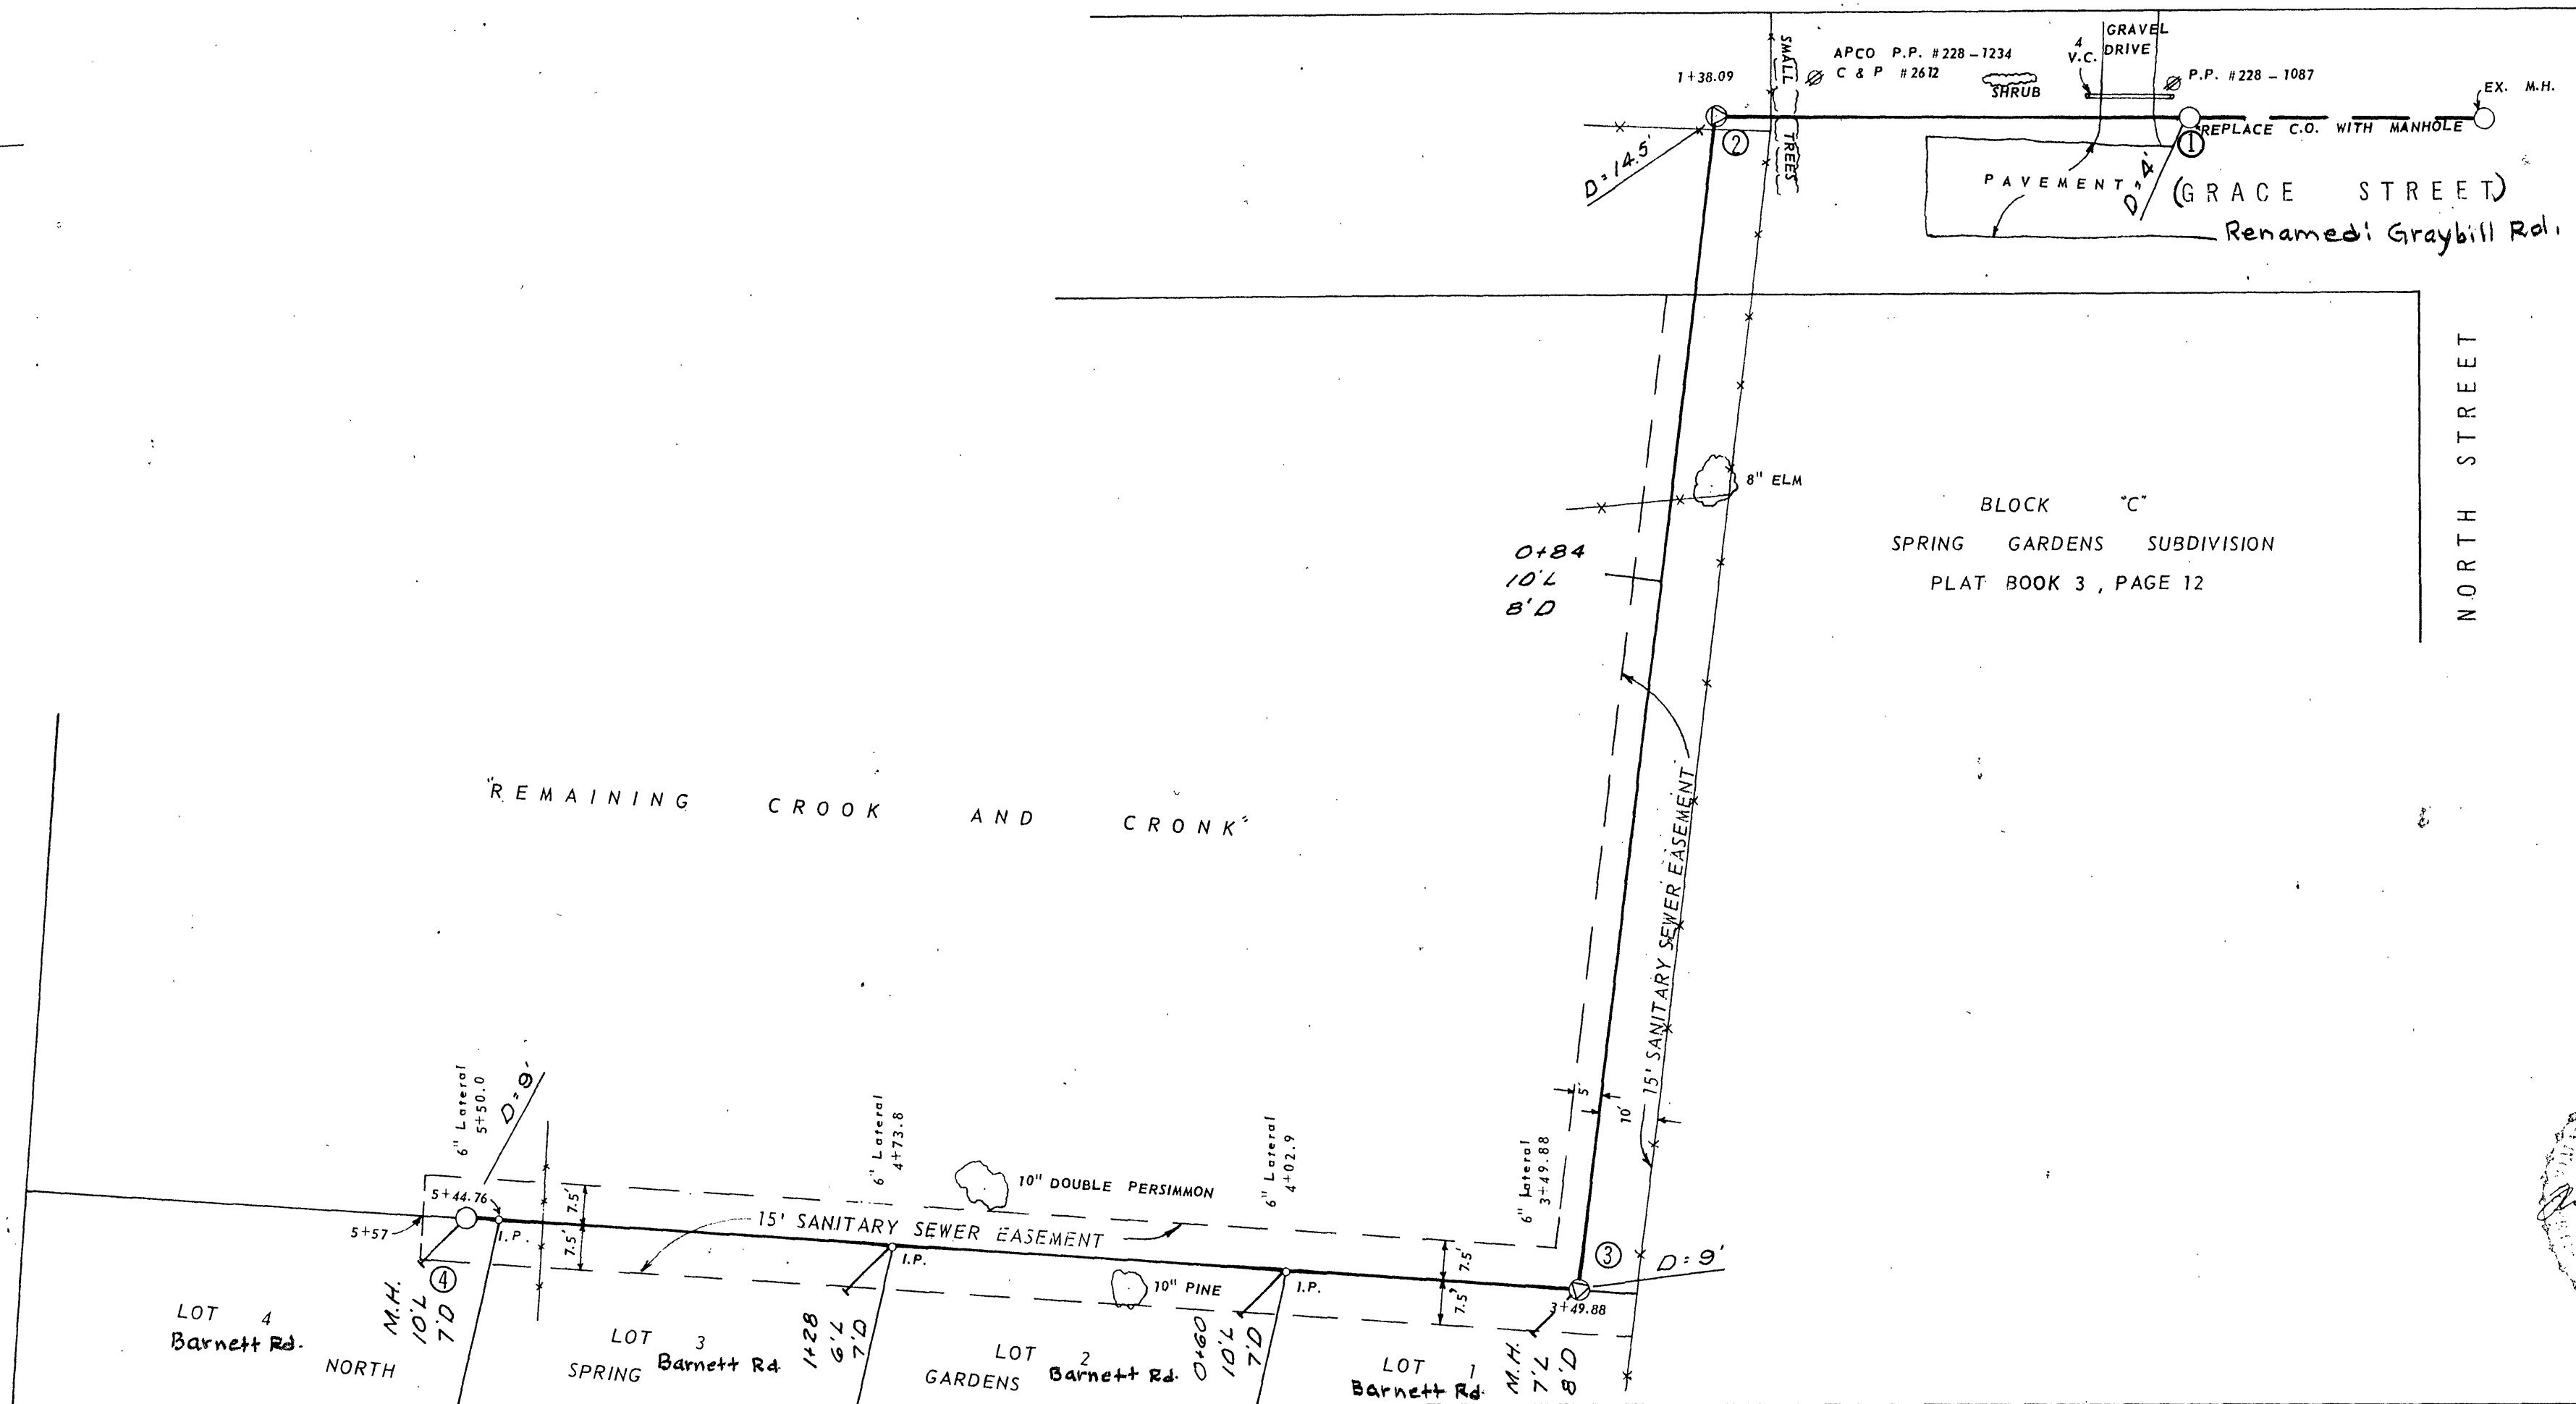


PLAN	DATE	BY
	SURVEYED NOTE BOOK No.	

PROFILE	DATE	BY
	SURVEYED NOTE BOOK No.	

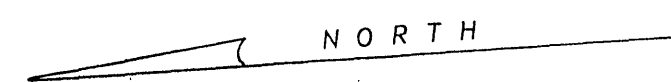

APPROVED: **FILE NUMBER 377**

ENGINEER, CITY OF ROANOKE DATE

NOTE:
LINES TO BE CONSTRUCTED IN ACCORDANCE WITH THE RULES AND SPECIFICATIONS OF THE ROANOKE COUNTY PUBLIC SERVICE AUTHORITY.

As BUILT

REVISED
PLAN AND PROFILE


NORTH SPRING GARDENS SUBDIVISION
(GRACE STREET)
Graybill Road

SITUATE IN ROANOKE COUNTY, VIRGINIA.

SCALE: HORZ: 1"=25'
VERT: 1"=10'

DATE: NOVEMBER 2, 1974
REV: JANUARY 28, 1975

BY: RAYMOND E. ROBERTSON
ENGINEER AND LAND SURVEYOR

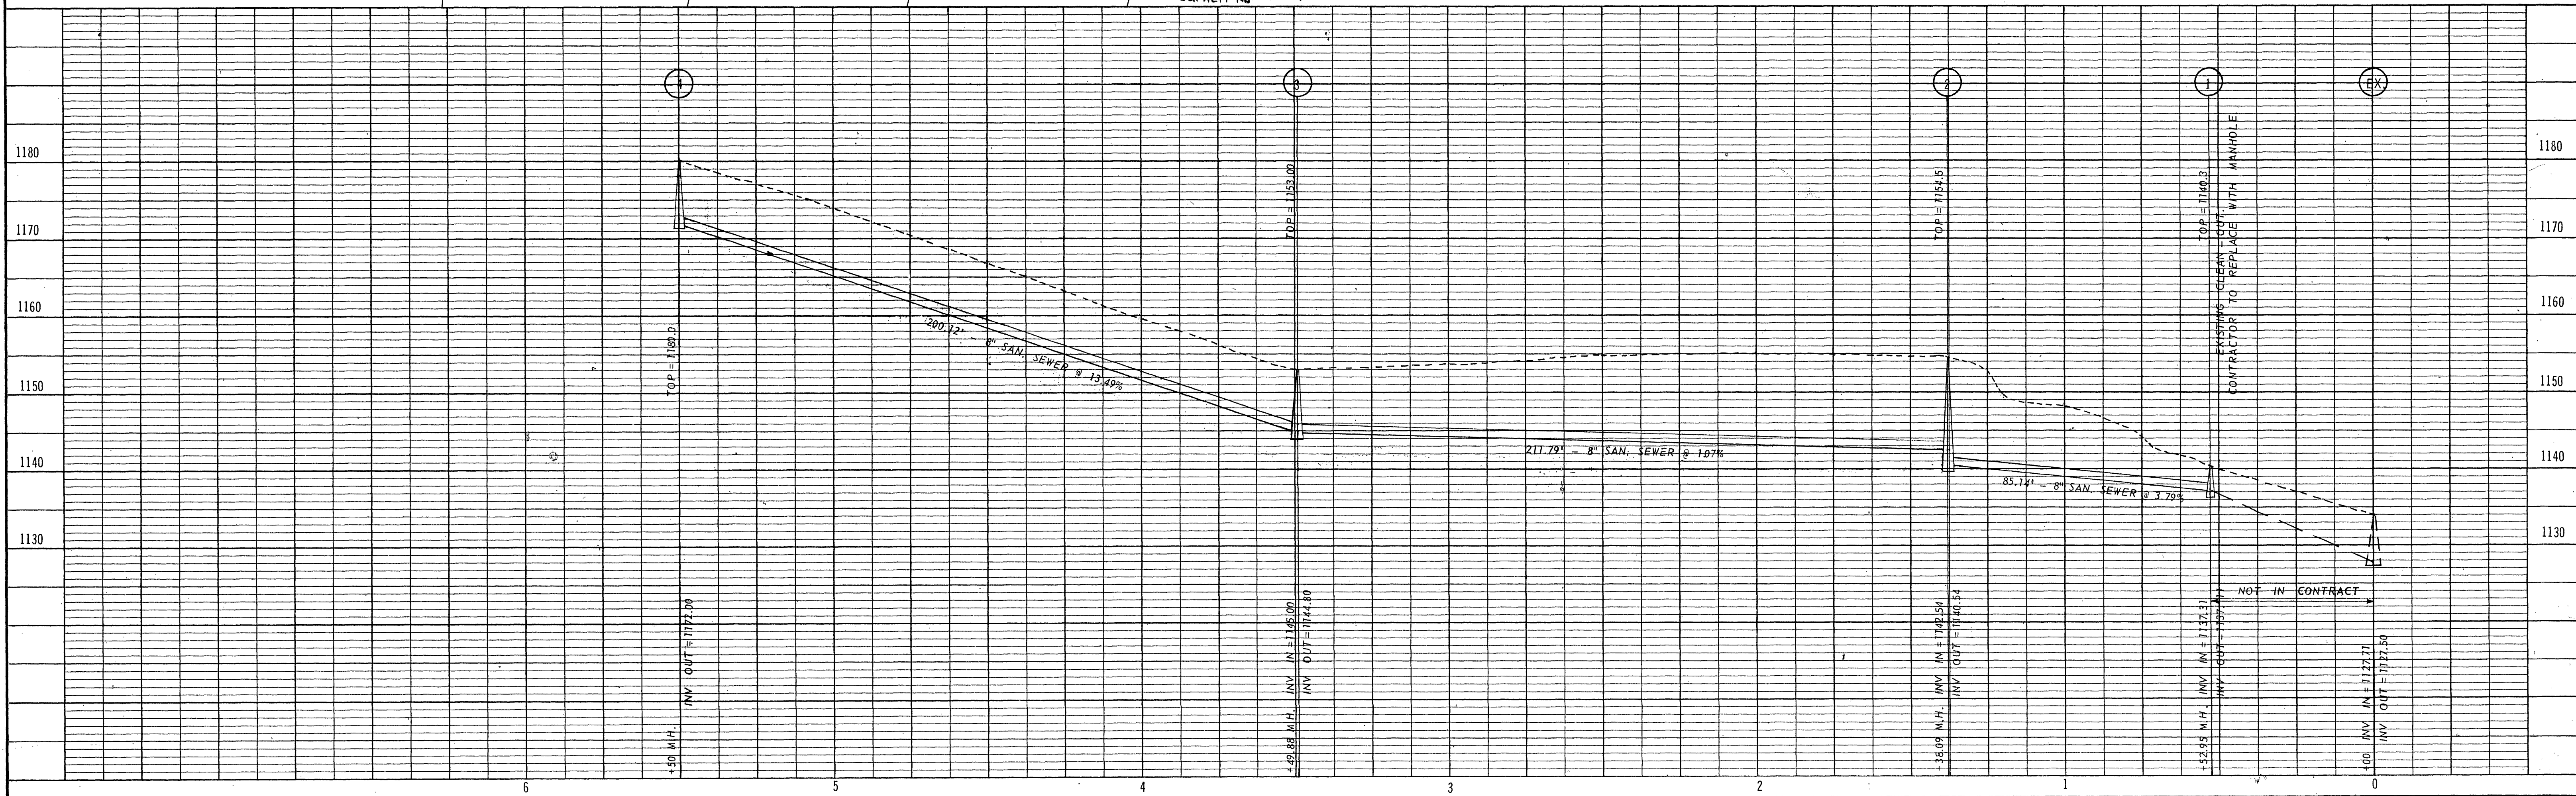

GARDEN GRACE ST