


These documents are the property of Parker Design Group (PDG) and may not be reproduced or used without the express permission of PDG. Any reuse of these documents without authorization of PDG will be at the sole risk of the individual or entity utilizing said documents.

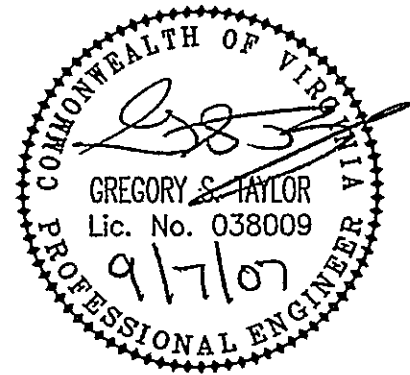

Green Hill Sewer Extension Record Drawings

**Catawba Magisterial District
Roanoke County, Virginia**

REVISIONS:

100

DESIGNED BY: GST

DRAWN BY: GST

CHECKED BY: GST

SCALE: 1" = 50'

DATE: September 7, 2007

SHEET TITLE:

Record Drawing

C01

01 OF 02

PROJECT NUMBER:

07-0242

