


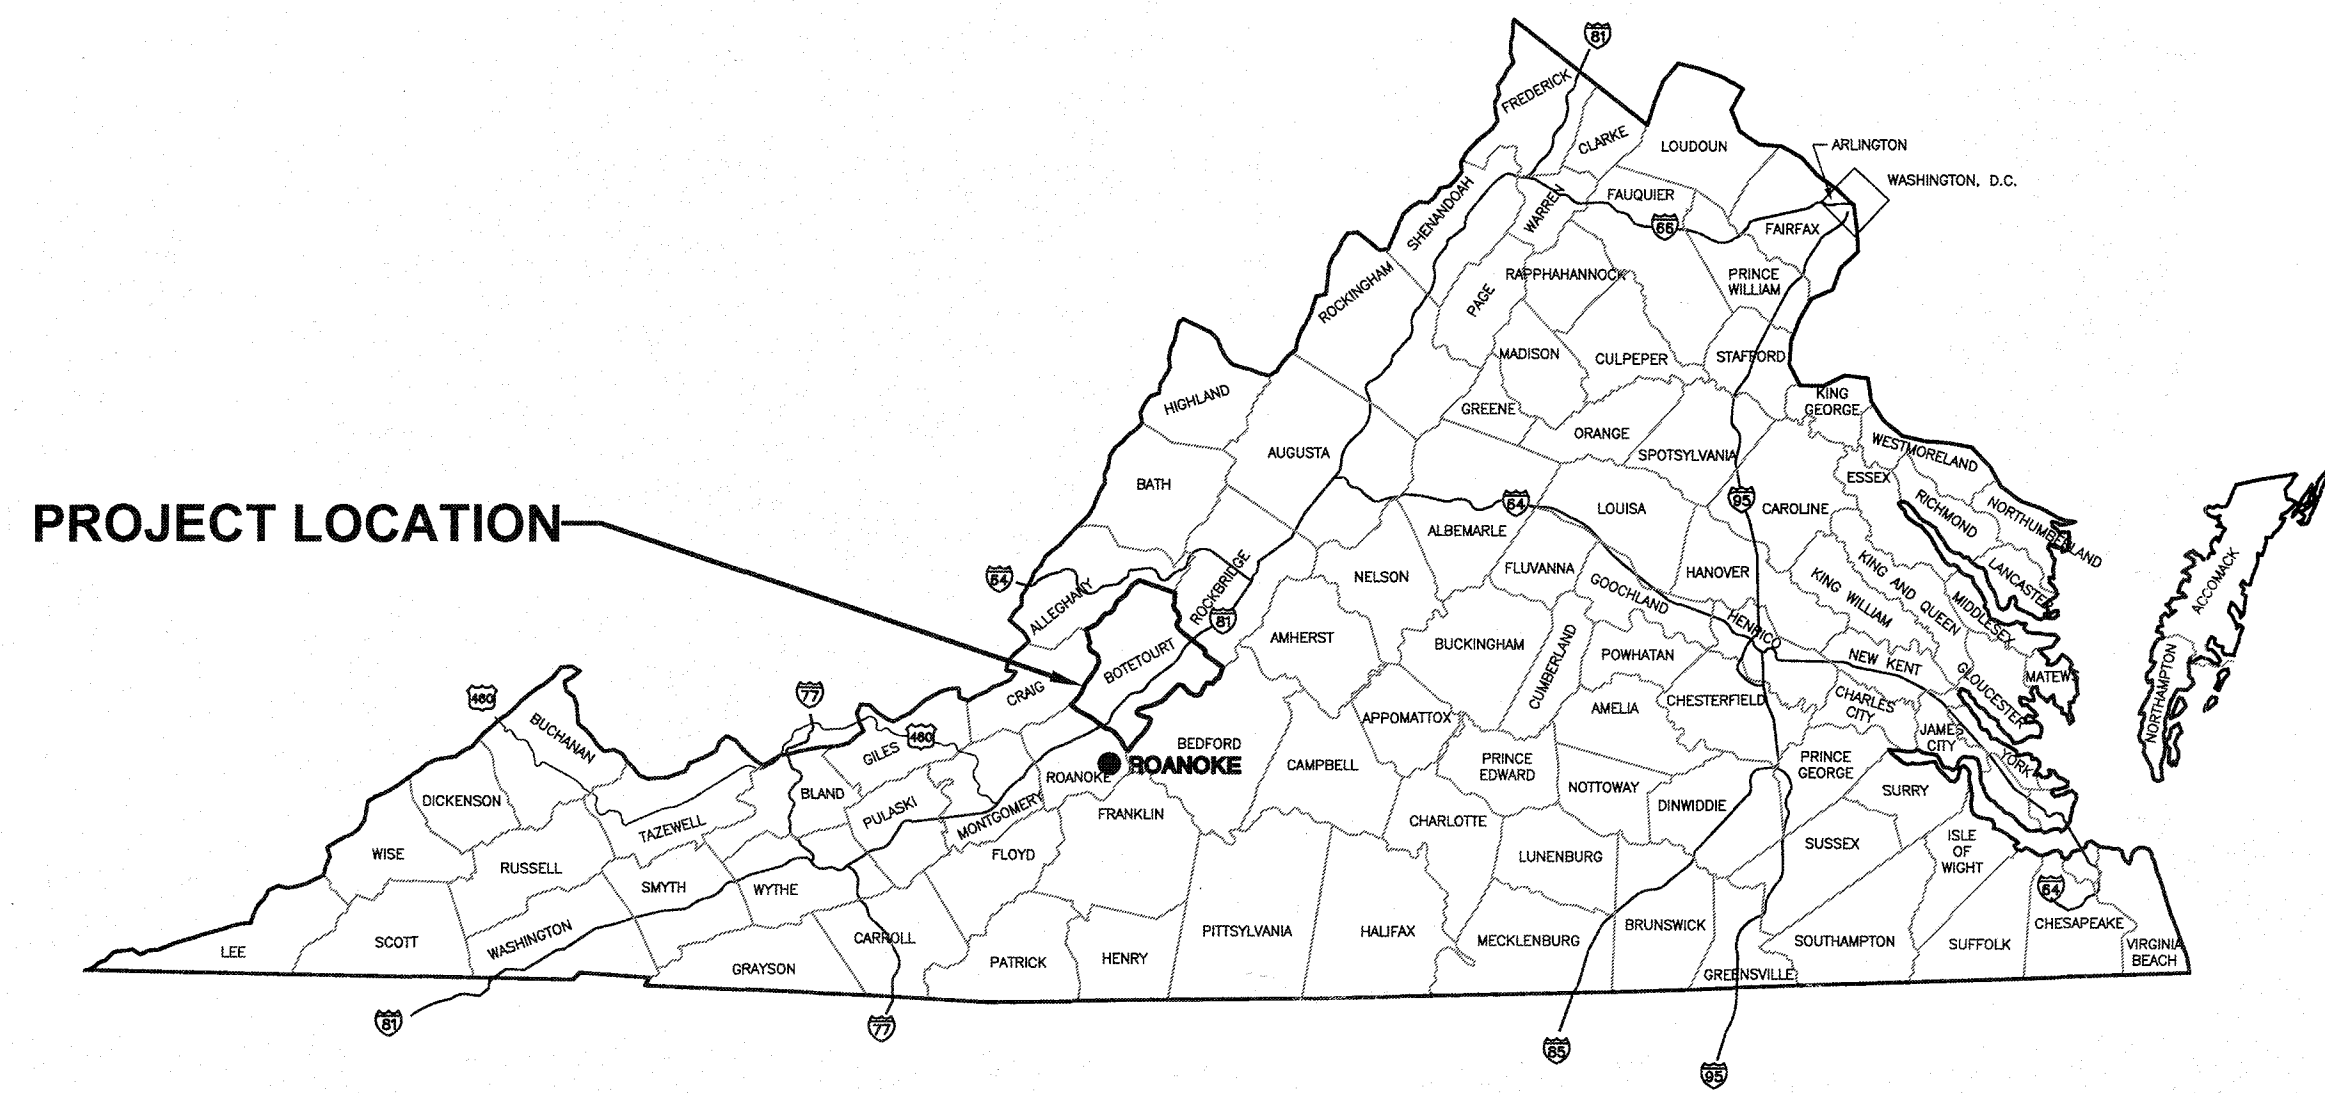

PROJECT LOCATION MAP
N.T.S.




PROJECT AREA MAP
N.T.S.

GREEN RIDGE ROAD SANITARY SEWER REPLACEMENT

SANITARY SEWER SYSTEM IMPROVEMENTS ROANOKE COUNTY, VIRGINIA

PREPARED FOR
WESTERN VIRGINIA WATER AUTHORITY

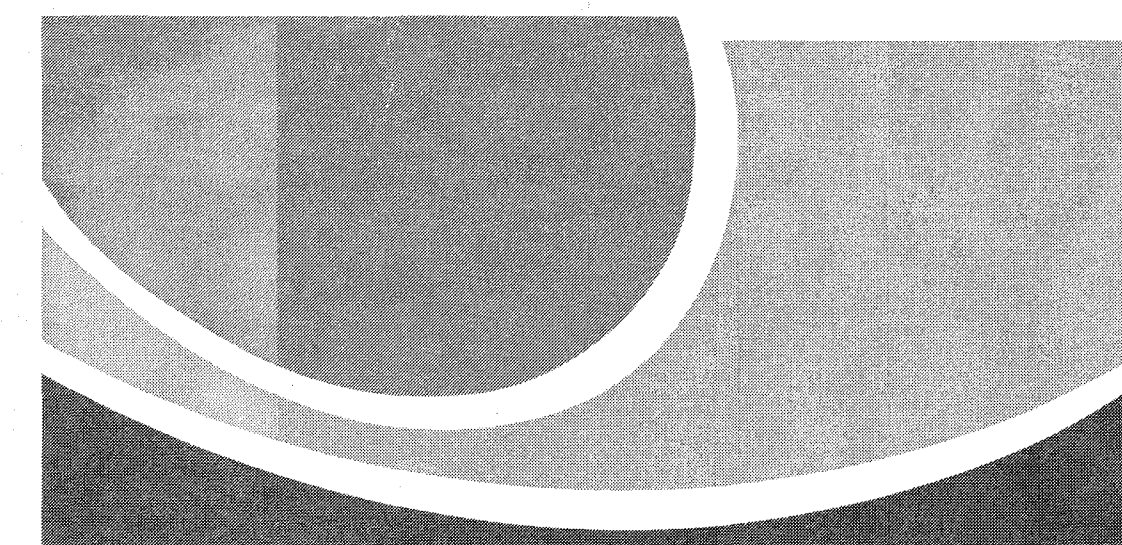

WESTERN VIRGINIA
WATER AUTHORITY

DESIGNED BY
HURT & PROFFITT, INC.
BLACKSBURG, VIRGINIA

FUNDED BY
WESTERN VIRGINIA WATER AUTHORITY

APPROVED FOR CONSTRUCTION


TRAFFIC MANAGEMENT PLAN REVISED 06/15/2020

Contractor: Menden
Inspector: Bruce Peters
1-8-2020

HURT & PROFFITT
1861 PRATT DRIVE, SUITE 1100
BLACKSBURG VA 24060
1.800.763.5596 TOLL FREE
540.552.5592 MAIN
540.552.5729 FAX
ENGINEERING • SURVEYING • LAND DEVELOPMENT • ENVIRONMENTAL
GEOTECHNICAL • CONSTRUCTION TESTING & INSPECTION • CULTURAL RESOURCES

TITLE SHEET
FOR
WVWA SANITARY SEWER REPLACEMENT
ROANOKE COUNTY, VA

PROJECT NO. 20190008
LAT. 37.174875
LONG. -80.375128
DATE: 20 DEC 19
DRAWN BY: CBD, TJK
CHECKED BY: DAA

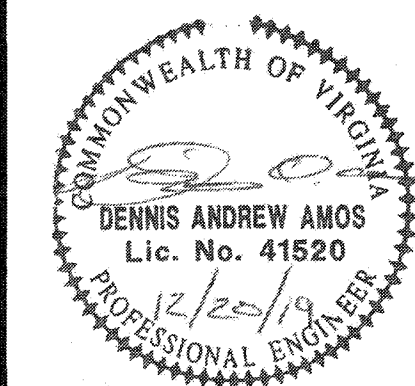

TITLE SHEET

SHEET NO.
G100

As Built
1-8-2020
Green Ridge