




THE CONTRACTOR WILL BE RESPONSIBLE FOR MATERIAL STORAGE, DISPOSAL, AND STOCKPILES. THIS PLAN DOES NOT ACCOUNT FOR ANY LOCATION FOR SUCH. IF STORAGE OR DISPOSAL AREAS ARE REQUIRED FOR THIS PROJECT, THE CONTRACTOR WILL COORDINATE THOSE LOCATIONS AND MAKE REDLINED CHANGES TO THE APPROVED PLAN AND E&SC PLAN.

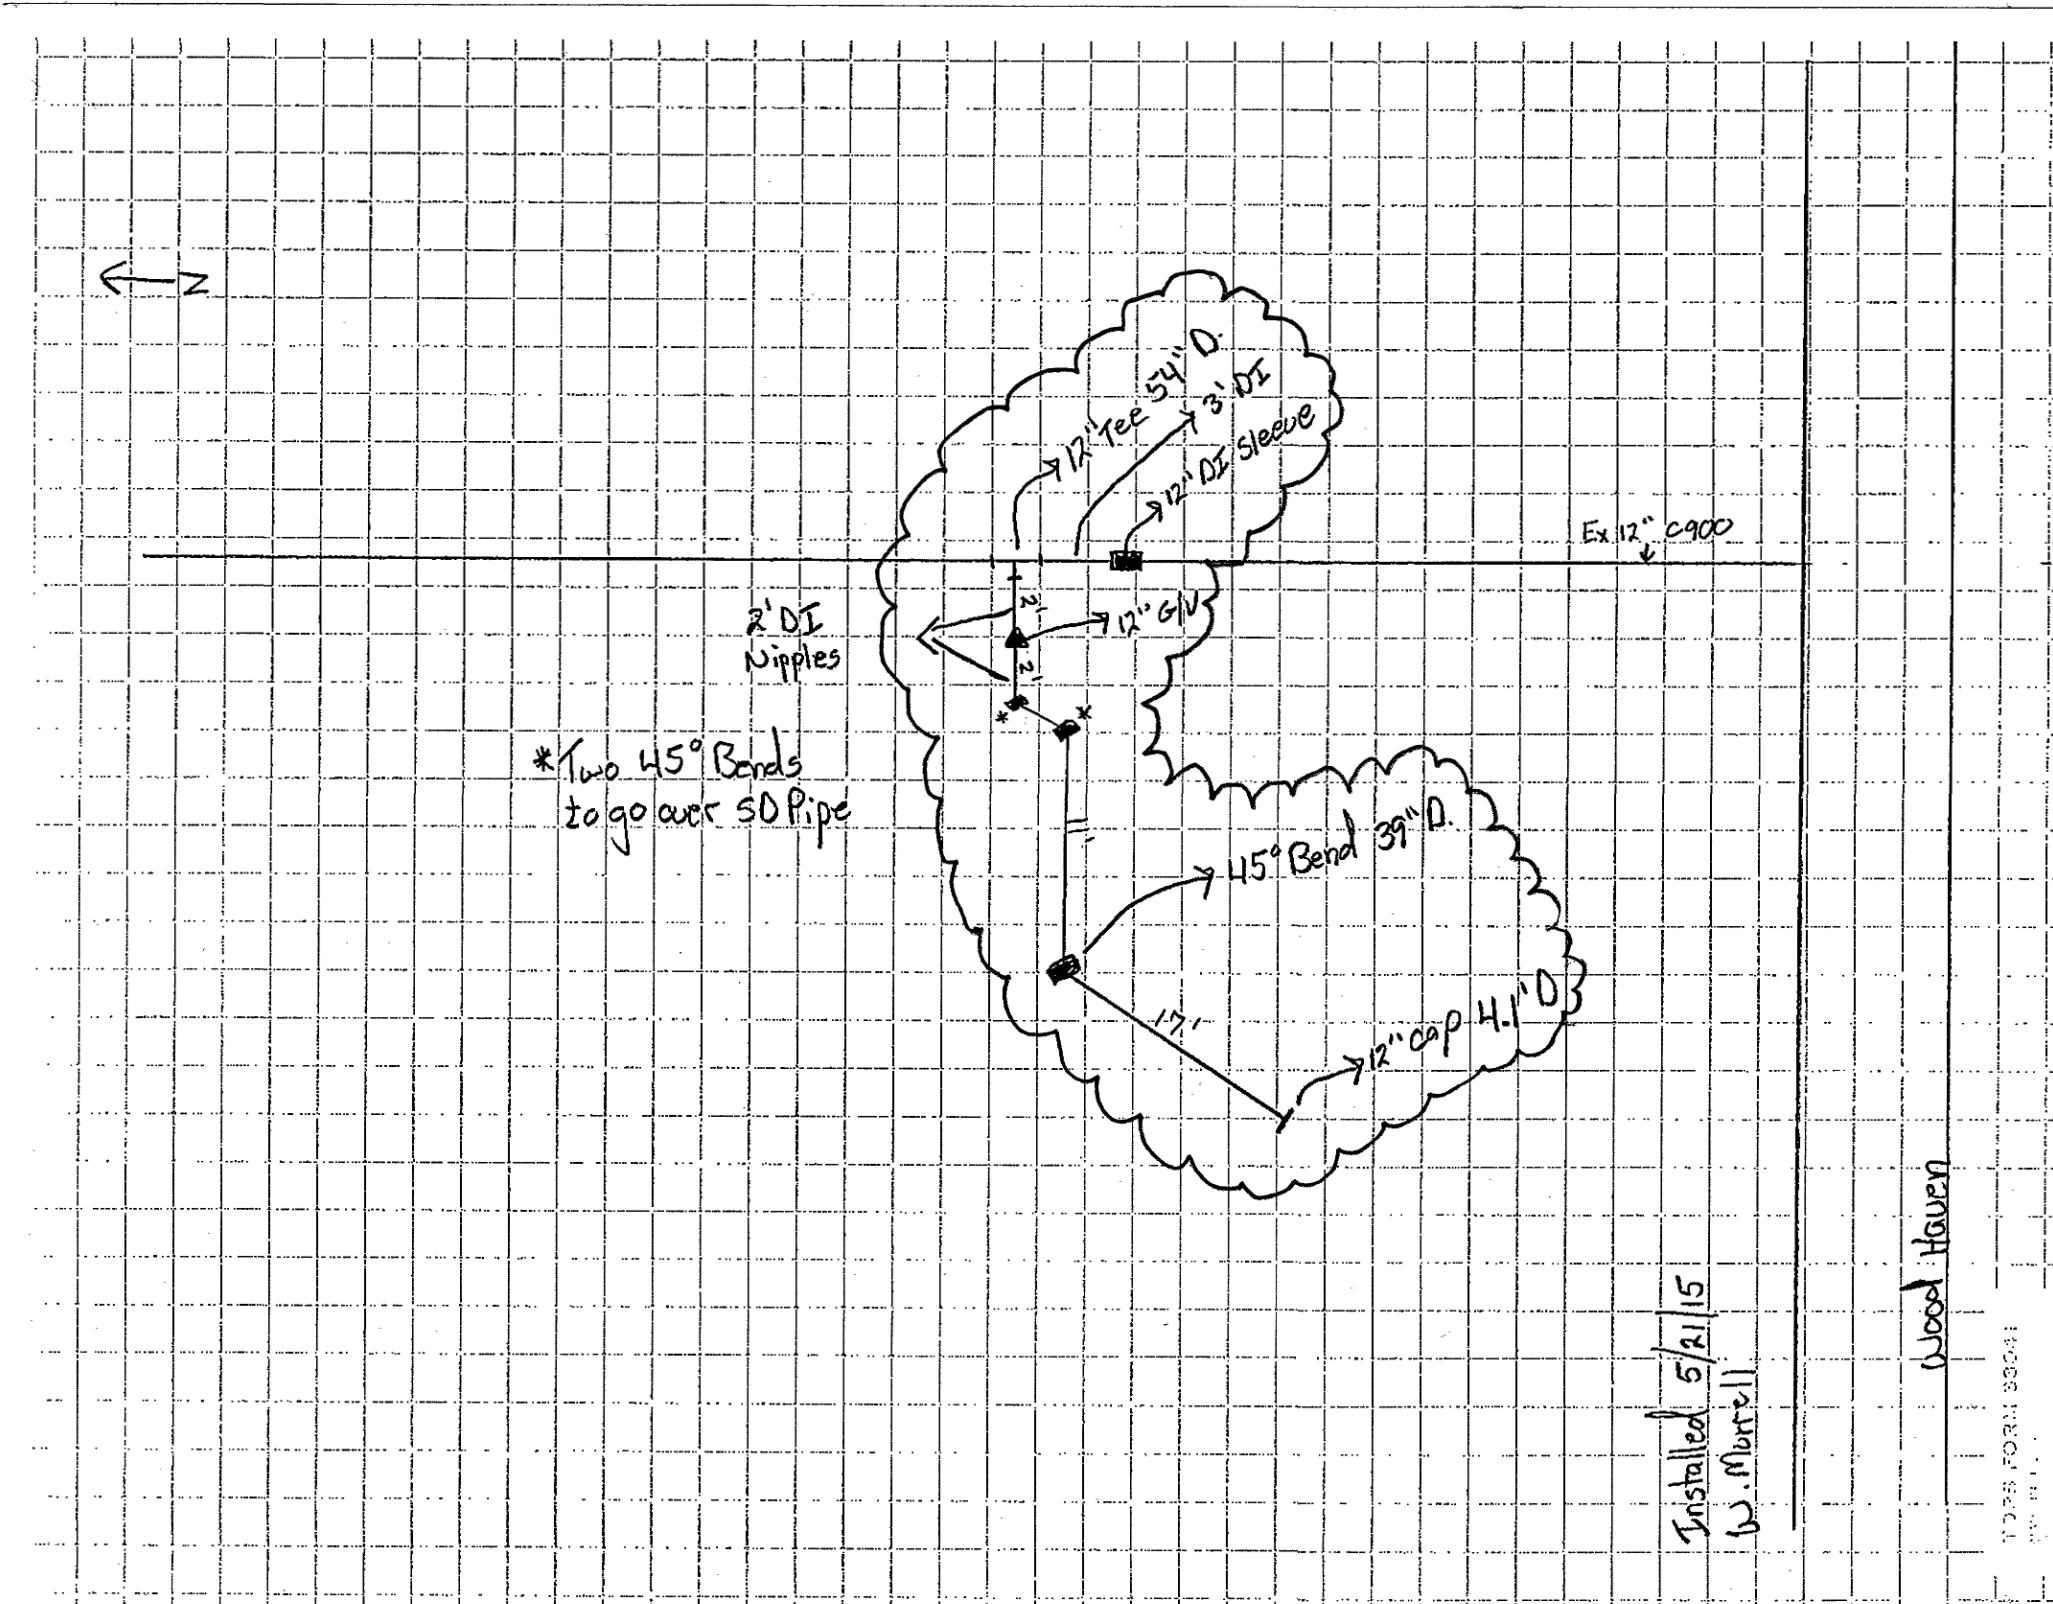

- CONSTRUCTION NOTES:**
- 1) PROPOSED GRADING SHOWN WILL BE PERFORMED BY OTHERS PRIOR TO TANK CONSTRUCTION. TANK CONTRACTOR WILL BE RESPONSIBLE FOR FINAL GRADING WITHIN TANK SITE AREA AFTER TANK FOUNDATION, PIPING, AND OTHER INCIDENTALS ARE COMPLETE.
 - 2) ALL NECESSARY E&S MEASURES SHALL BE INSTALLED BY TANK CONTRACTOR AS SHOWN. TANK CONTRACTOR WILL BE RESPONSIBLE FOR ESTABLISHING PERMANENT VEGETATION ON ALL AREAS WITHIN LIMITS OF DISTURBANCE AND ANY OTHER AREAS THAT ARE DISTURBED BY TANK CONTRACTOR DURING THE PROJECT.
 - 3) REINSTALLATION OF FENCE AND MONUMENTS (PART OF THE VDOT LANDSCAPING PLAN) WILL BE PERFORMED BY OTHERS AFTER THE TANK PROJECT IS COMPLETE. THE VDOT LANDSCAPING PLAN IS AVAILABLE TO THE TANK CONTRACTOR UPON REQUEST.
 - 4) ALL CONSTRUCTION SHALL BE IN ACCORDANCE WITH THE LATEST EDITION OF THE WESTERN VIRGINIA REGIONAL DESIGN AND CONSTRUCTION STANDARDS.

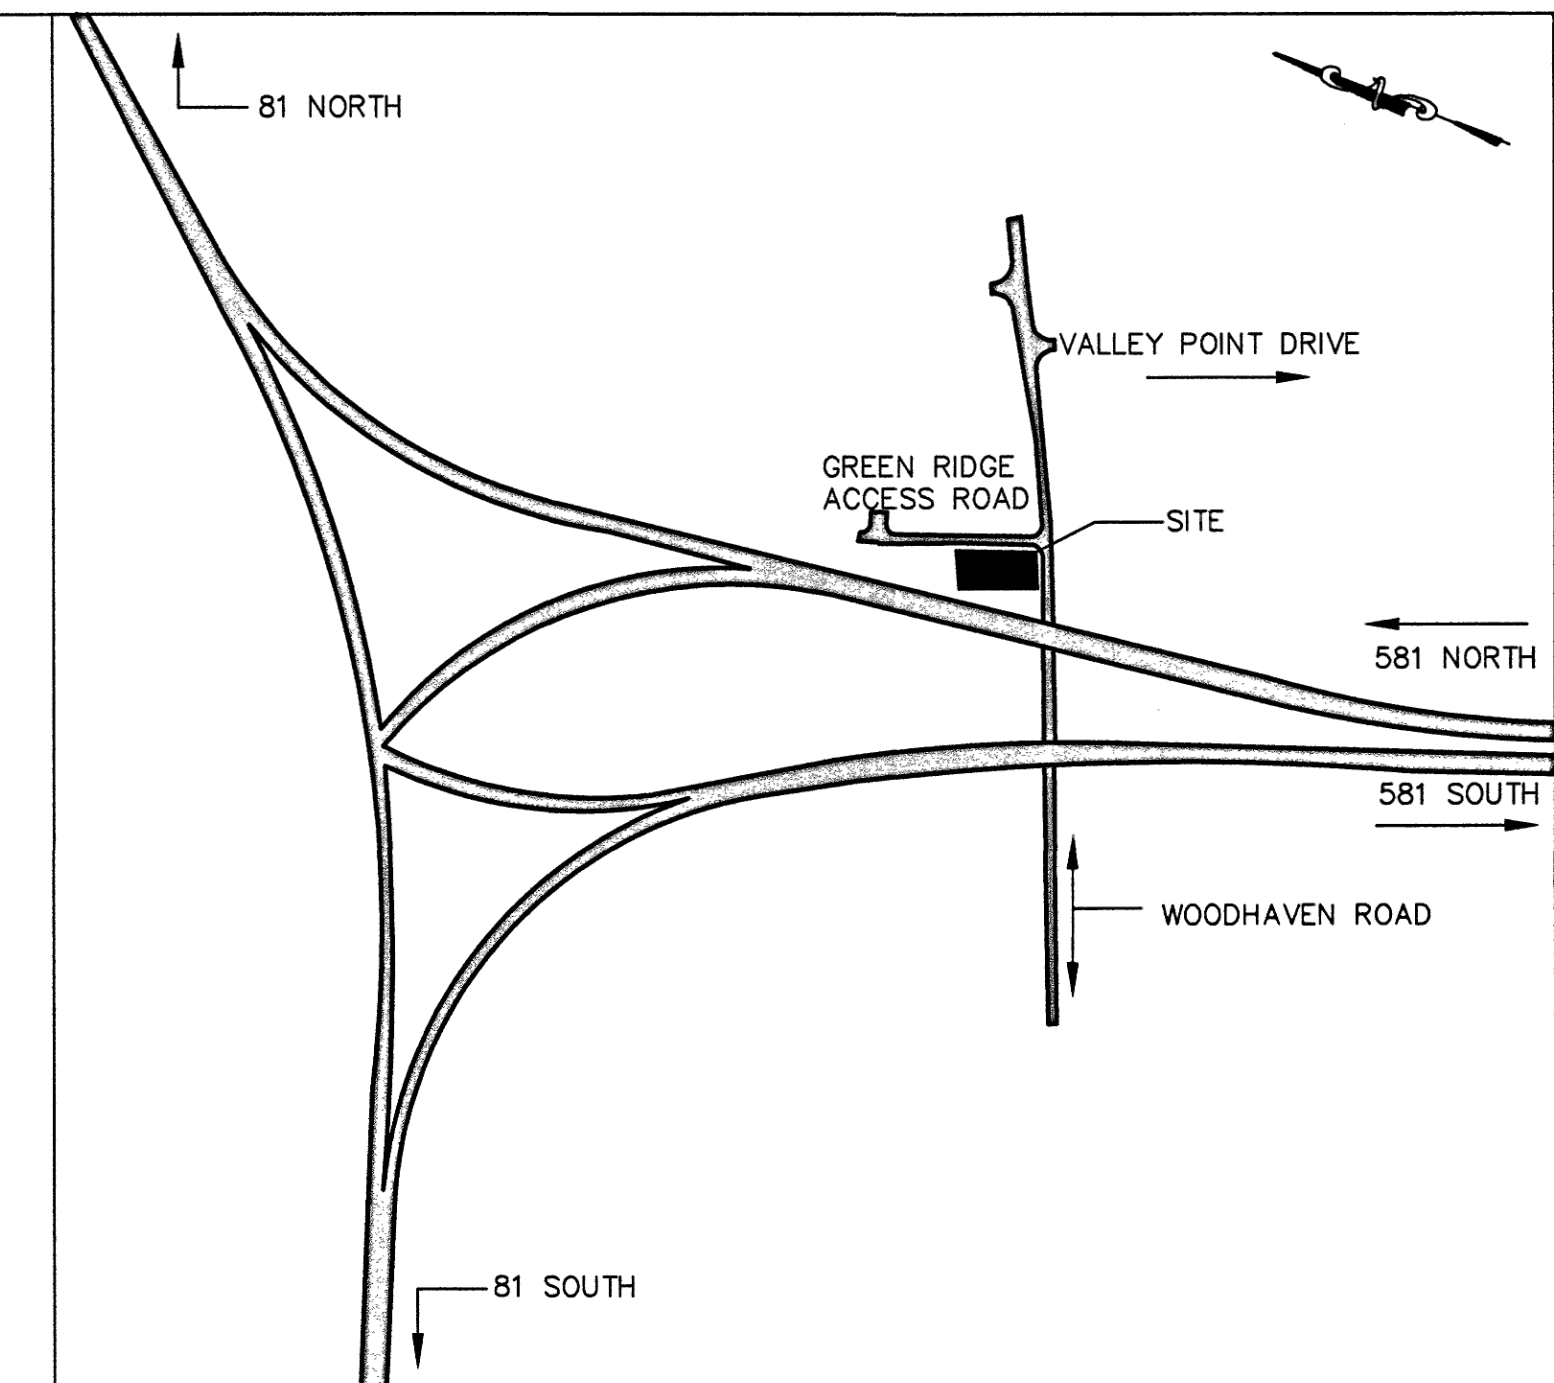

VICINITY MAP
SCALE 1"=500'

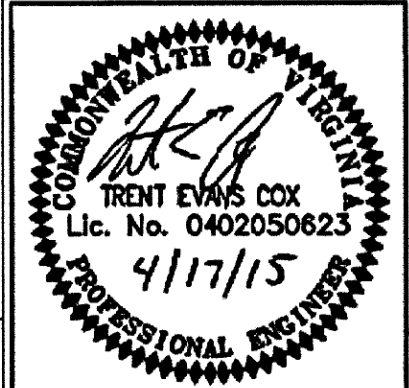

**WESTERN VIRGINIA
WATER AUTHORITY**

ENGINEERING SERVICES
601 S JEFFERSON ST, SUITE 300
ROANOKE, VA 24011
540-853-5641 or 540-853-5770

GREEN RIDGE WATER STORAGE TANK

SITE PLAN

Rev	Description	Date	By
1	E&SC NOTES	3-31-15	TEC
2	ADDENDUM 1	4-17-15	TEC
Designed: AAS			
Drawn: AAS			
Checked: TEC			
Approved:			
Date:		2-13-15	
Project:			

2
Sheet 2 of 5

