



ACCESS DOOR CONCRETE RAMP

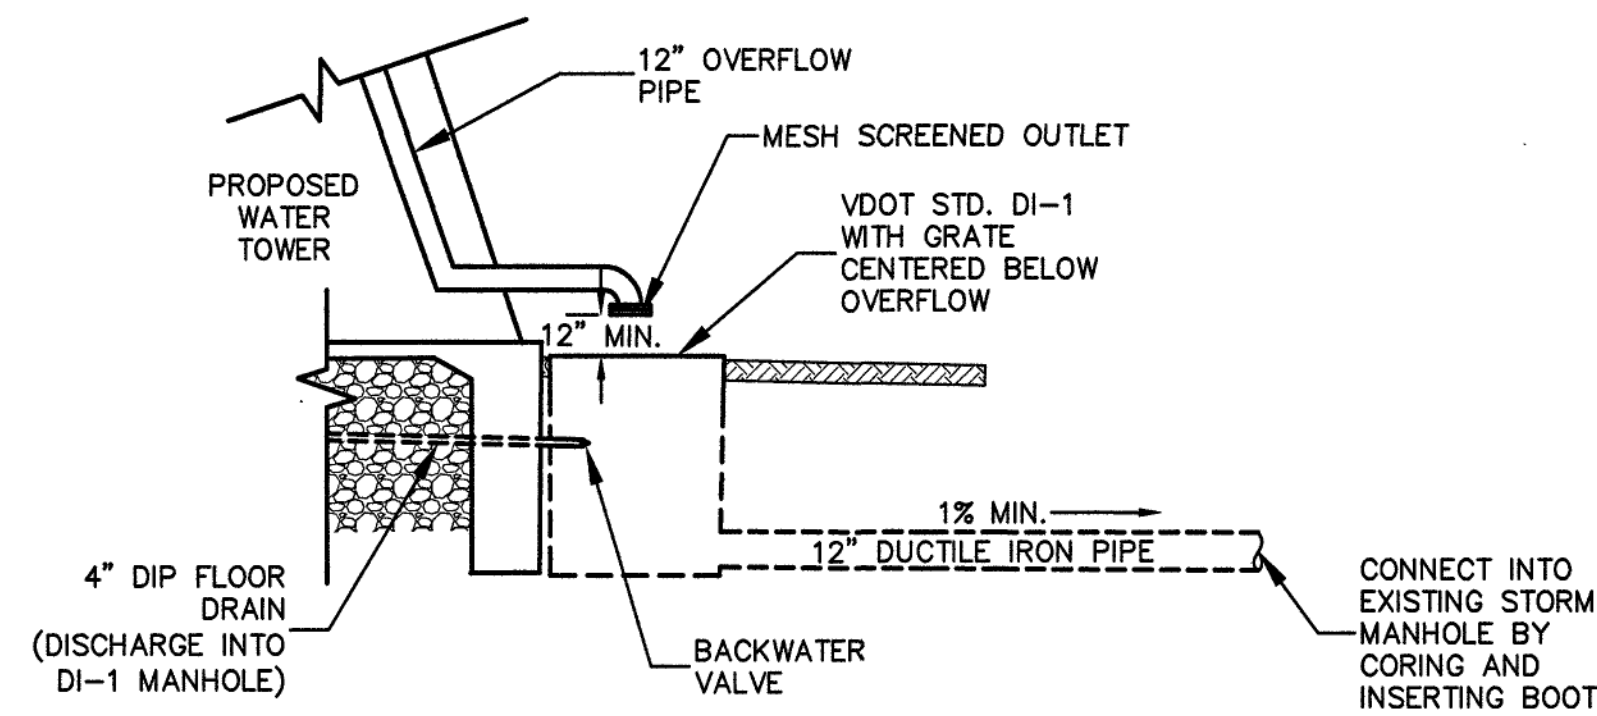

TANK OVERFLOW DETAIL

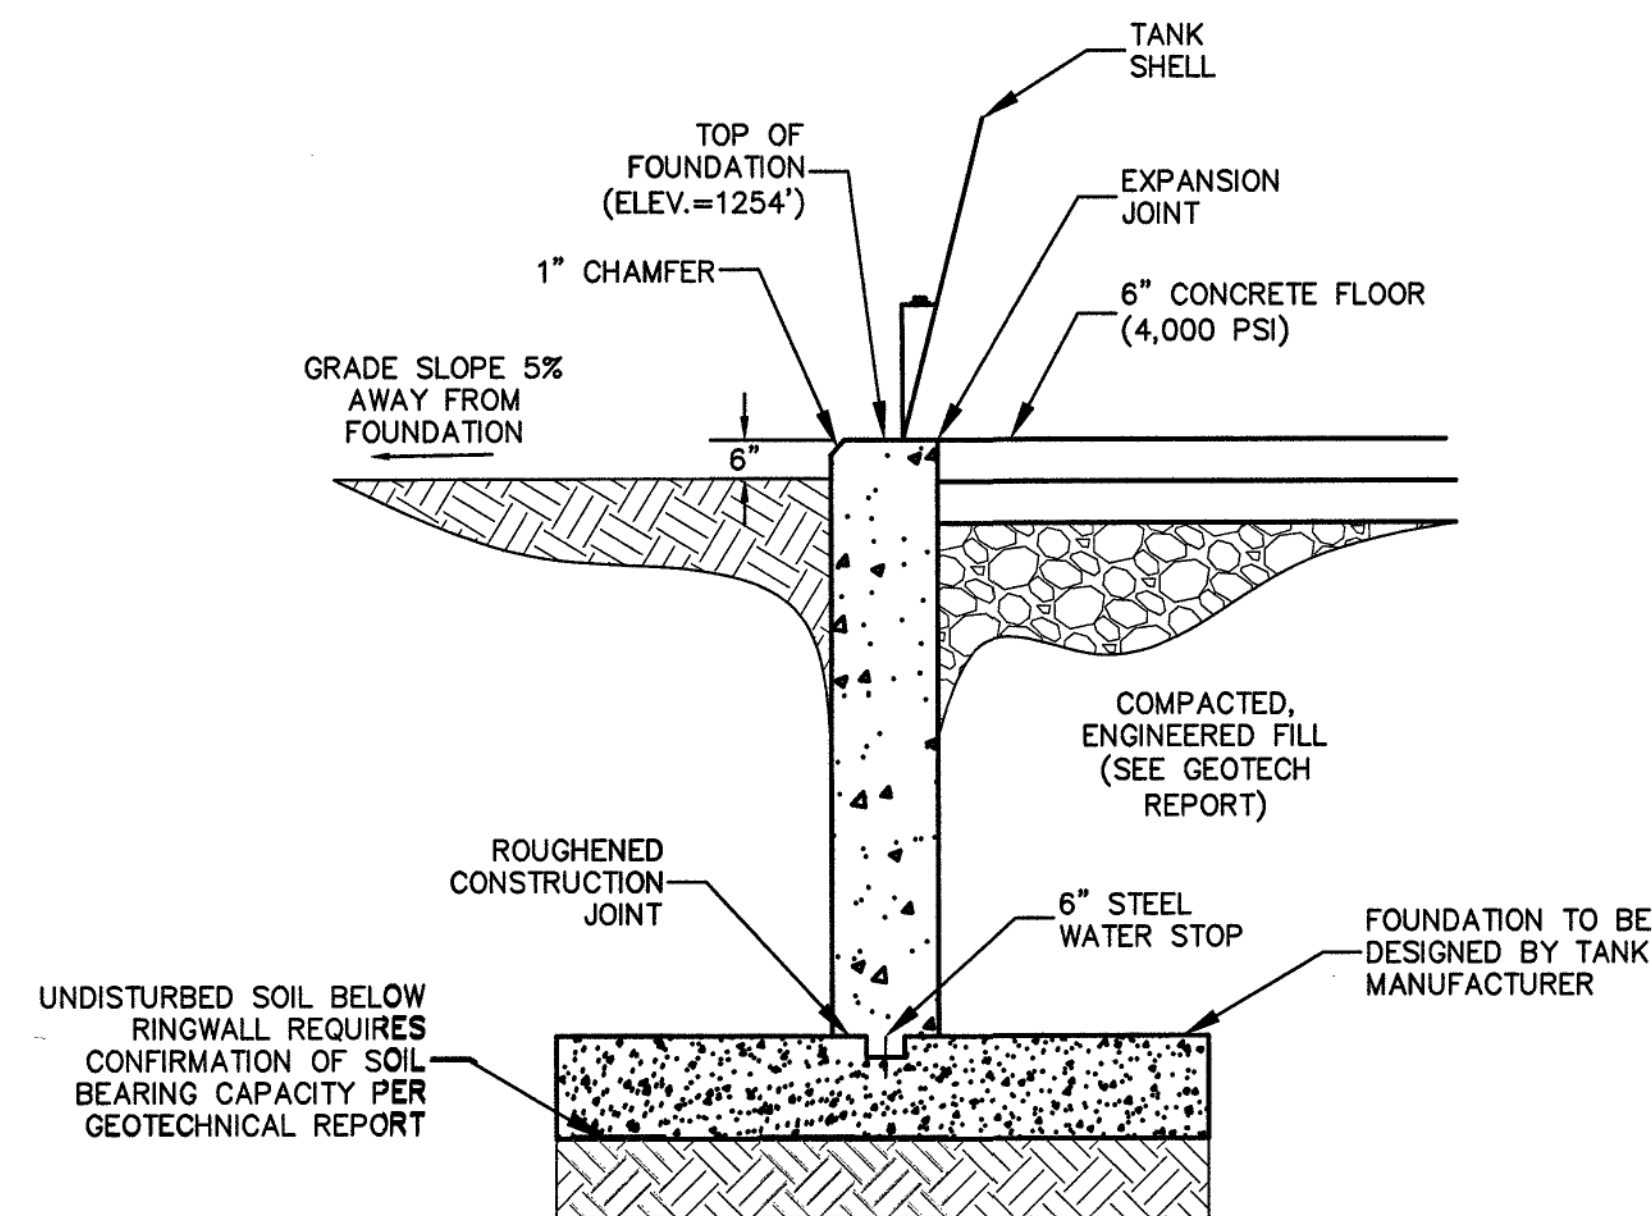

SECTION-TYP. FOUNDATION

- NOTES:**
1. ALL DETAILS SHOWN ON THIS SHEET ARE FOR SCHEMATIC REFERENCE ONLY.
 2. DIMENSIONS AND REFERENCES SHOWN SHALL BE CONSIDERED THE MINIMUM ACCEPTABLE.
 3. TANK, APPURTENANCES, AND FOOTING TO BE DESIGNED BY MANUFACTURER IN ACCORDANCE WITH APPLICABLE AWWA STANDARDS, AND WESTERN VIRGINIA WATER AUTHORITY DRAWINGS AND SPECIFICATIONS.
 4. DRAWINGS AND DETAILS ON THIS SHEET ARE NOT TO SCALE.

AS BUILT 3/8/17

Rev	Description	Date	By
1	TANK NOTES	3-31-15	

Designed: TEC
Drawn: TEC
Checked: RWB
Approved:
Date: 2-13-15
Project: