



TANK ROOF ORIENTATION

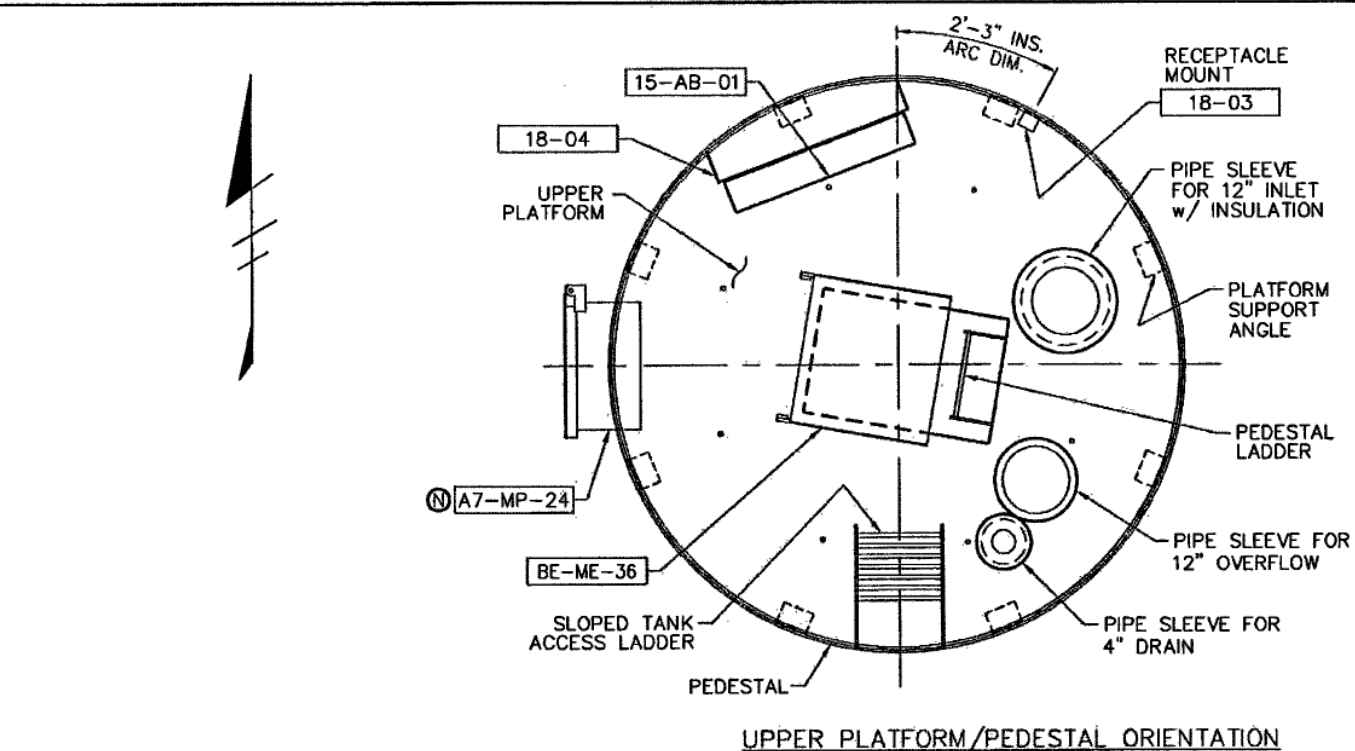


UPPER PLATFORM/PEDESTAL ORIENTATION

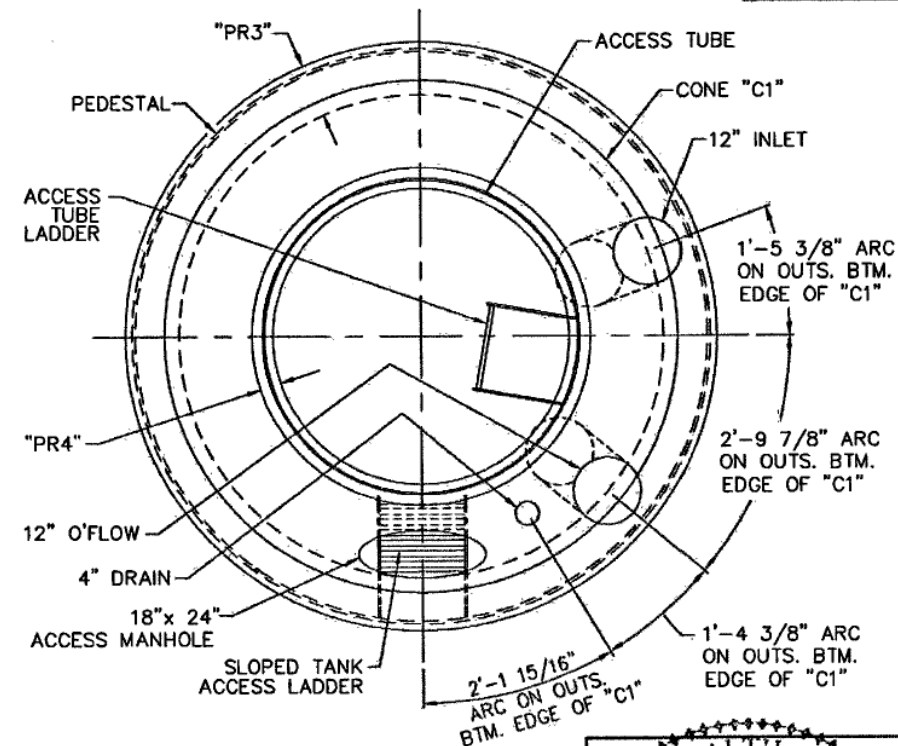

ACCESS TUBE/CONE ORIENTATION

AS BUILT

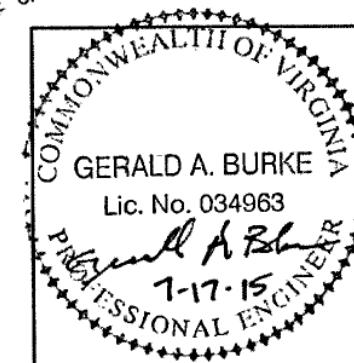

REV.	BY:	DATE	REMARKS
CALDWELL <small>Since 1887</small> Water • Energy • Industrial ROANOKE, VIRGINIA 250,000 GALLON PEDESHERE			
BY: AMK	TITLE: ORIENTATION DETAILS		
DATE: 07/07/15	DRAWING NO.: E-8344 02		