



PEDESTAL PLATES						
PART #	NO.	THK.	HEIGHT	LENGTH	DIAGONAL	WEIGHT
05-04	2	15/32"	9'-11"	28'-4 13/16"	30'-1"	5,395
05-03	2	1/2"	9'-11"	28'-4 3/4"	30'-0 15/16"	5,750
05-02	1	17/32"	9'-11"	28'-4 5/8"	30'-0 13/16"	6,110
05-01	1	9/16"	9'-4 1/4"	28'-4 9/16"	29'-10 9/16"	6,100

NOTES:


- LENGTHS SHOWN INCLUDE 1/8" WELD GAP FOR WELD SEAMS (SHOP OR FIELD).

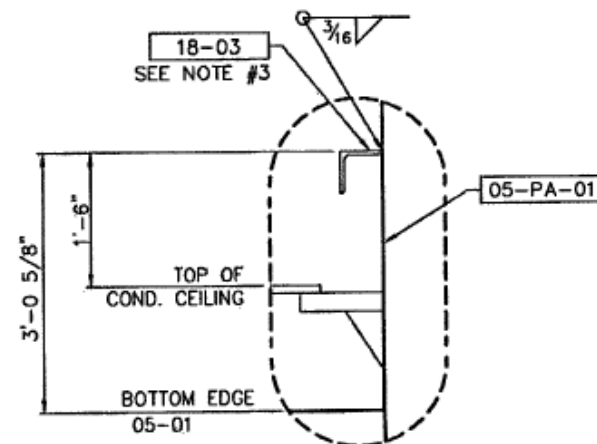

DETAIL "A"

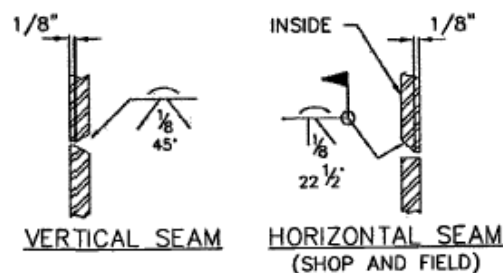

PEDESTAL WELD DETAILS

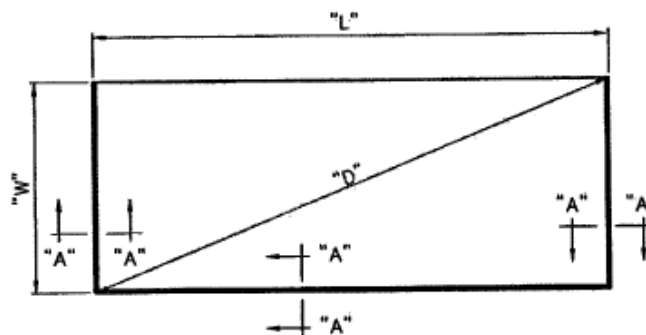


PEDESTAL PLATE

SHIPPING ITEM	QTY.	P.C. MK.	QTY.	MATERIAL REQ'D.	DESCRIPTION	UNIT WT.
05-PA-01	1			BOTTOM PEDESTAL ASSEMBLY - 11'-1 1/4"		7,820
		05-01	1	PL C/F (1) 9/16" x 114" x 344"	PED PL "P1"	
		13-09	1	CH C5 x 6.7# x 8'-3 1/4"	BRACE	
		18-02	1	FB 1/4" x 2" x 8 1/2"	CONDUIT CLIP	
		11-LA-02	1	PEDESTAL LADDER		
		04-04	10	PL C/F (1) 5/8" x 84" x 147"	BASE TRANS. "B4"	
		03-02	4	PL C/F (1) 1/2" x 60" x 120"	PL RING "PR2"	
		03-08	8	PL 1/2" THK.	GUSSETS	
		18-04	1	FB 1/4" x 2" x 4'-2" (BEND)	CABLE BRACKET	
		18-03	1	AN 4" x 4" x 1/4" x 4"	RECEPTACLE	
05-PA-02	1			INT. PEDESTAL ASSEMBLY - 19'-10 1/8"		12,150
		05-02	1	PL C/F (1) 17/32" x 120" x 344"	PED PL "P2"	
		05-03	1	PL C/F (1) 1/2" x 120" x 344"	PED PL "P3"	
		13-09	2	CH C5 x 6.7# x 8'-3 1/4"	BRACE	
		18-02	2	FB 1/4" x 2" x 8 1/2"	CONDUIT CLIP	
		11-LA-02	1	PEDESTAL LADDER		
		18-04	2	FB 1/4" x 2" x 4'-2" (BEND)	CABLE BRACKET	
05-PA-03	1			INT. PEDESTAL ASSEMBLY - 19'-10 1/8"		11,435
		05-03	1	PL C/F (1) 1/2" x 120" x 344"	PED PL "P4"	
		05-04	1	PL C/F (1) 15/32" x 120" x 344"	PED PL "P5"	
		13-09	2	CH C5 x 6.7# x 8'-3 1/4"	BRACE	
		18-02	2	FB 1/4" x 2" x 8 1/2"	CONDUIT CLIP	
		11-LA-02	1	PEDESTAL LADDER		
		18-04	2	FB 1/4" x 2" x 4'-2" (BEND)	CABLE BRACKET	

NOTE:

1. SEE DWG. 15 FOR CHANNEL BRACE INSTALLATION.
2. SEE DWG. 02, 02A, 15 & 18 FOR CABLE BRACKET (18-04) ORIENTATION. INSTALL AT SAME ELEVATION AS 13-09.
3. SEE DWG. 02A, FOR RECEPTACLE BRACKET (18-03) ORIENTATION.

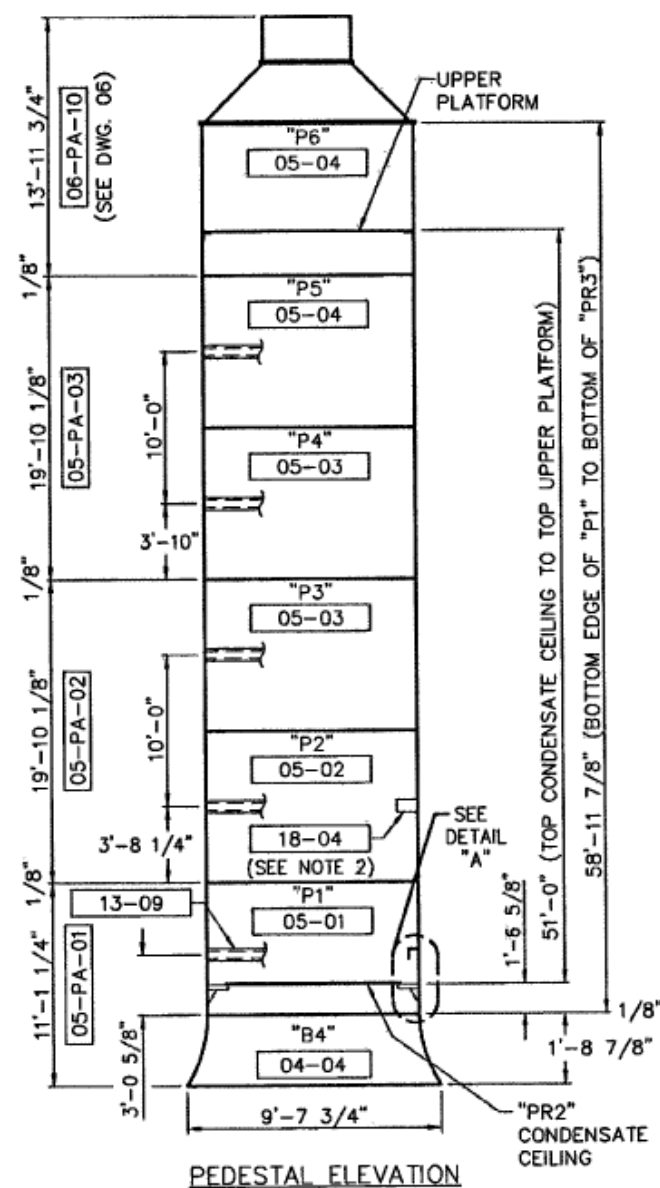

PEDESTAL ELEVATION

AS BUILT

COMMONWEALTH OF VIRGINIA GERALD A. BURKE Lic. No. 034963 PROFESSIONAL ENGINEER 7-17-15		REV.	BY:	DATE	REMARKS
		CALDWELL Water • Energy • Industrial ROANOKE, VIRGINIA 250,000 GALLON PEDESHERE			
		BY:	AMK	TITLE: PEDESTAL ASSEMBLY	
		DATE:	07/07/15	DRAWING NO.: E-8344 05	