
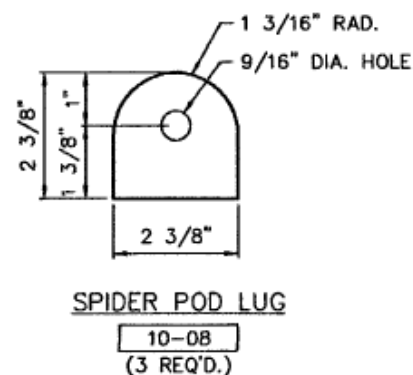


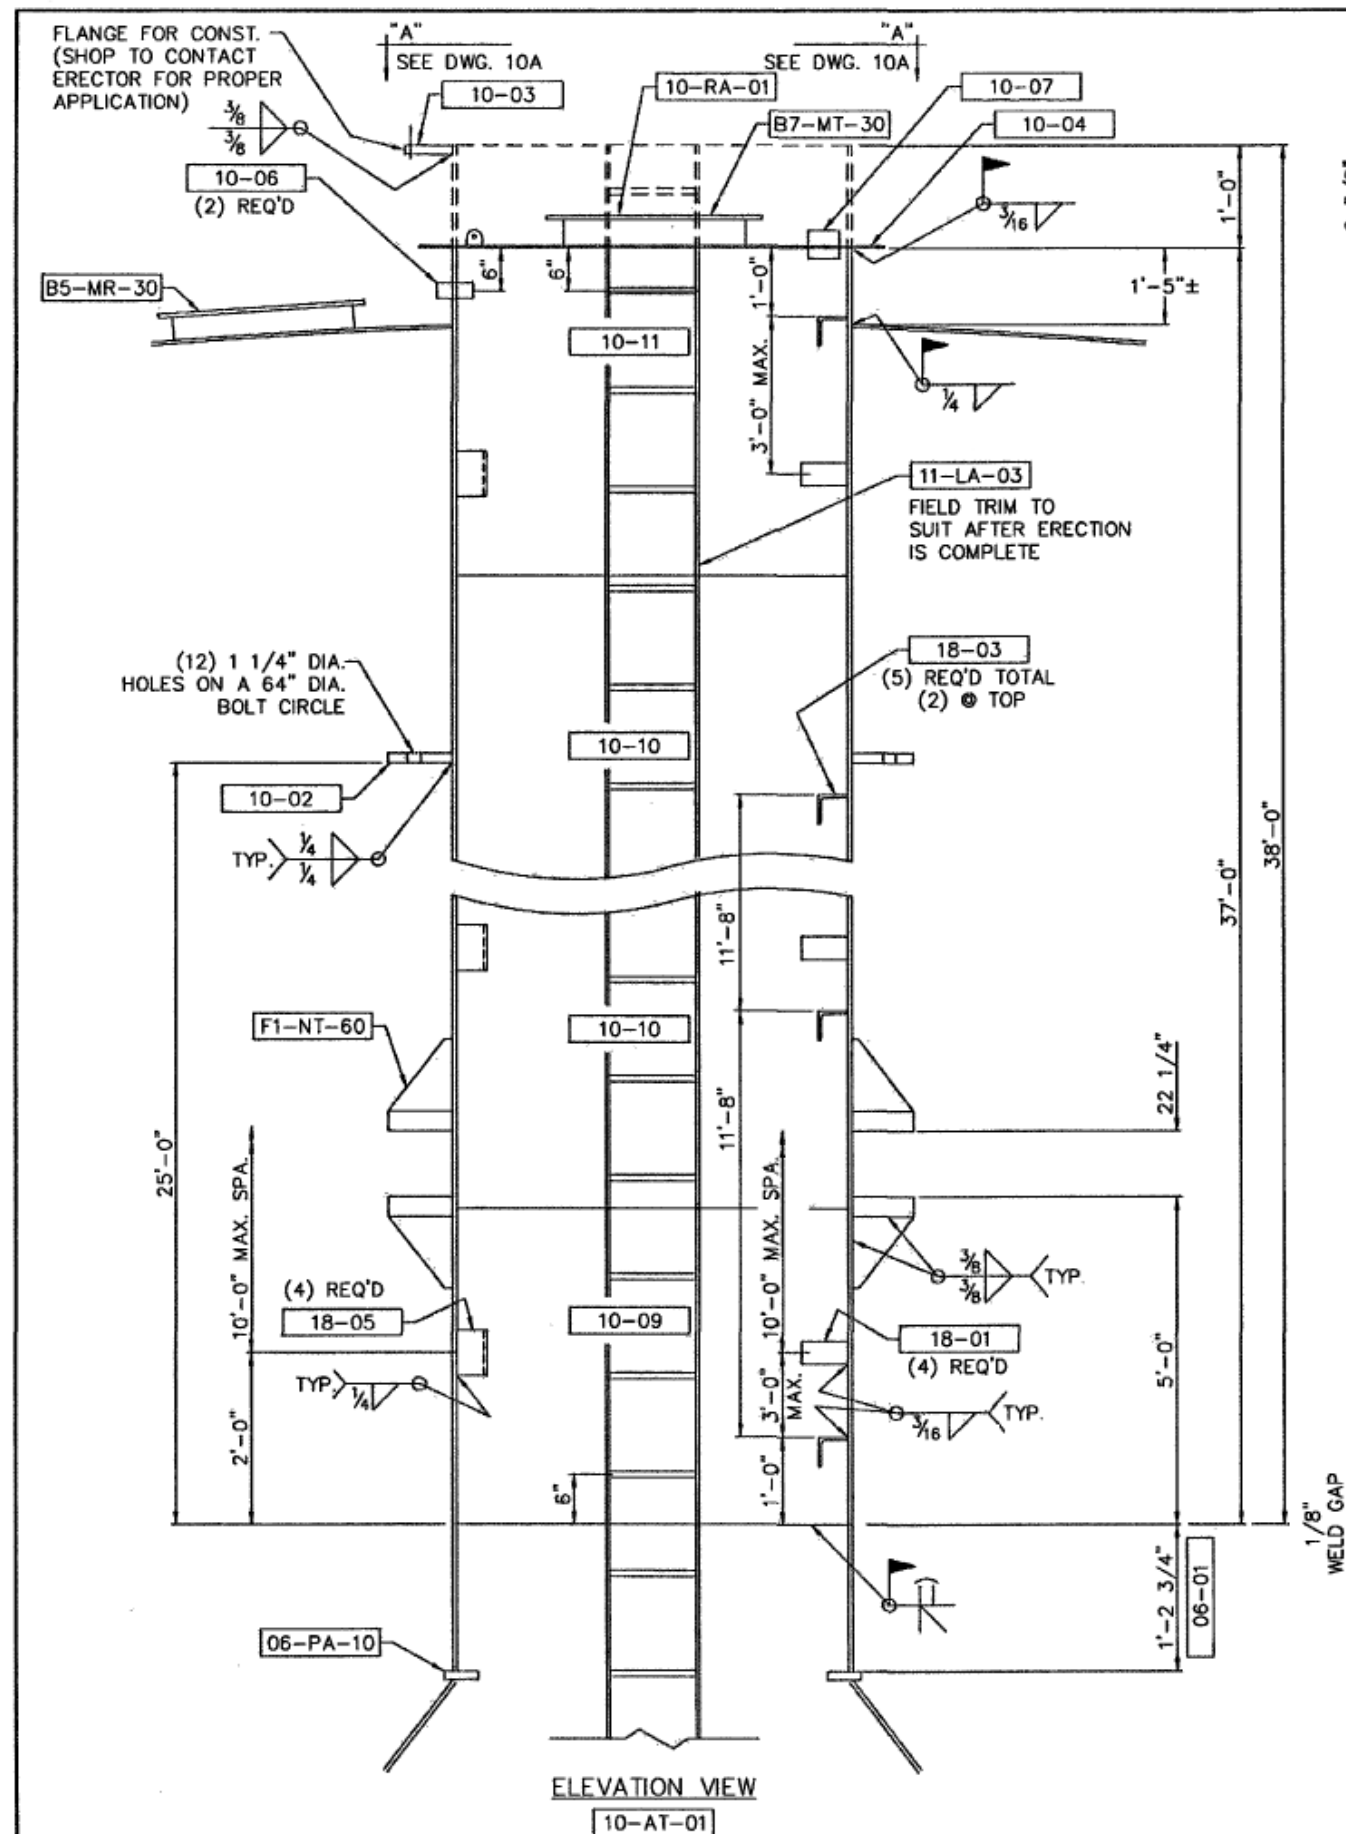


SHIPPING ITEM	QTY.	PC. MK.	QTY.	MATERIAL REQ'D	DESCRIPTION	UNIT WT.
10-AT-01	1			ACCESS TUBE ASSEMBLY 38'-0"		12,000
		10-02	1	PL 1/2" x 68 1/4" OD x 60 1/4" ID	ERECTION RING	
		F1-NT-60	1	ST FOR 60" ACCESS TUBE	TURNABLE	
		10-03	1	PL FOR 60" ACCESS TUBE	CONST. FLANGE	
		18-01	4	FB 1/4" x 2" x 6"	CONDUIT LUG	
		18-03	5	AN 4" x 4" x 1/4" x 4"	LIGHT/RECPT.	
		10-09	1	PL C/F (1) 3/8" x 120" x 193"	A.T. PLATE	
		10-10	3	PL C/F (3) 3/8" x 96" x 190"	A.T. PLATE	
		10-11	1	PL C/F (1) 3/8" x 96" x 190"	A.T. PLATE	
		18-05	4	FB 1/4" x 2" x 4'-0" (BEND & ROLL)	CABLE BRACKET	
		11-LA-03	1	ACCESS TUBE LADDER		
10-RA-01	1			ROOF ASSEMBLY		400
		10-04	1	PL 3/8" x 64" DIA.	ROOF PLATE	
		B7-MT-30	1	BY 30" DIA. ACCESS TUBE ROOF MANHOLE	HATCH	
		10-08	3	FB 1/4" x 2 3/8" x 2 3/8"	SPIDER POD LUG	
		10-07	6	BY 4" EX. HVY. x 6" LG.	CABLE SLEEVE	
10-05	6			BY QWIK-CAP FOR 4" PIPE	PIPE CAP	
10-06	2			BY 1" COUPLING w/PLUG	ELEC. SLEEVE	



PEDESTAL PLATES						
PART #	NO.	THK.	HEIGHT	LENGTH	DIAGONAL	WEIGHT
10-09	1	3/8"	9'-11"	15'-7 3/16"	18'-5 13/16"	2,370
10-10	3	3/8"	7'-11"	15'-7 3/16"	17'-5 15/16"	1,895
10-11	1	3/8"	4'-3 1/2"	15'-7 3/16"	16'-2 1/8"	1,025

NOTES:


- LENGTHS SHOWN INCLUDE 1/8" WELD GAP FOR WELD SEAMS (SHOP OR FIELD).

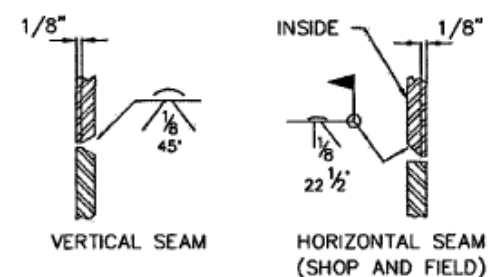

ACCESS TUBE WELD DETAILS

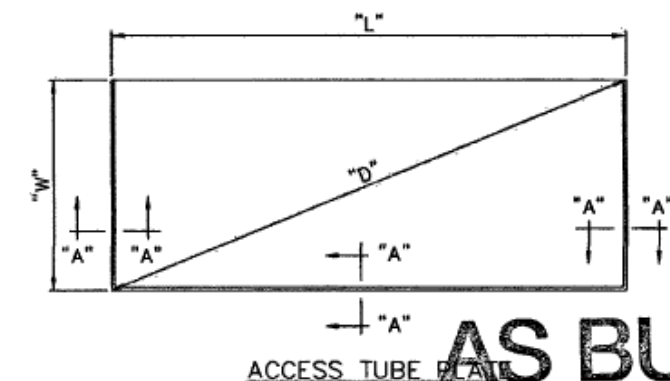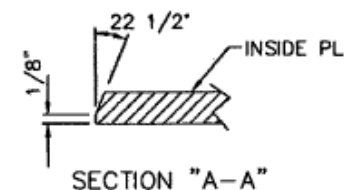

AS BUILT

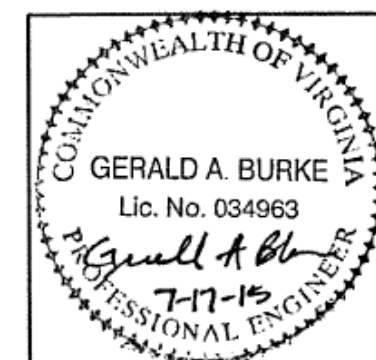

REV.	BY:	DATE	REMARKS
CALDWELL Since 1887 Water • Energy • Industrial ROANOKE, VIRGINIA 250,000 GALLON PEDESHERE			
BY: AMK		TITLE: ACCESS TUBE	
DATE: 07/07/15		DRAWING NO.: E-8344	