

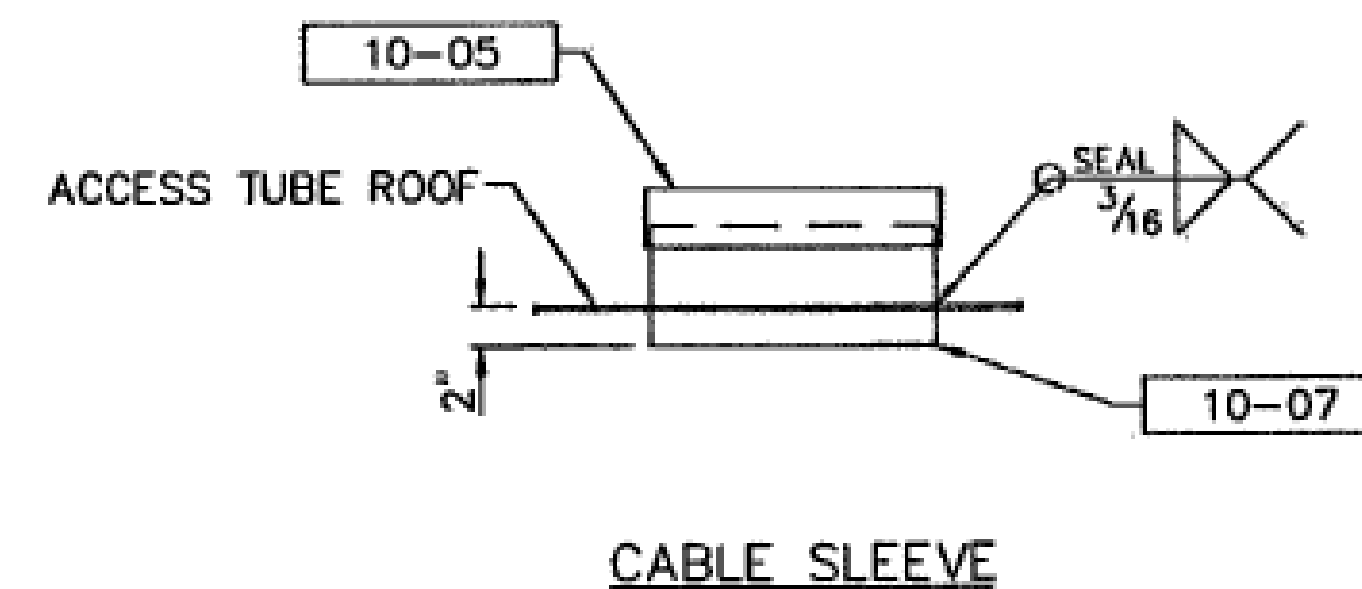
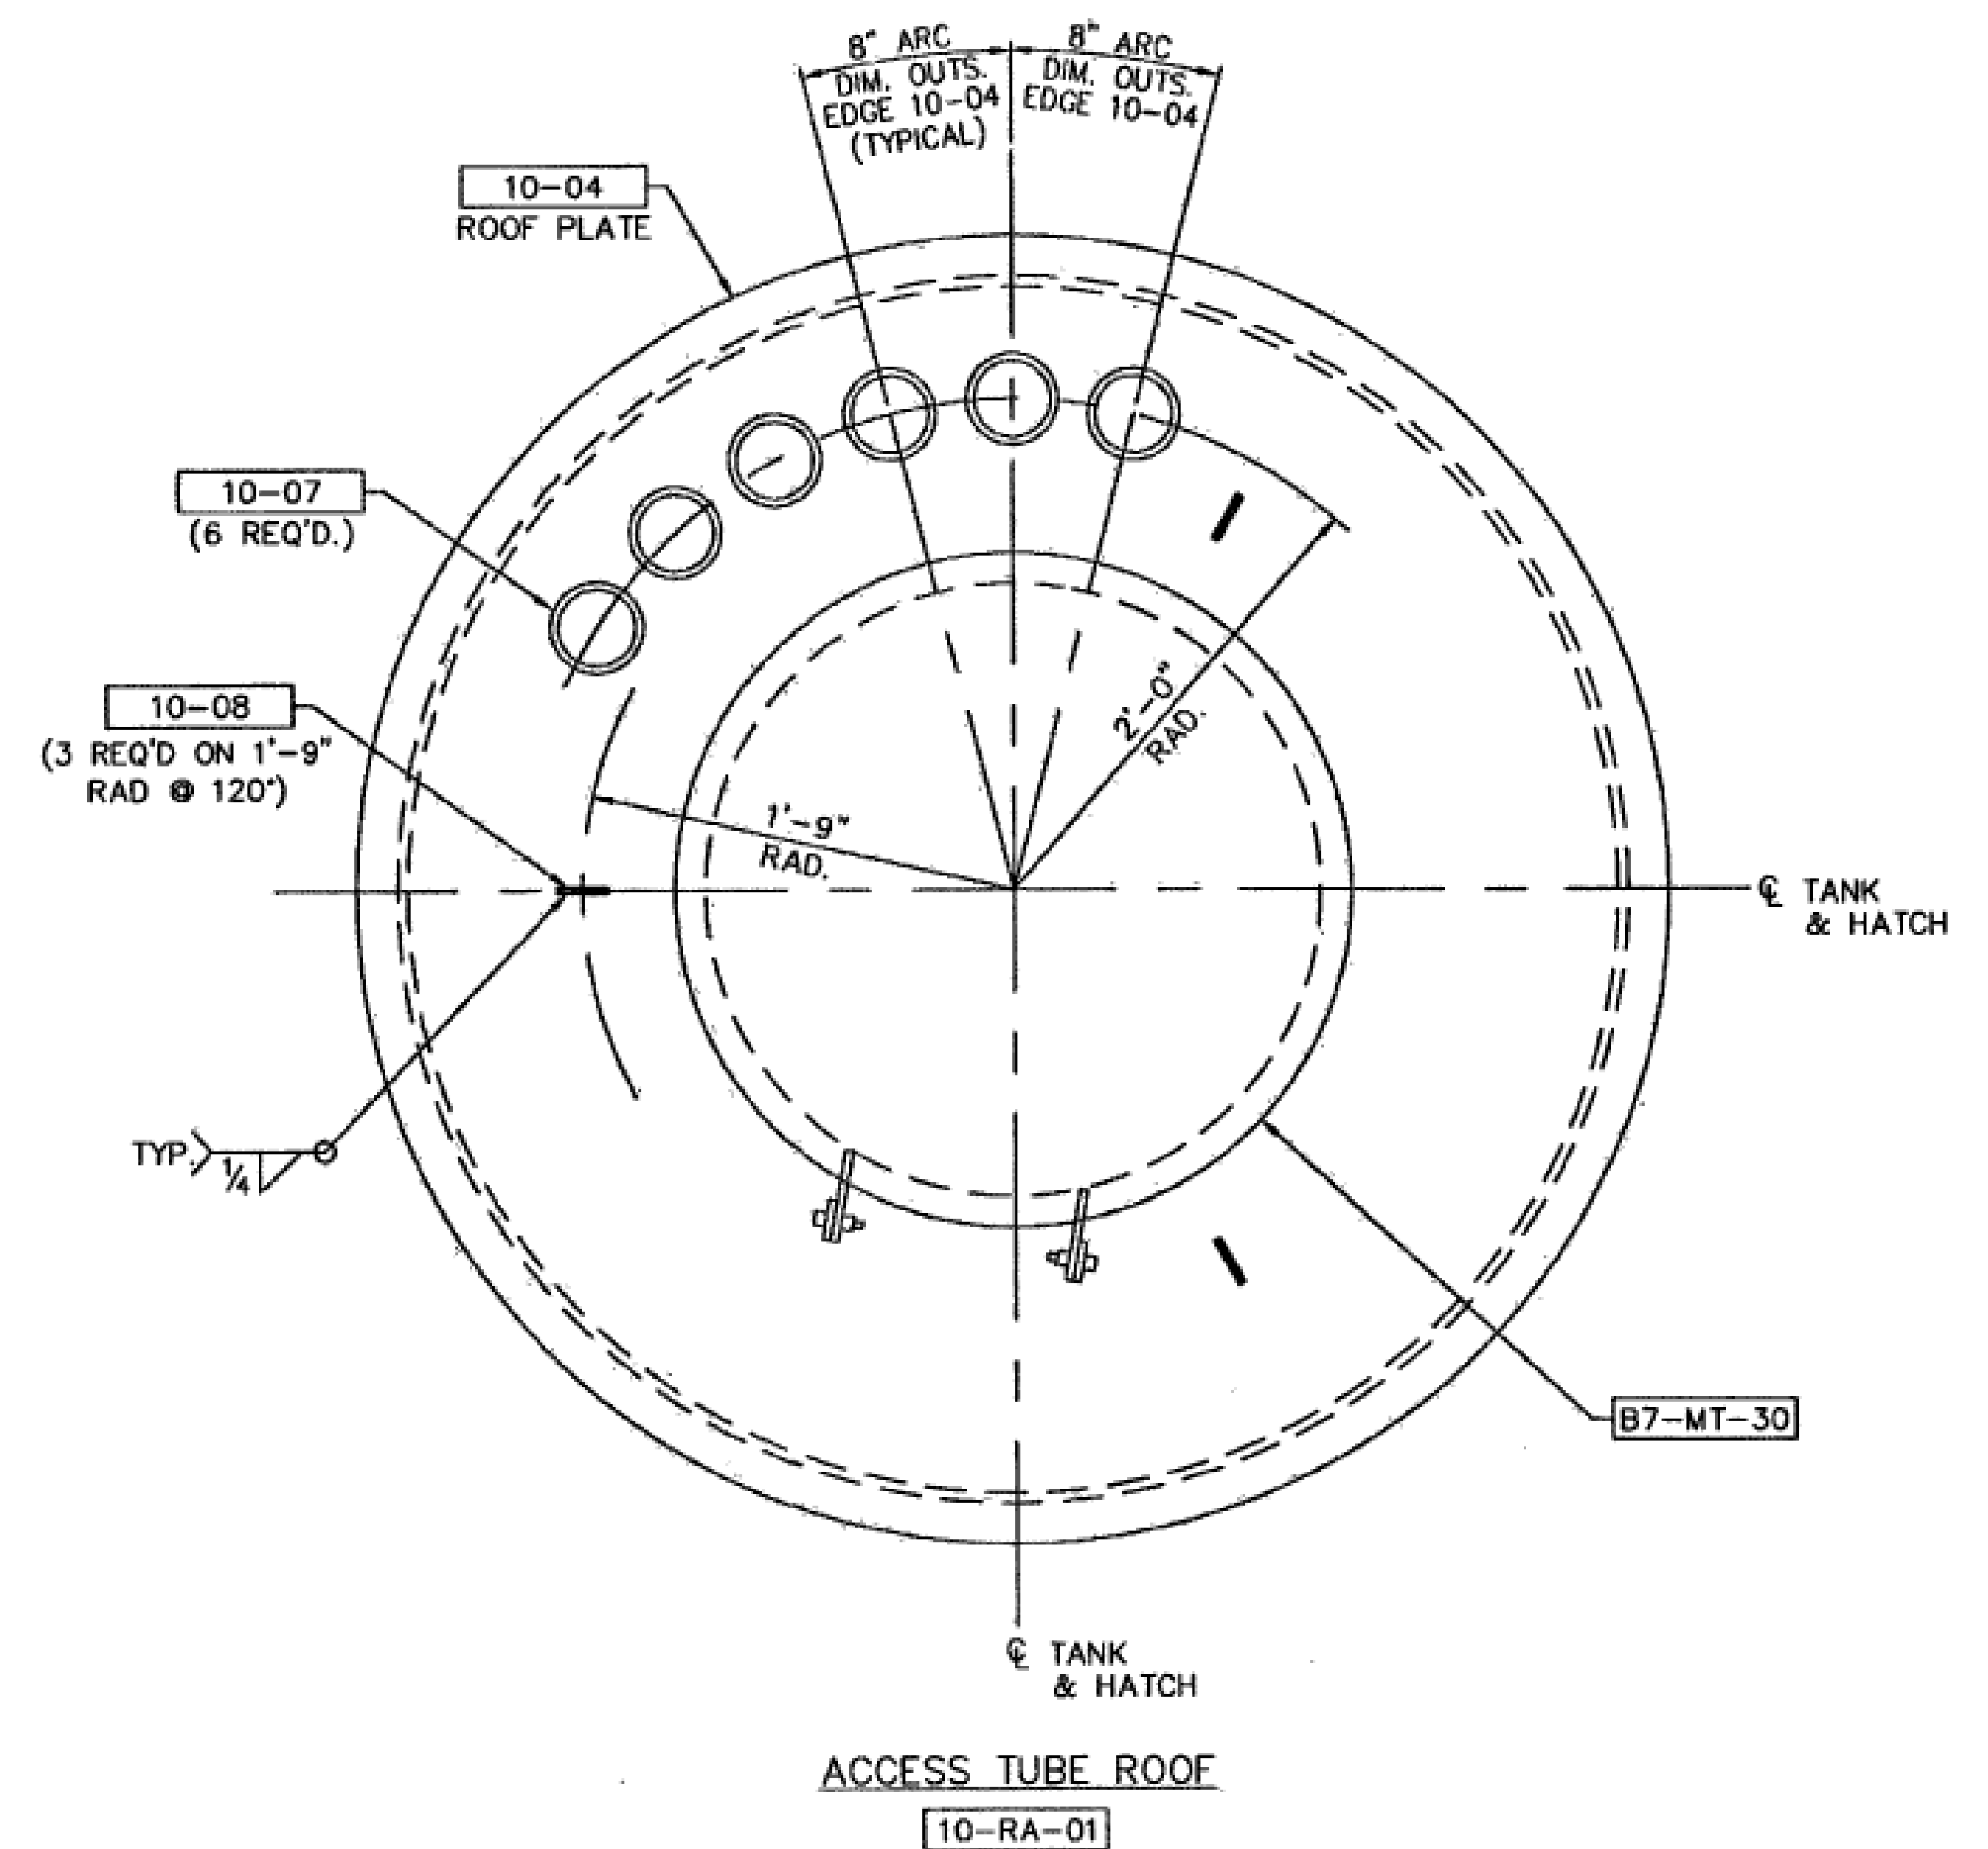


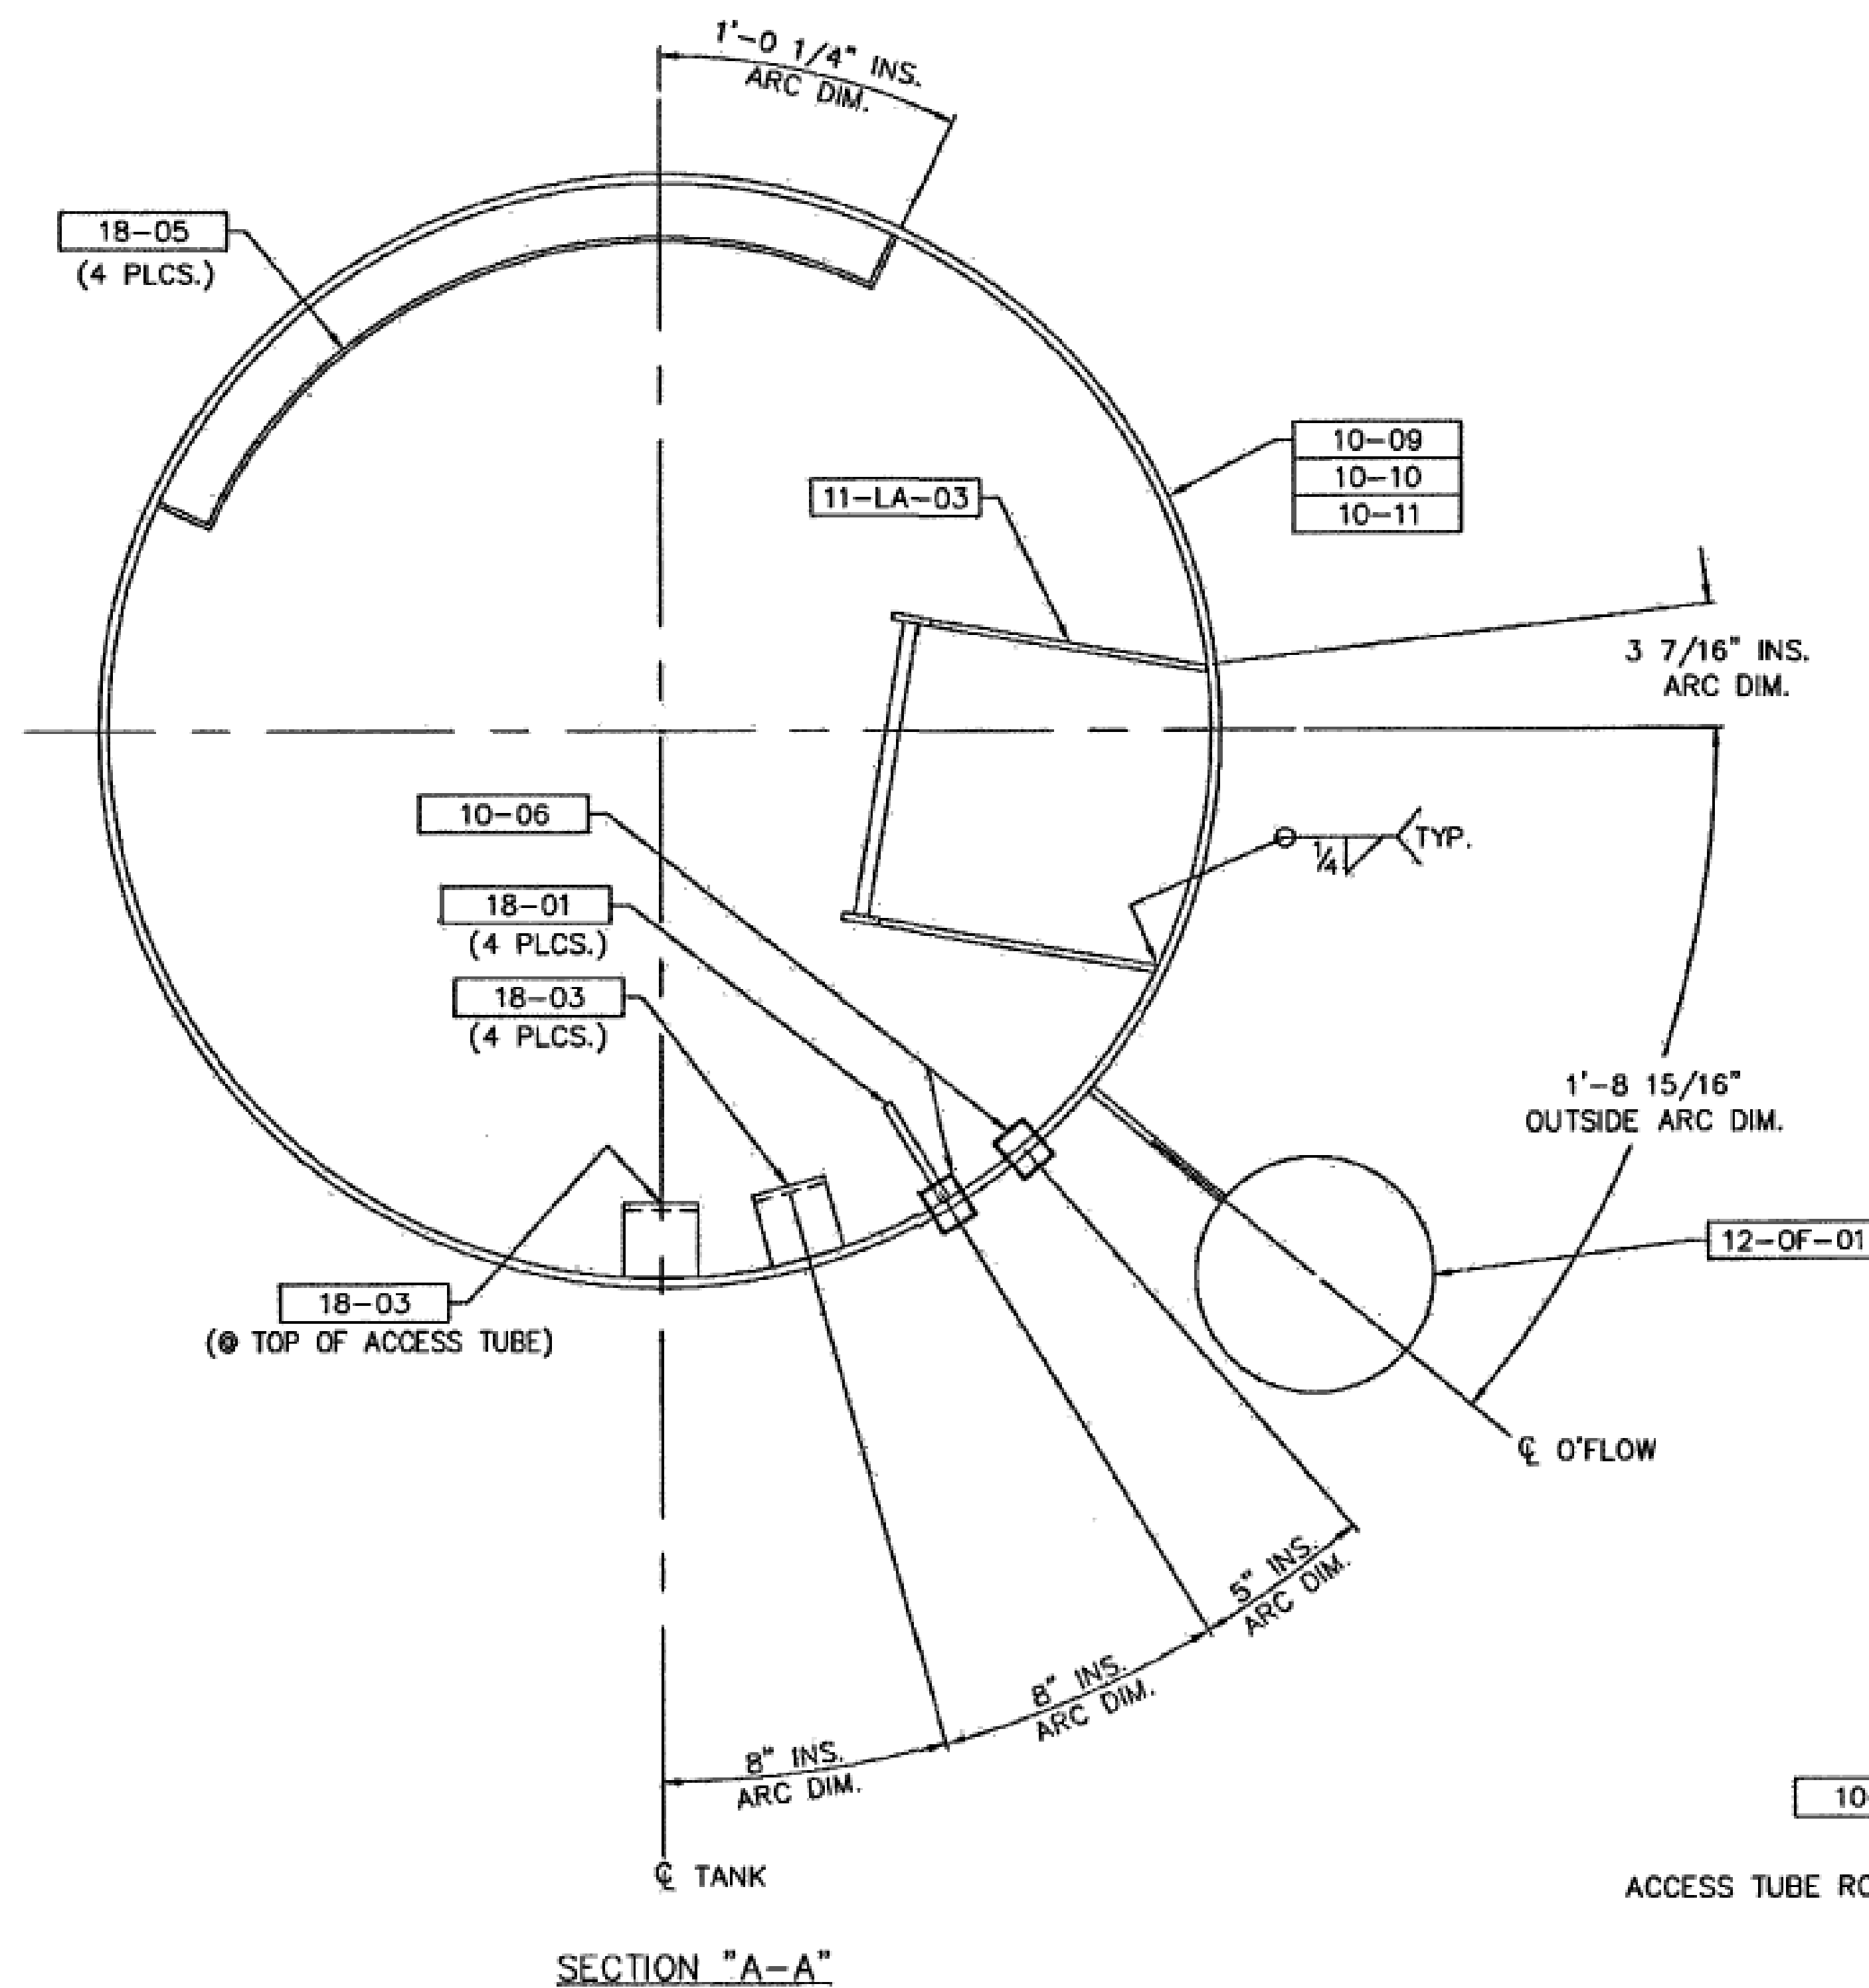

AS BUILT

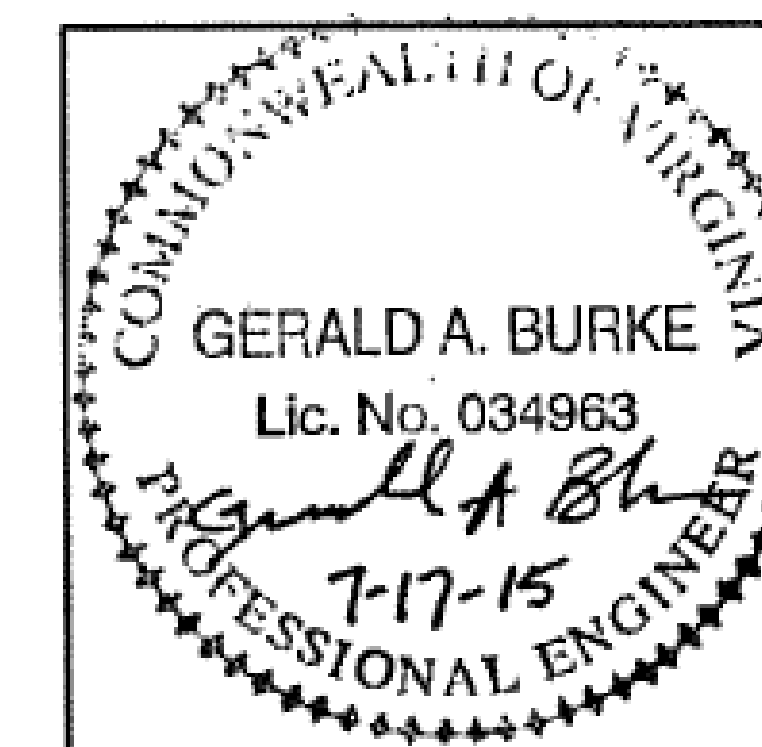

REV.	BY:	DATE	REMARKS
CALDWELL Since 1887 Water - Energy - Industrial			
ROANOKE, VIRGINIA 250,000 GALLON PEDESHERE			
BY: AMK	TITLE: ACCESS TUBE		
DATE: 07/07/15	DRAWING NO.: E-8344 10A		