


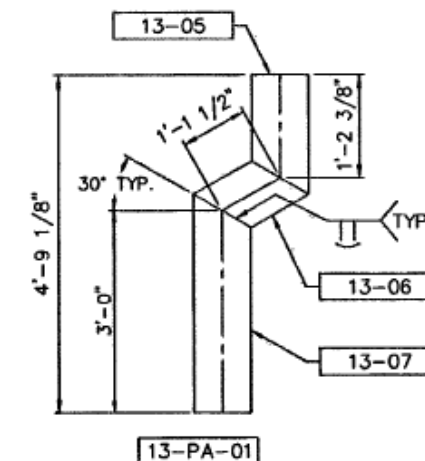

8'-3 1/4"

13/16"

8'-1 5/8"

13/16"

1'-7 1/8"

1'-0 9/16"

1'-5 1/8"

1'-5 1/8"

2'-7 11/16"

5/8" DIA. HOLE (2)

6 7/8"

6 7/8"

8"

8"

6 7/8"

6 7/8"

2 9/16"

2 9/16"

18-02

3 1/2" N

11-06

1" DIA. HOLE (4)


2 1/2"

CL 4" DRAIN

CL 12" O'FLOW

CL LADDER & BRACE


CL 12" INLET

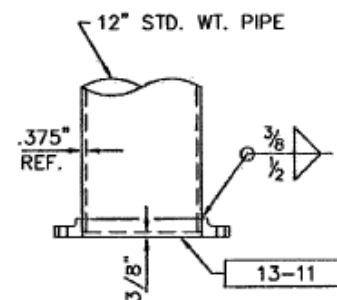

S.O. FLANGE WELD DETAIL
12" STD. WT. PIPE

SHIPPING ITEM	QTY.	PC. MK.	QTY.	MATERIAL REQ'D	DESCRIPTION	UNIT WT.
13-PA-01	1	(w/06-PA-10)		TANK ENTRY SECTION (OVERFLOW)		290
		13-05	1	PI 12" STD. WT. x 1'-2 3/8" LG.	PIPE	
		13-06	1	PI 12" EX. HVY x 1'-1 1/2" LG.	PIPE	
		13-07	1	PI 12" STD. WT. x 3'-0" LG.	PIPE	
13-FG-01	1			INLET LINE ASSEMBLY		260
		13-10	1	PI 12" STD. WT. x 4'-0" LG.	INLET	
		13-11	1	BY 150# S.O. FLANGE FOR 12" PIPE	FLANGE	
13-01	1			PI 12" STD. WT. x 76'-0" LG.	INLET	3,770
13-03	1			BY 12" DIA. w/S.S. BELLWS	EXP. JOINT	
13-04	5			BY 7/8" DIA. FOR 12" PIPE	STD. U-BOLT	
13-09	5	(w/PEDESTAL)		CH C5 x 6.7# x 8'-3 1/4"	BRACE	55
13-11	1			BY 150# S.O. FLANGE FOR 12" PIPE	FLANGE	
13-12	12			BY 7/8" DIA. x 4" LG. (ZINC PL)	MACHINE BOLTS	
13-13	1			BY 1/4" THK. RED RUBBER FOR 12" PIPE	GASKET	

AS BUILT

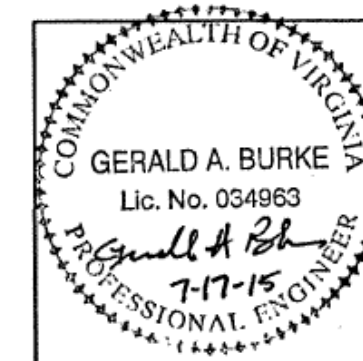

REV.	BY:	DATE	REMARKS
 ROANOKE, VIRGINIA 250,000 GALLON PEDESHERE			
BY: AMK		TITLE: INLET PIPING DETAILS	
DATE: 07/07/15		DRAWING NO.: E-8344	