


SHIPPING ITEM	QTY.	PC. MK.	QTY.	MATERIAL REQ'D	DESCRIPTION	UNIT WT.
16-NA-01	1	(w/03-BD-01)		NAMEPLATE ASS'Y		
		16-01	1	BY CAST ALUMINUM	NAME PLATE	
		16-02	2	AN 1" x 1" x 1/8" x 5" LG.	MOUNTING ANGLE	
		16-03	4	BY #8 x 5/8" LG.	DRIVE SCREW	

CALDWELL TANKS INC
LOUISVILLE , KENTUCKY

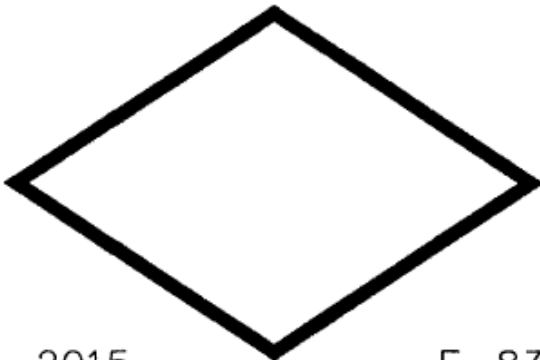

DATE: 2015 E-8344
CAPACITY 250,000 GALS.
BOTTOM HEIGHT 90 FT. 0 IN.
OVERFLOW HEIGHT 121 FT. 0 IN.


16-01

NAMEPLATE ASSEMBLY

16-NA-01

SHOP INSTALL ON BOTTOM BASE CONE
SECTION USING MOUNTING ANGLES 16-02

AS BUILT

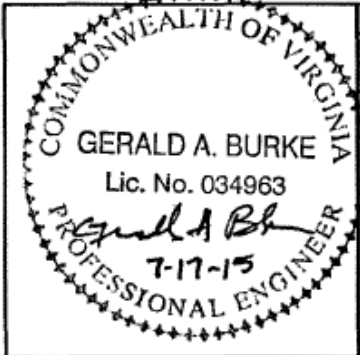

REV.	BY:	DATE	REMARKS
CALDWELL Since 1887 Water - Energy - Industrial			
ROANOKE, VIRGINIA 250,000 GALLON PEDESHERE			
BY: AMK	TITLE: NAMEPLATE		
DATE: 07/07/15	DRAWING NO.: E-8344 16		