

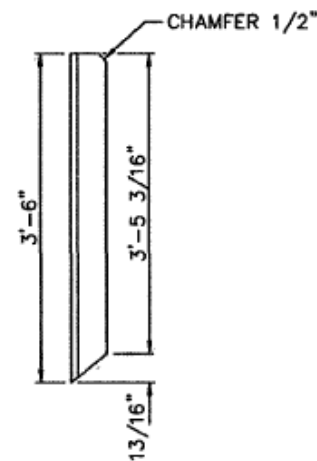


19-10

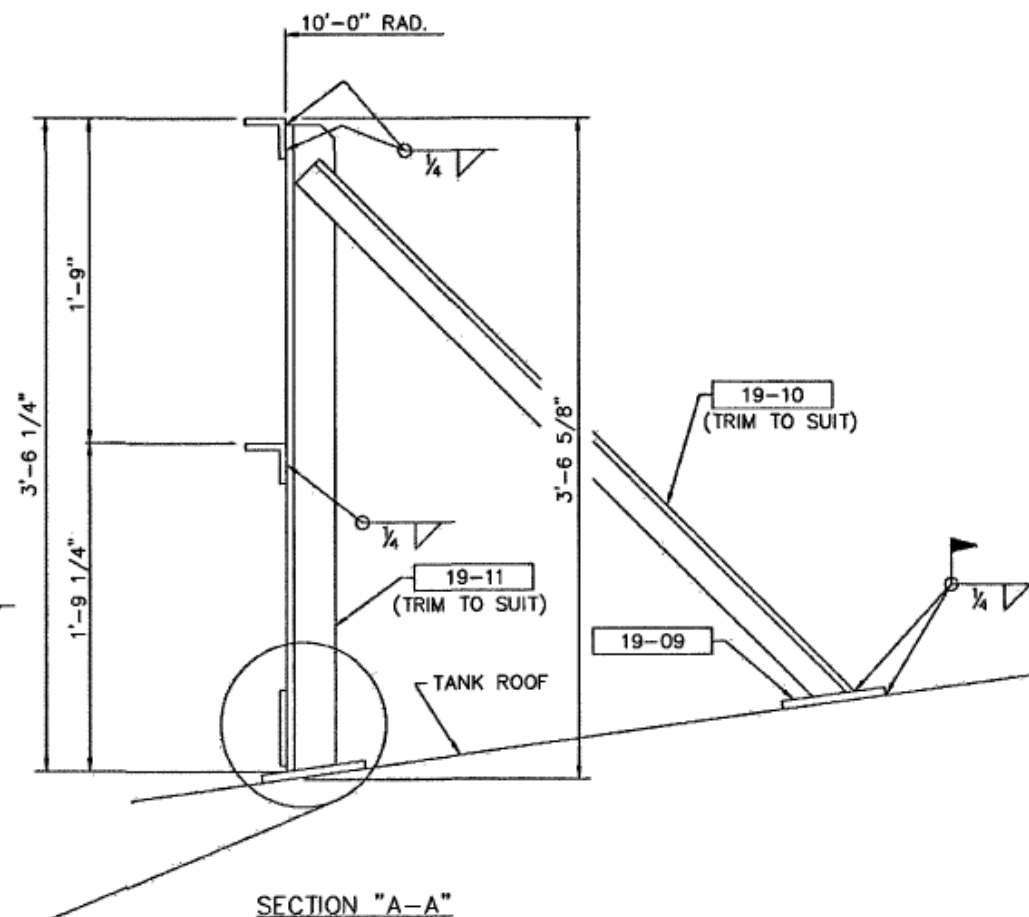


19-11

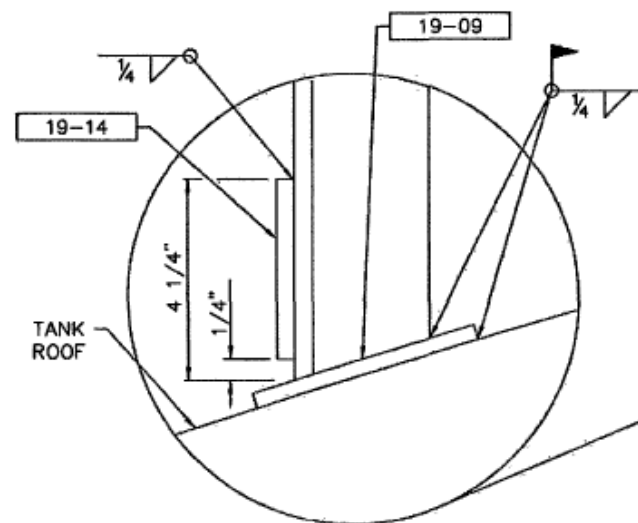


SECTION "A-A"

SHIPPING ITEM	QTY.	PC. MK.	QTY.	MATERIAL REQ'D	DESCRIPTION	UNIT WT.
19-RR-01	4			ROOF RAILING SEGMENT		290
		19-11	3	AN 3" x 3" x 3/8" x 3'-6" LG.	RAILING POST	
		19-12	2	AN 3" x 3" x 1/4" x 15'-9" LG.	TOP RAIL & MID RAIL	
		19-14	1	FB 1/4" x 4" x 15'-9" LG.	TOE PLATE	
19-06	1			BY 1" DIA. STD. WT.	COUPLING	
19-09	18			PL 3/8" x 6" DIA.	PLATE	
19-10	6			AN 2 1/2" x 2 1/2" x 1/4" x 3'-10" LG.	ANGLE	15

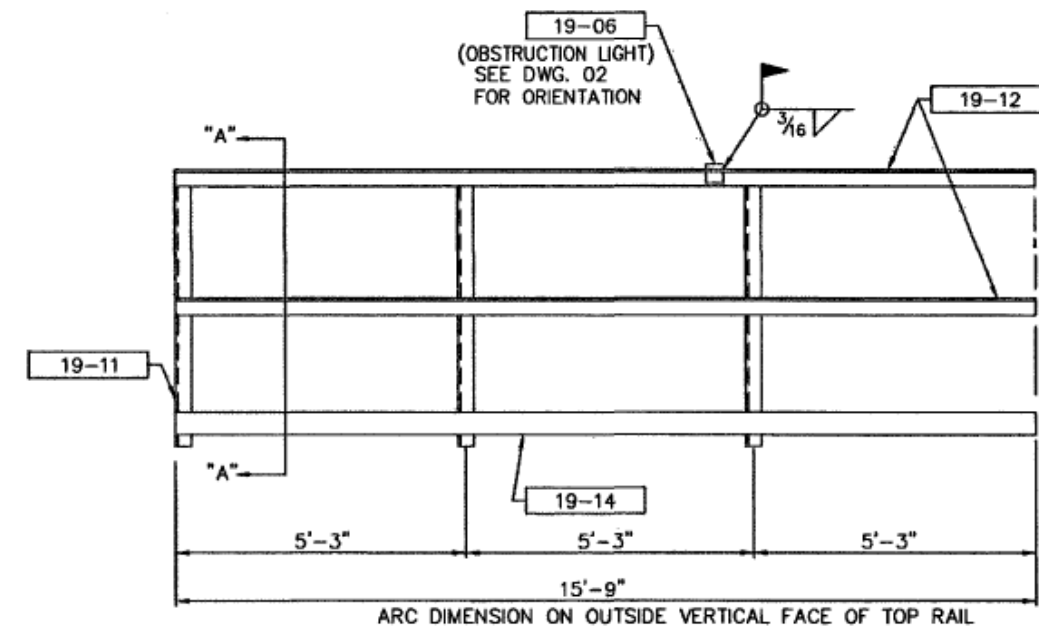

ROOF RAILING SEGMENT

AS BUILT

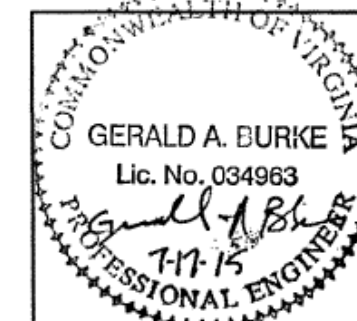

REV.	BY:	DATE	REMARKS
CALDWELL Since 1887 Water - Energy - Industrial			
ROANOKE, VIRGINIA 250,000 GALLON PEDESHERE			
BY: AMK	TITLE: ROOF RAILING & ANTENNA SUPPORTS		
DATE: 07/07/15	DRAWING NO.: E-8344 19		